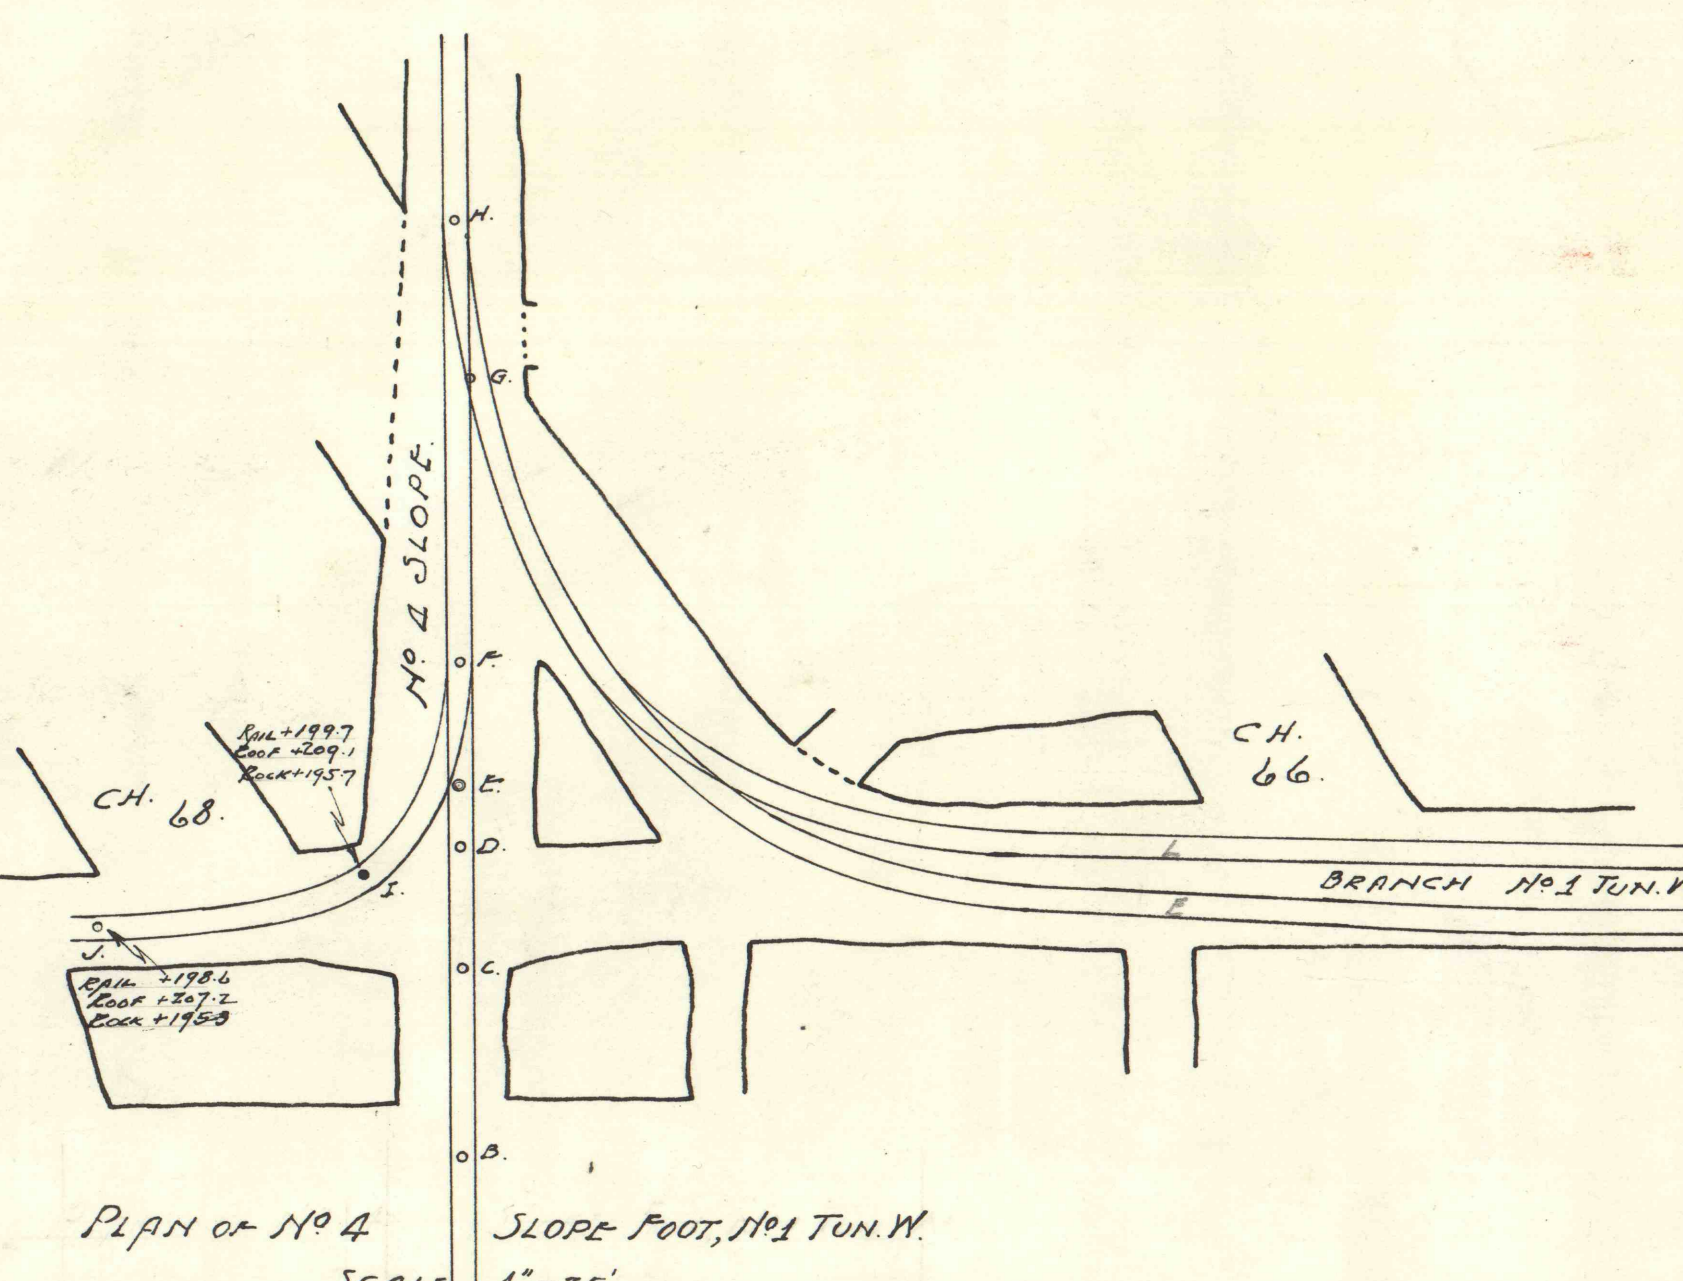
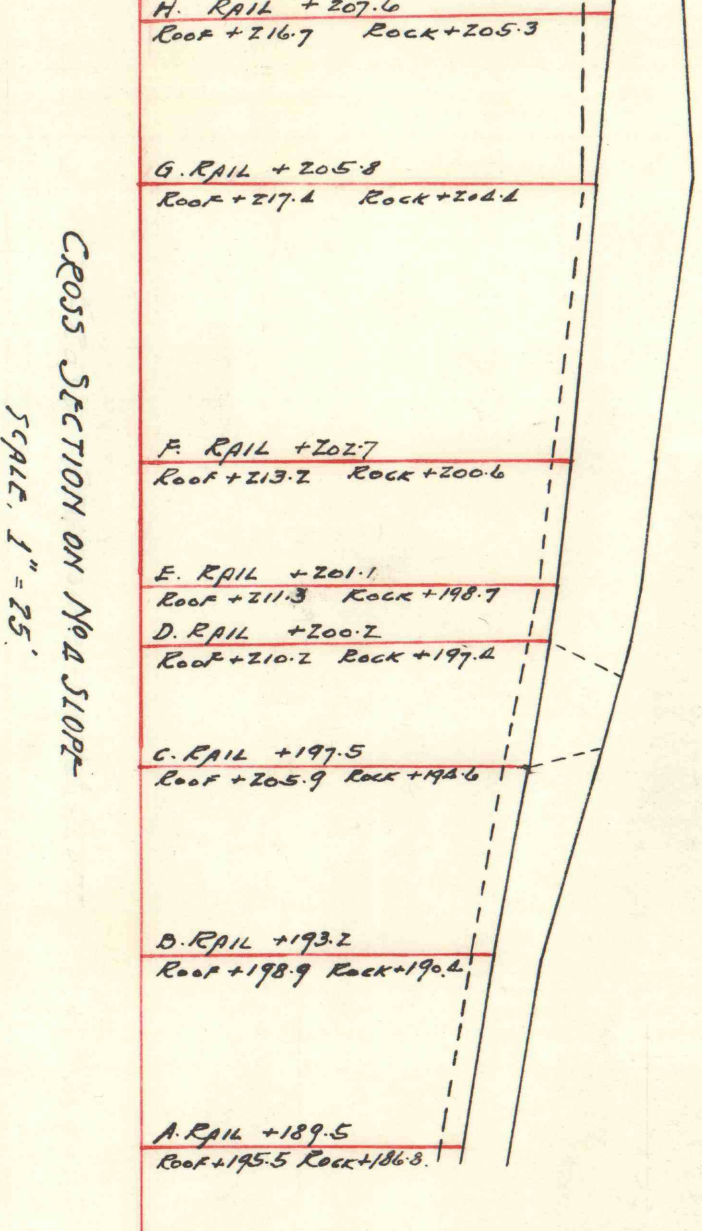
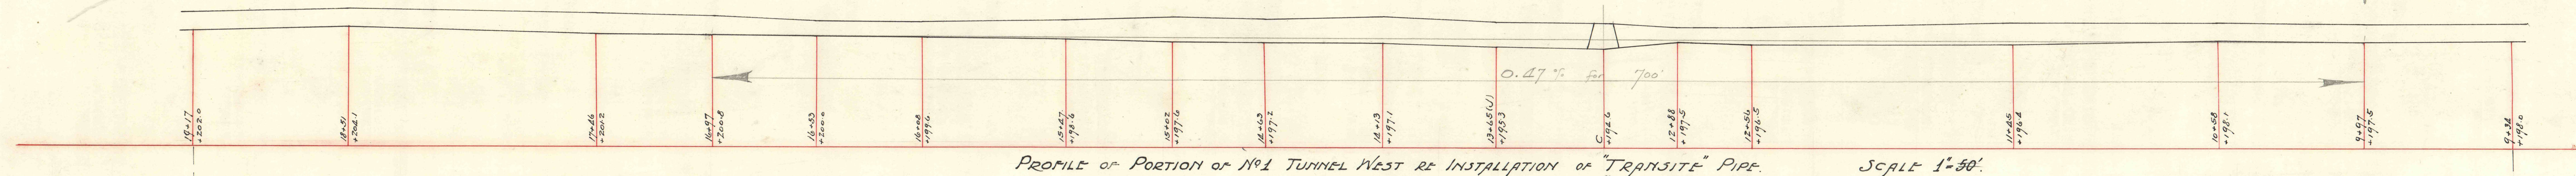


NOTTINGHAM COLLIERY
Bot. ROSS VEIN
PLAN & PROFILE OF PORTION
OF No. 1 TUNNEL WEST.
SCALE { PLAN 1"=100'
PROFILE 1"=50'