




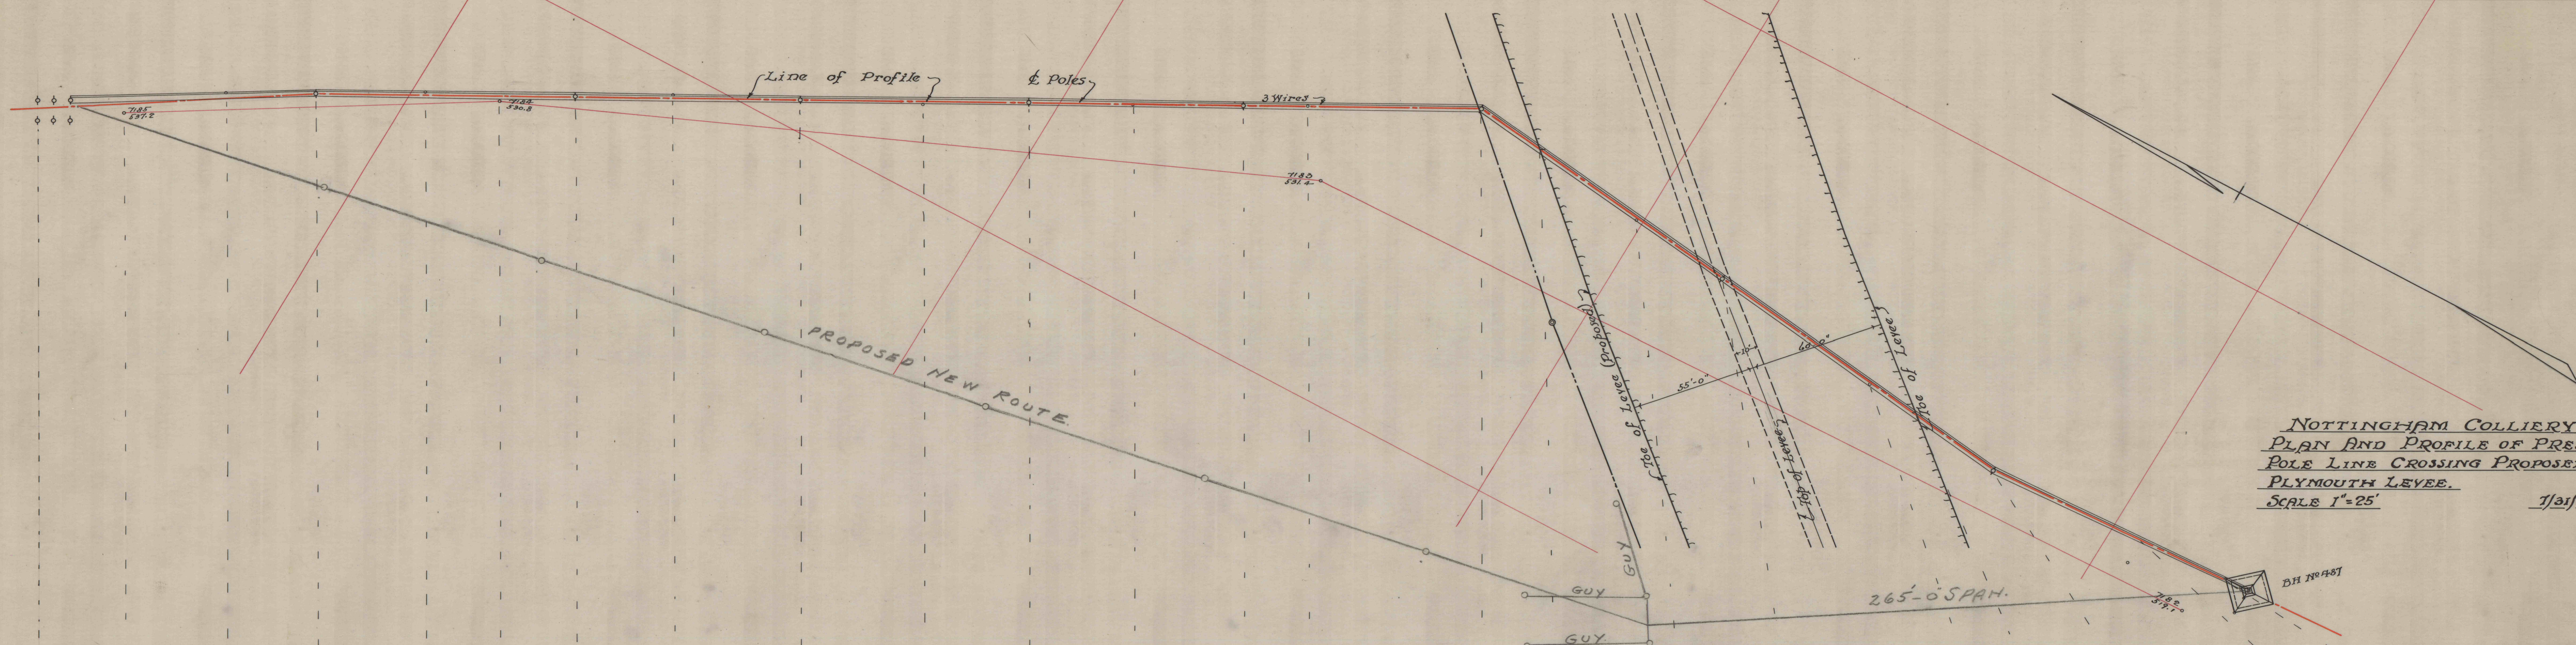

NOTTINGHAM COLLIERY
PLAN AND PROFILE OF PRESENT
POLE LINE CROSSING PROPOSED
PLYMOUTH LEVEE.
SCALE 1"=25'

1/31/40

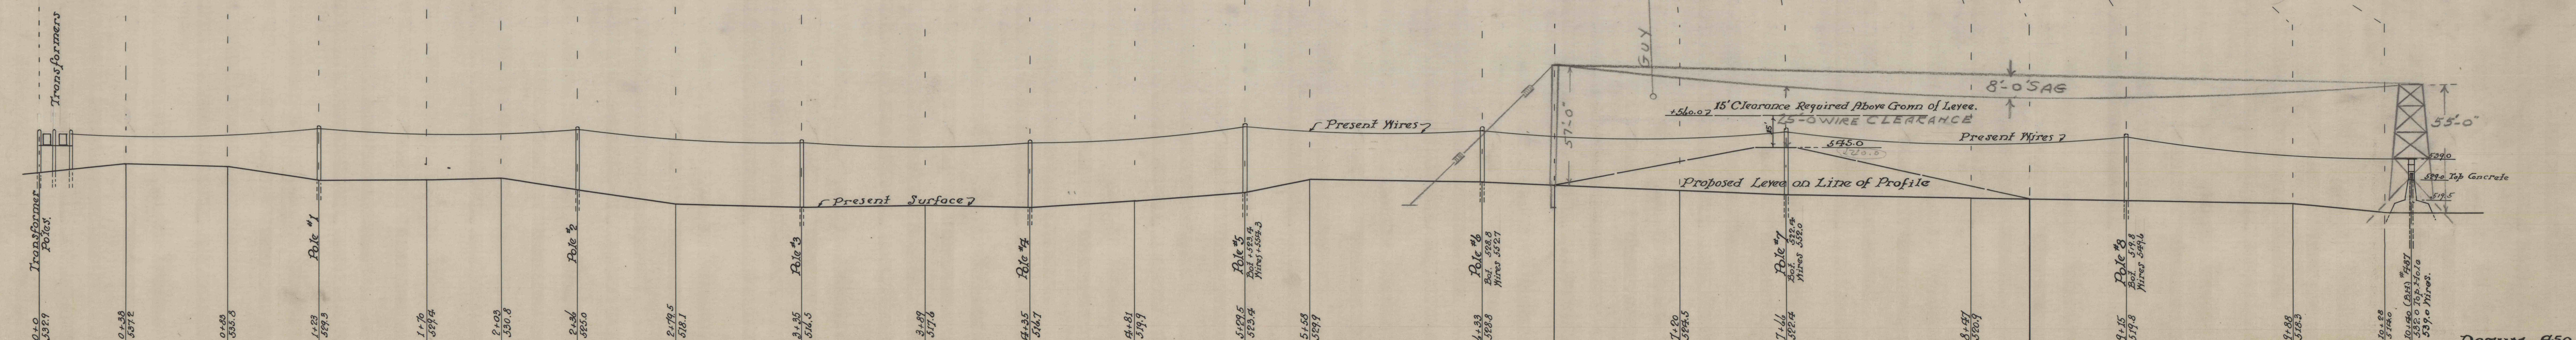

PROFILE ON & OF PRESENT POLE LINE CROSSING PROPOSED LEVEE

SCALE 1"=25'

DATUM 450.0'