
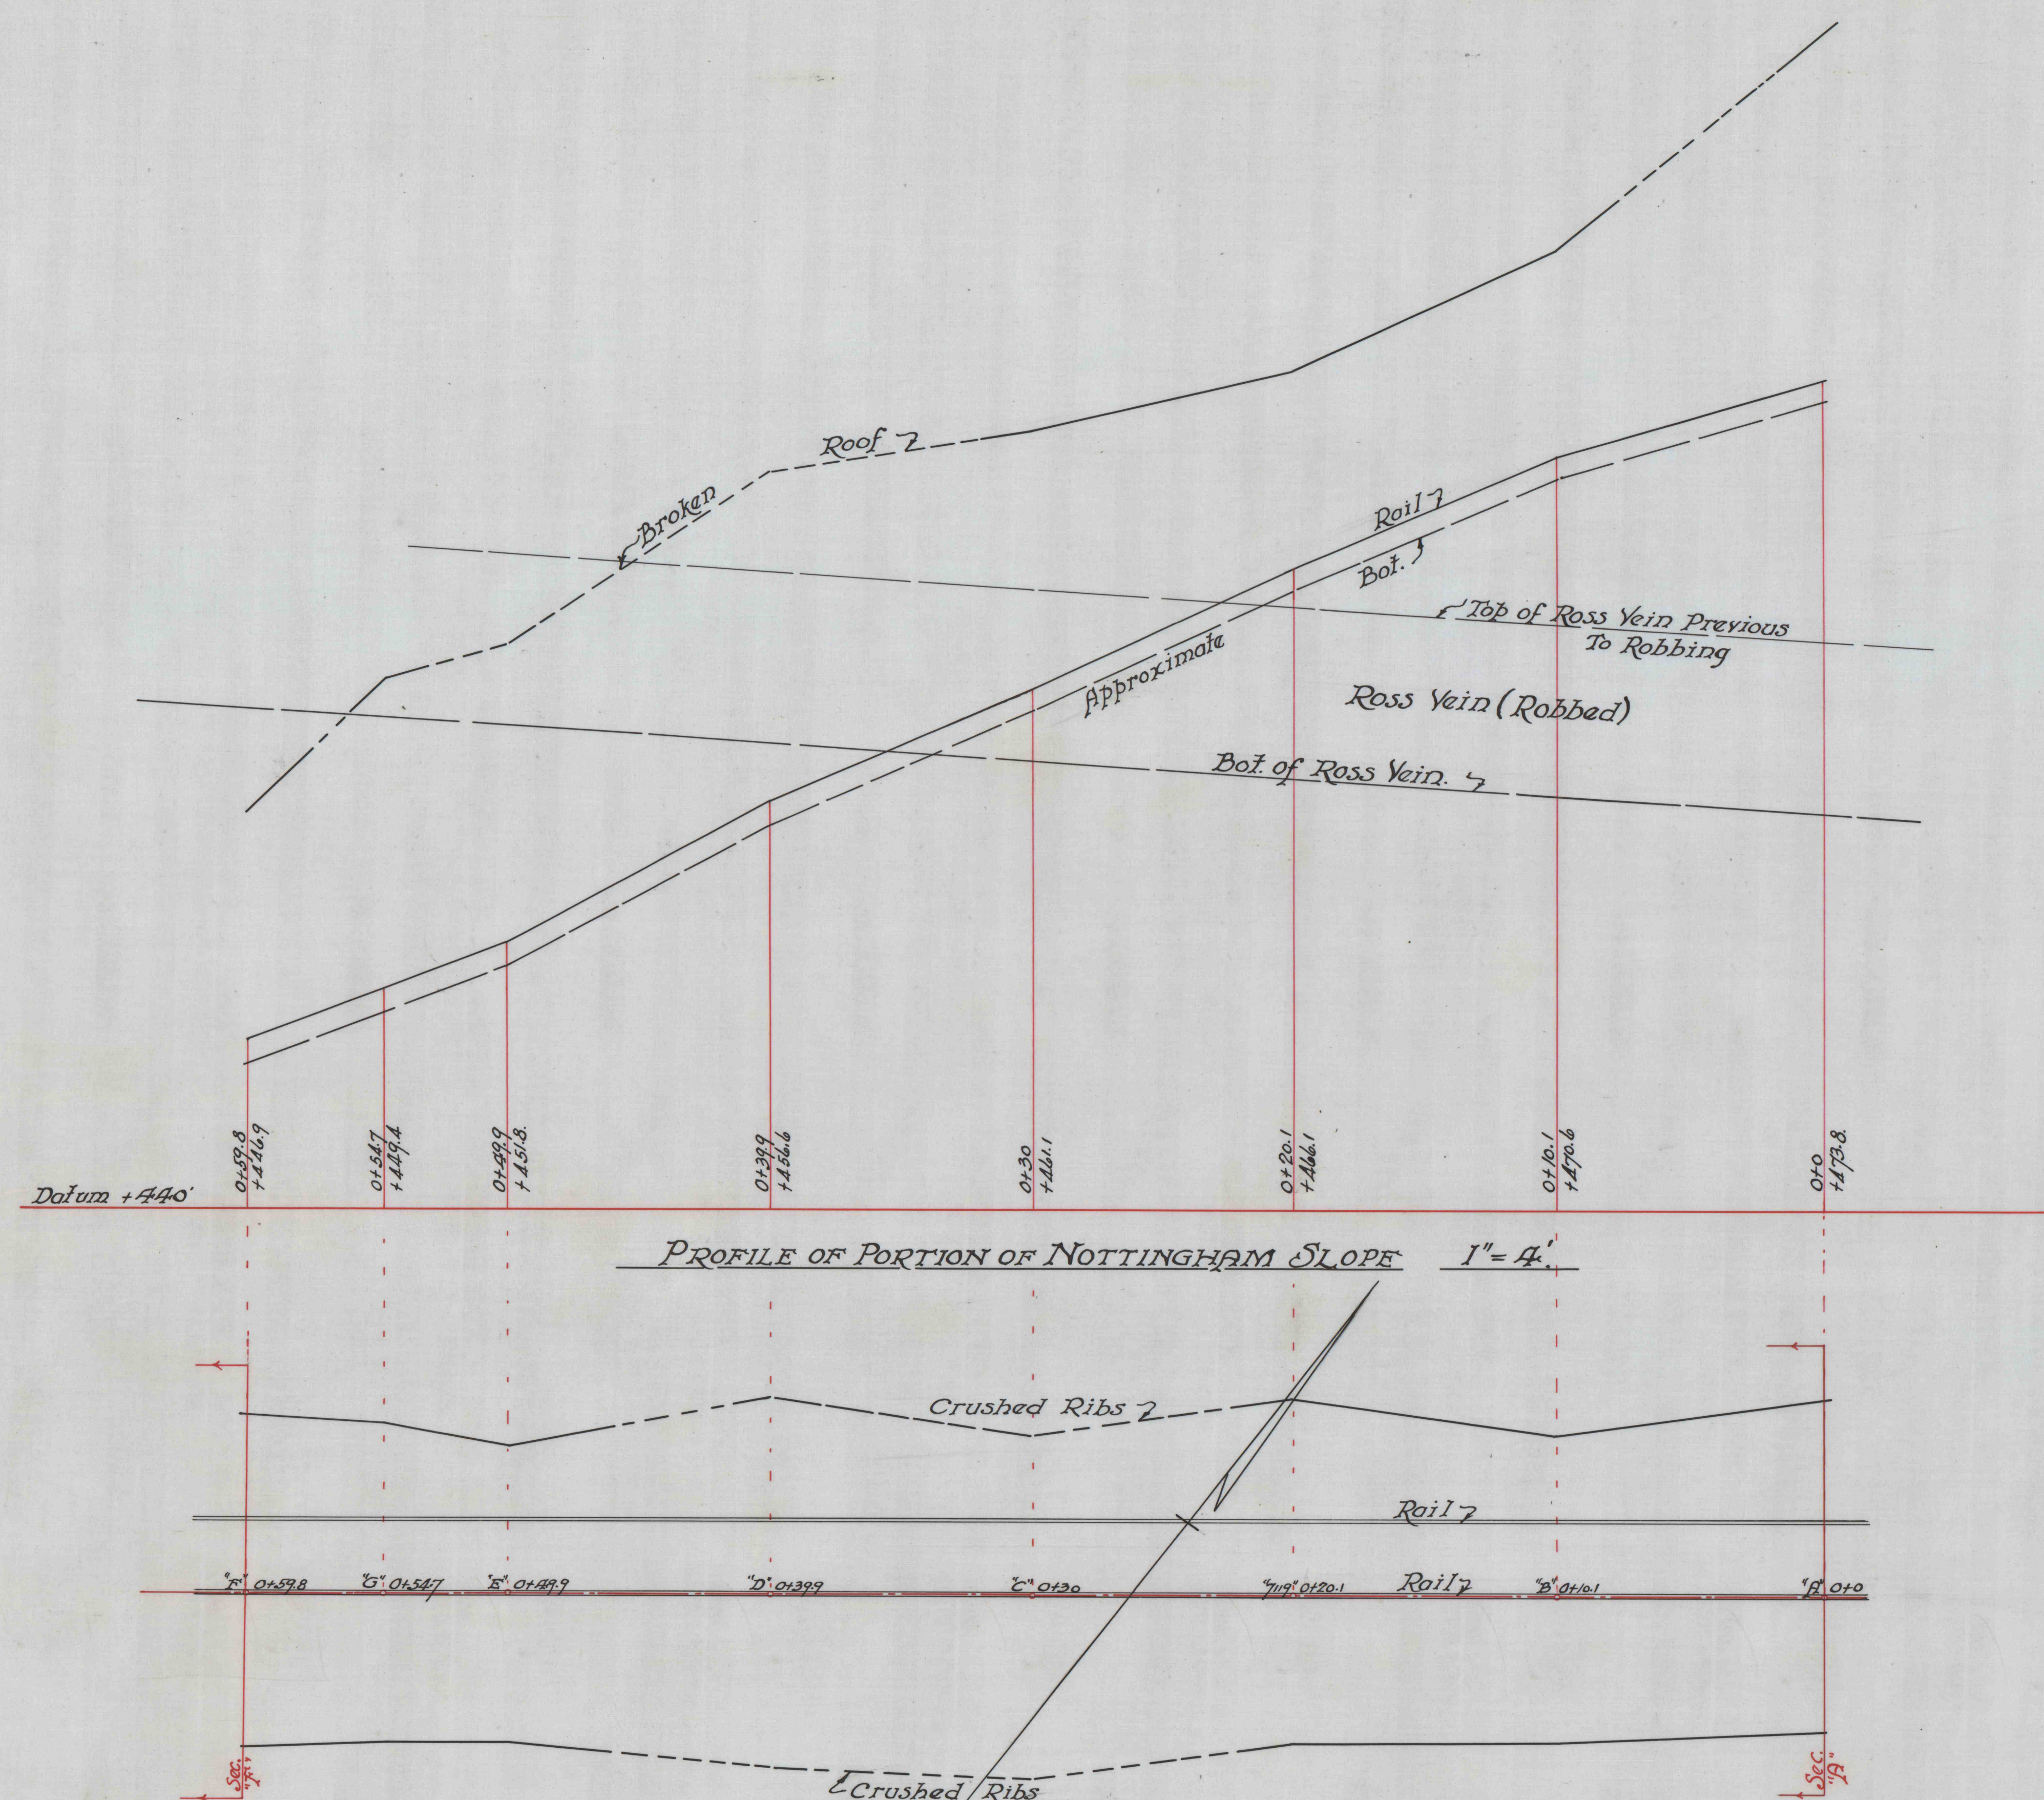
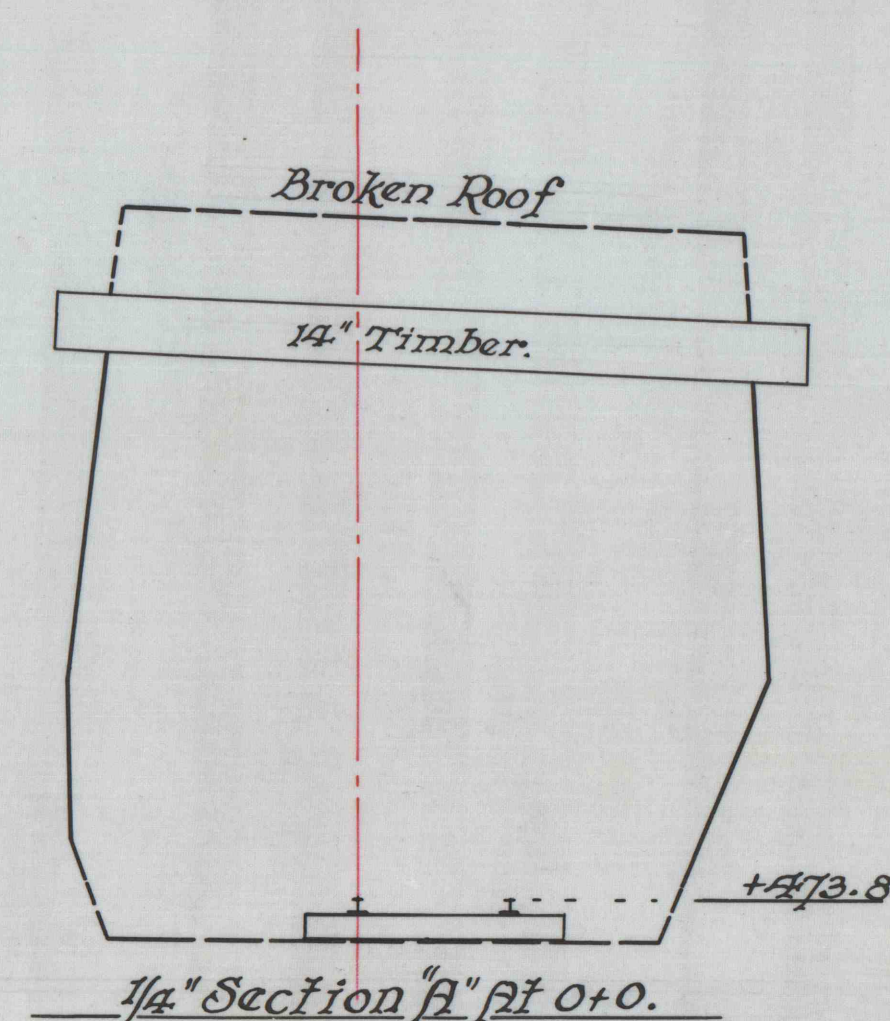
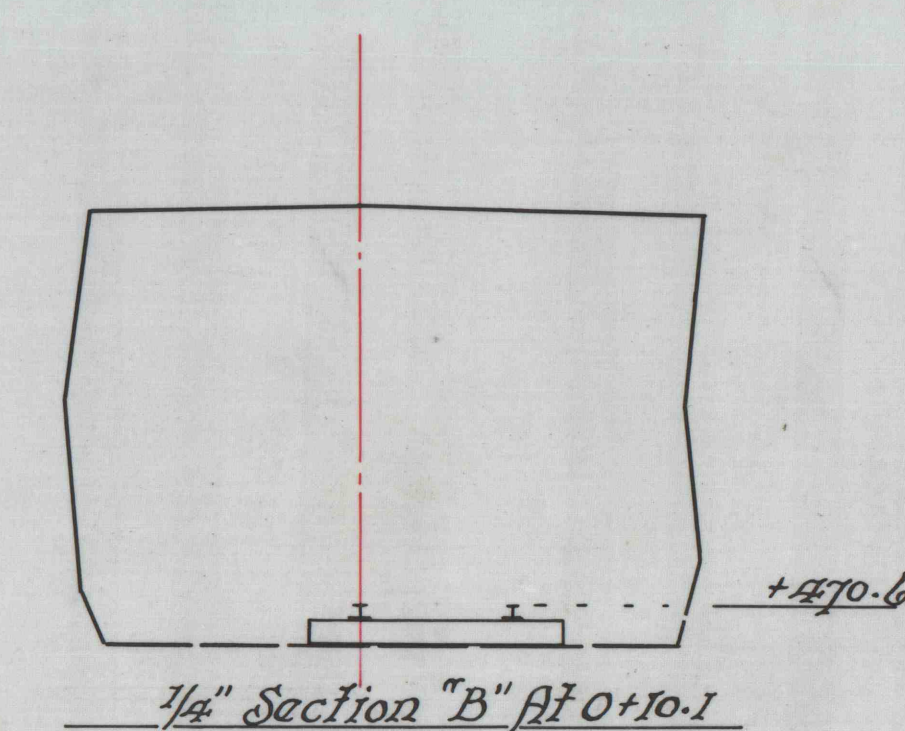
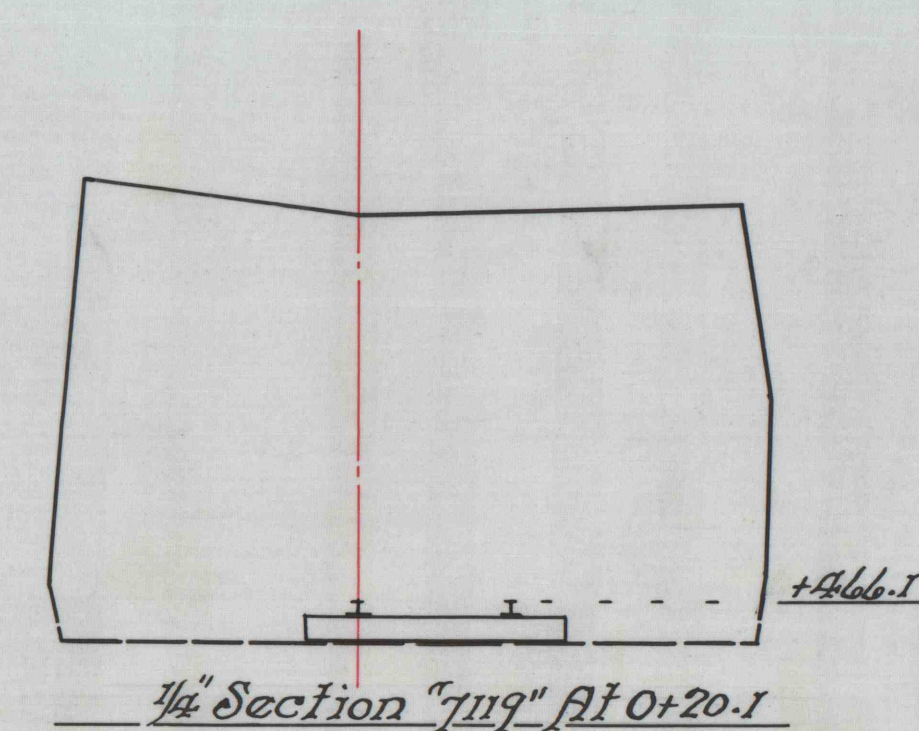
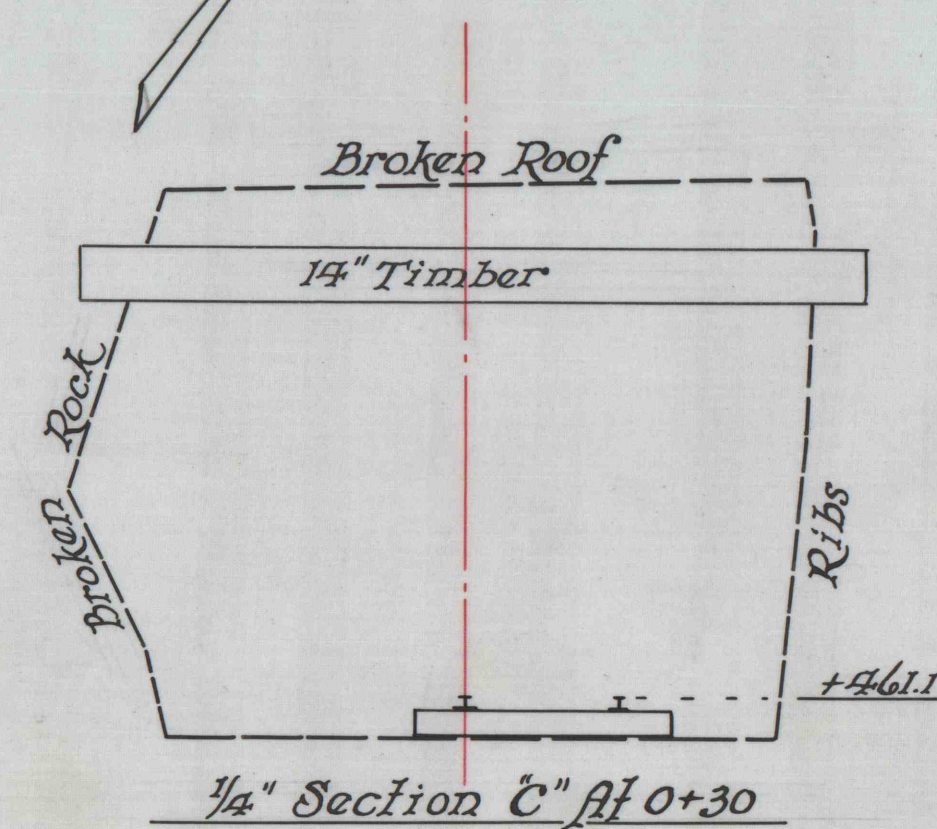
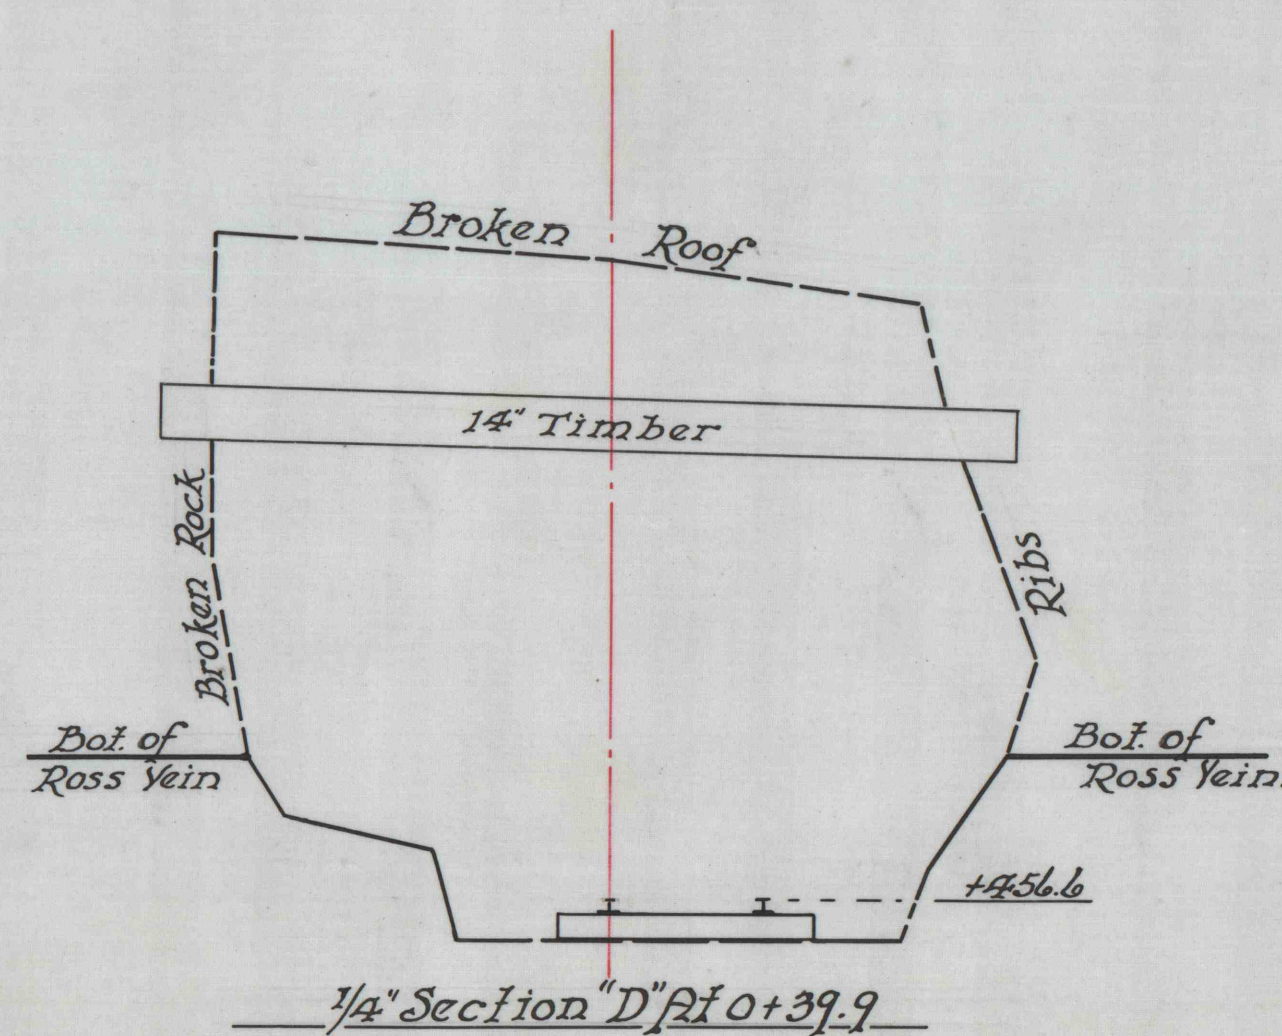
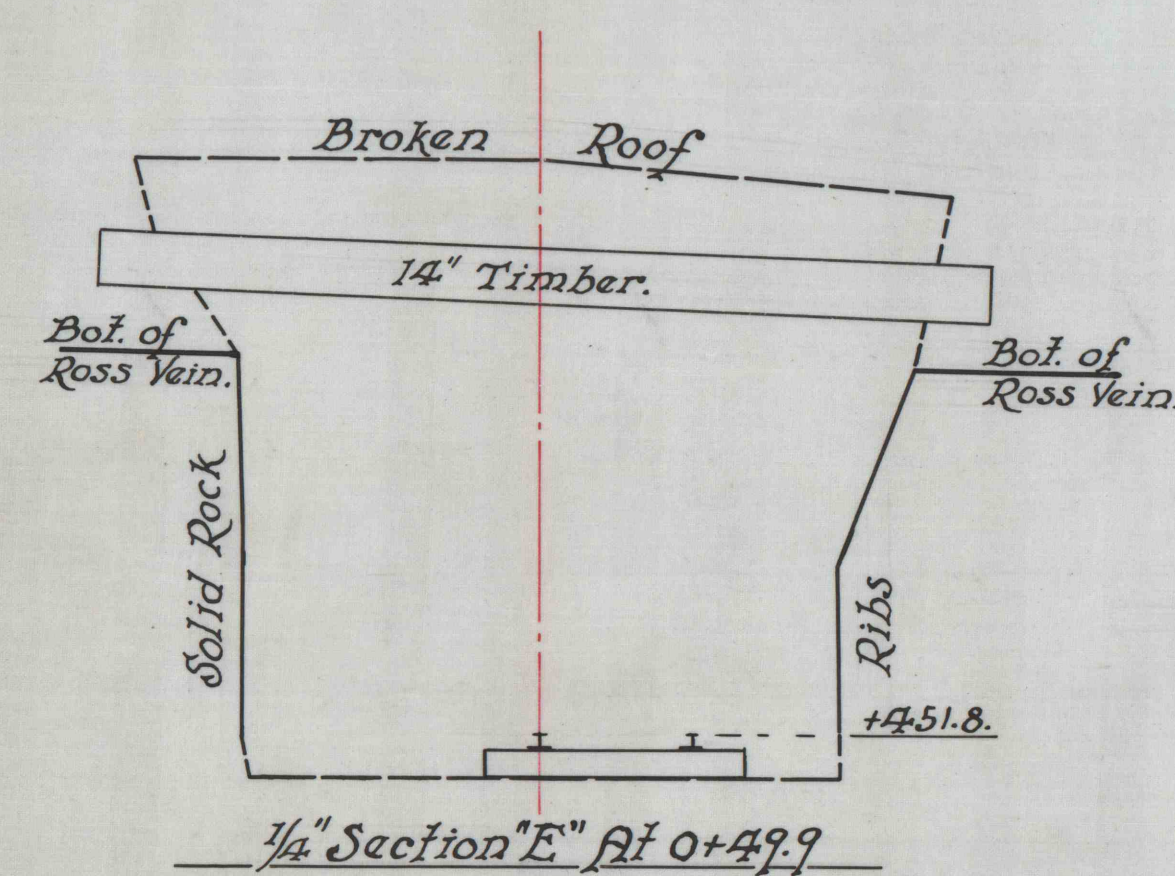
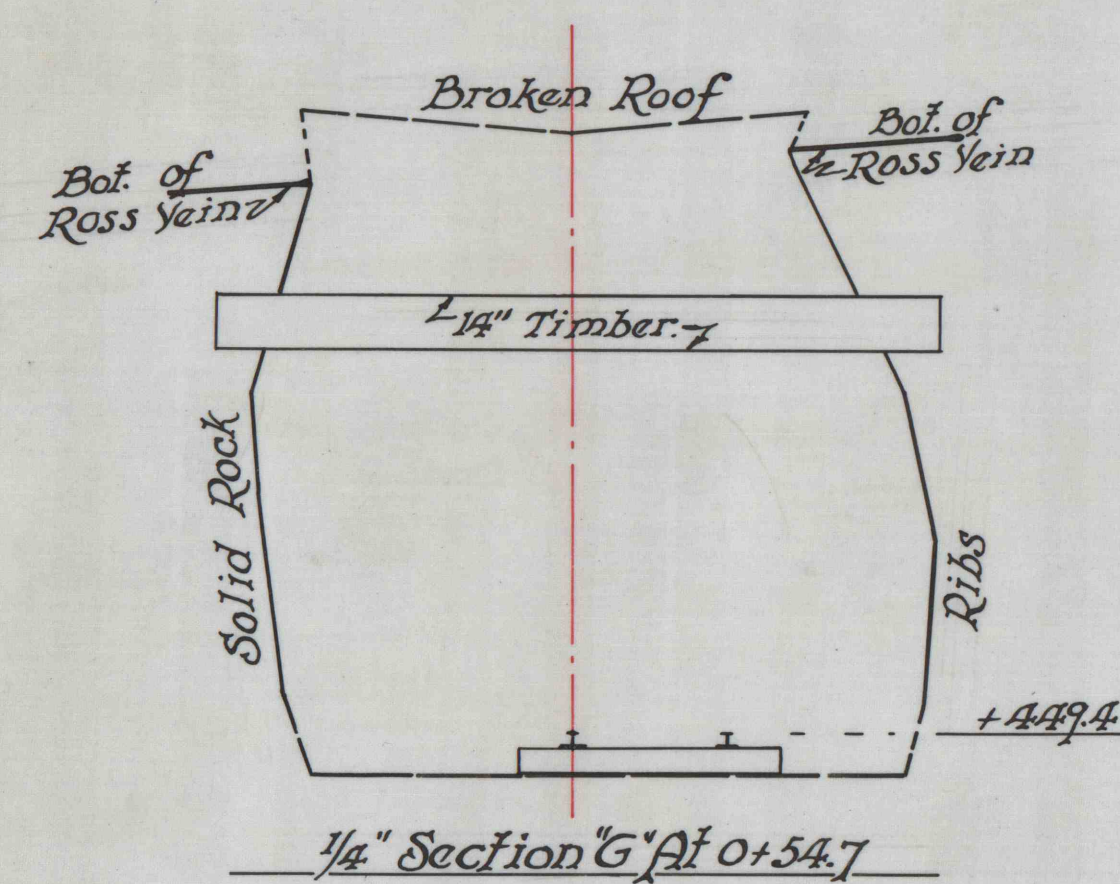


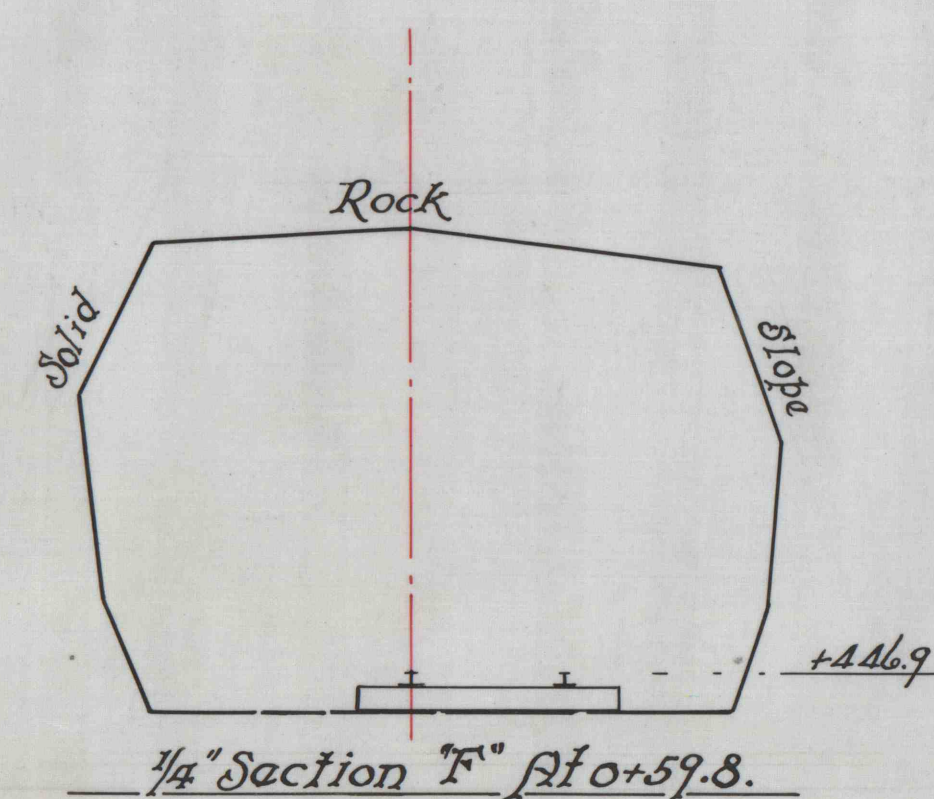

NOTTINGHAM COLLIERY
 PLAN, PROFILE & SECTIONS OF
 PORTION OF NEW SLOPE TO RED
 ASH VEIN.
 SCALE 1"=4' MARCH 1938.