


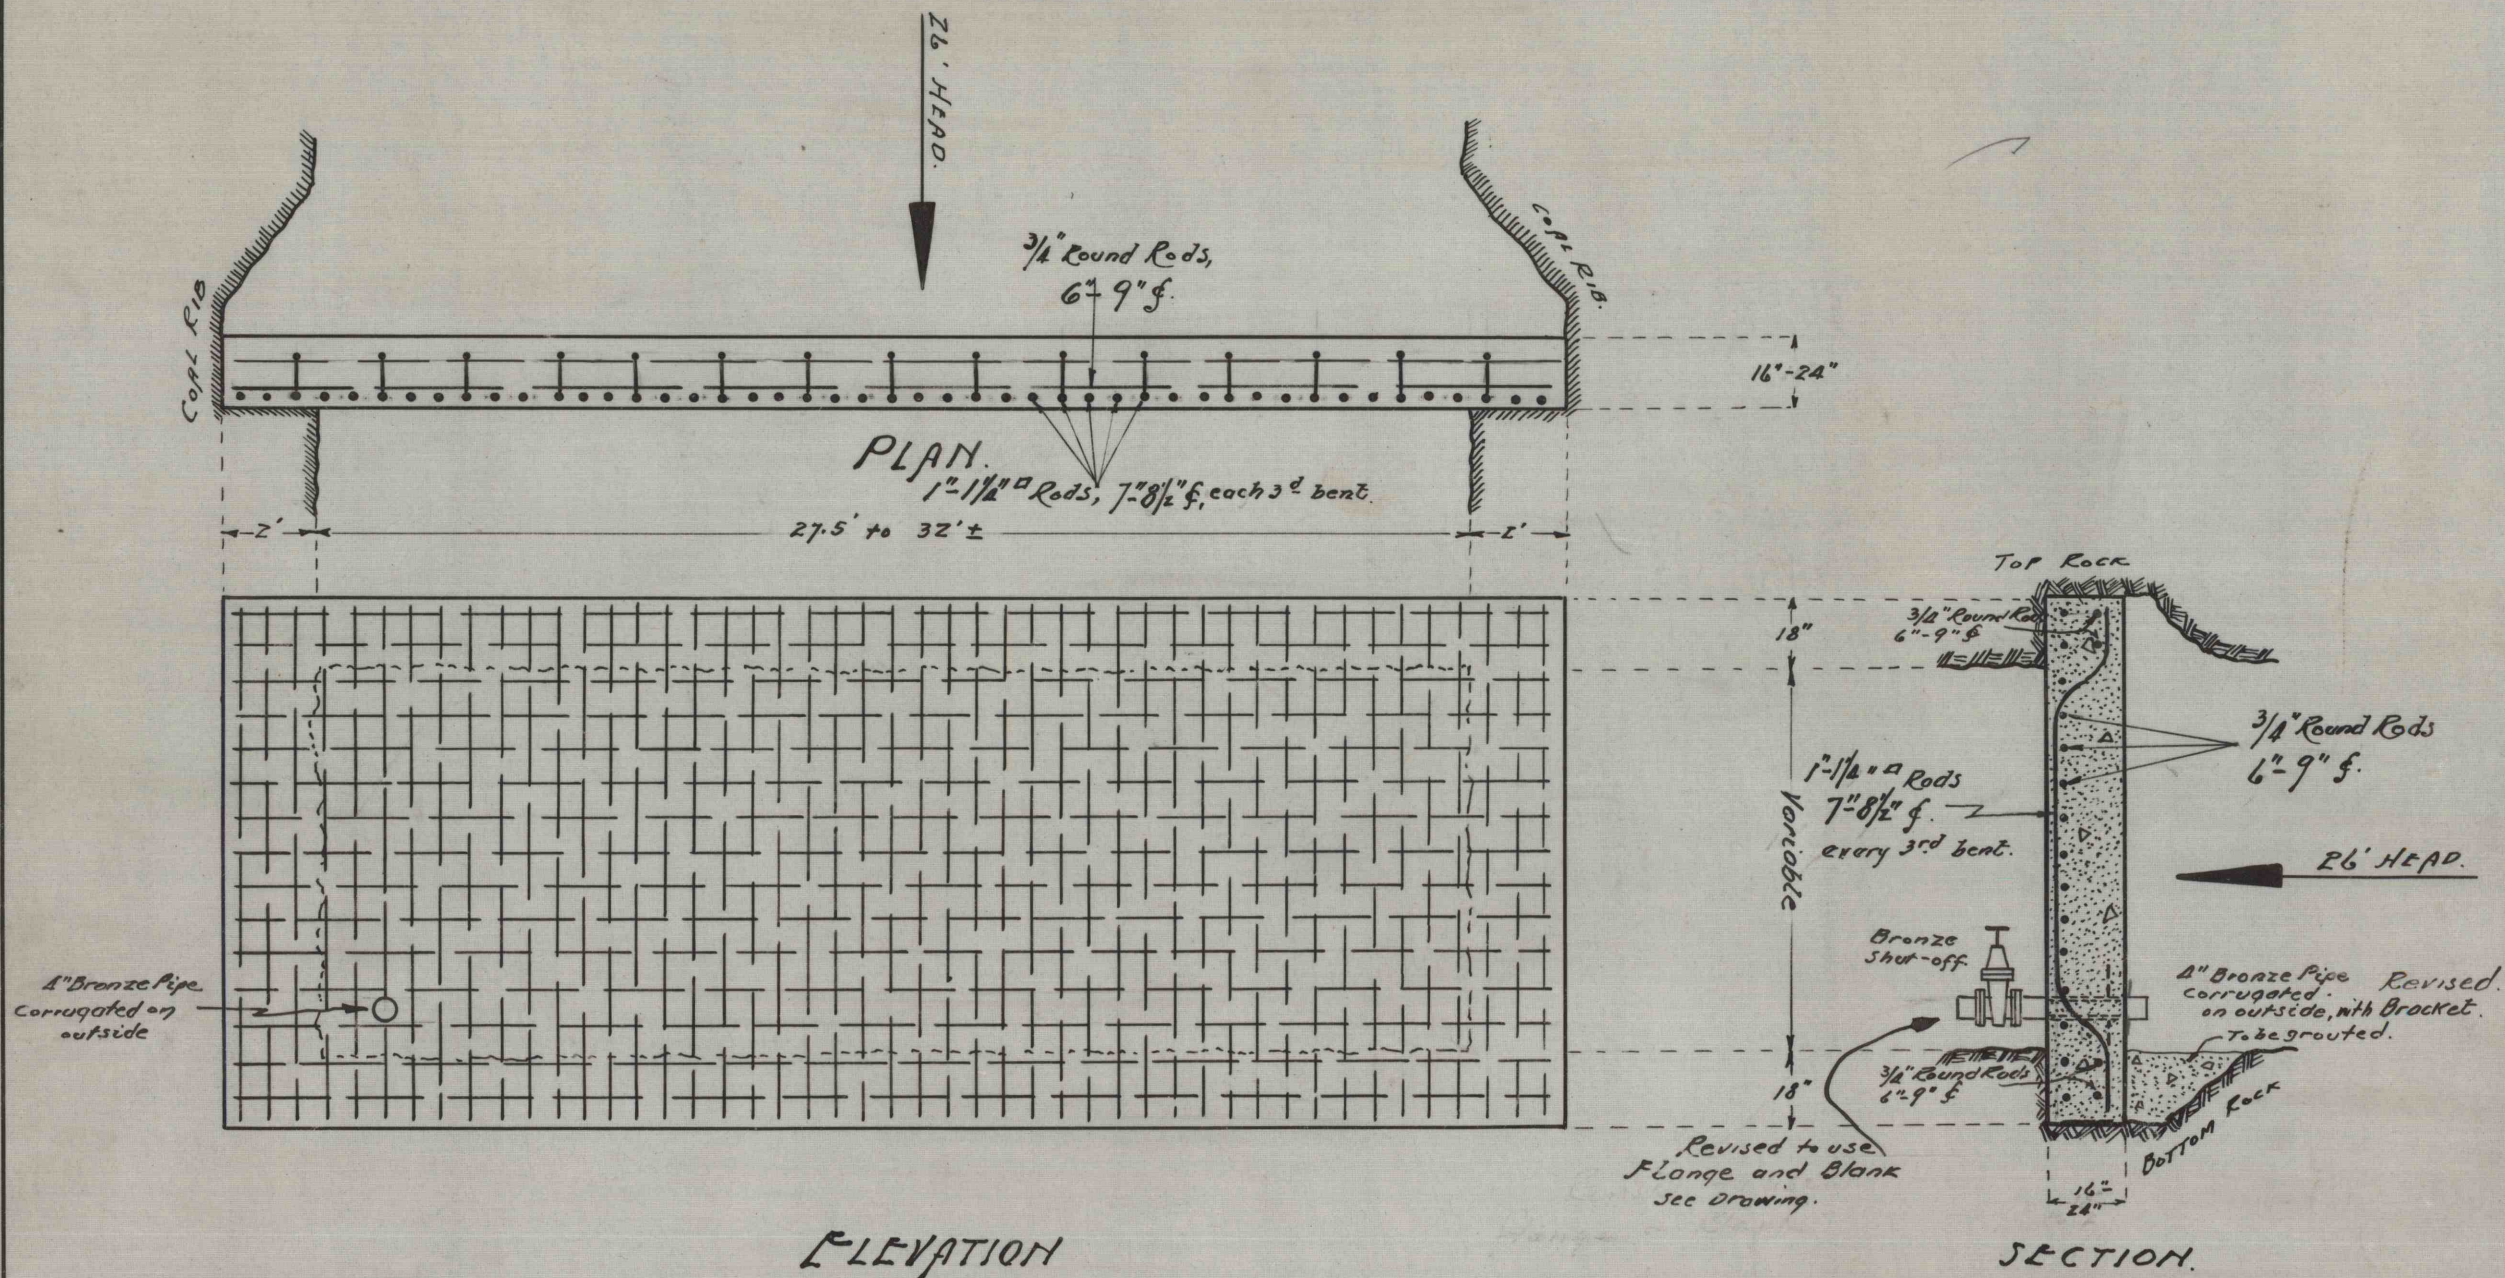

TYPICAL REINFORCED CONCRETE BULKHEAD
 TO BE ERECTED IN FIVE OR MORE CHAMBERS ON 1st W, No. 1 SLOPE,
 ROSS VEIN, NOTTINGHAM COLLY.
 SCALE, 1/4" = 1'.
 OCT. 28, 1942.

RE: AUTH. No. 15882