


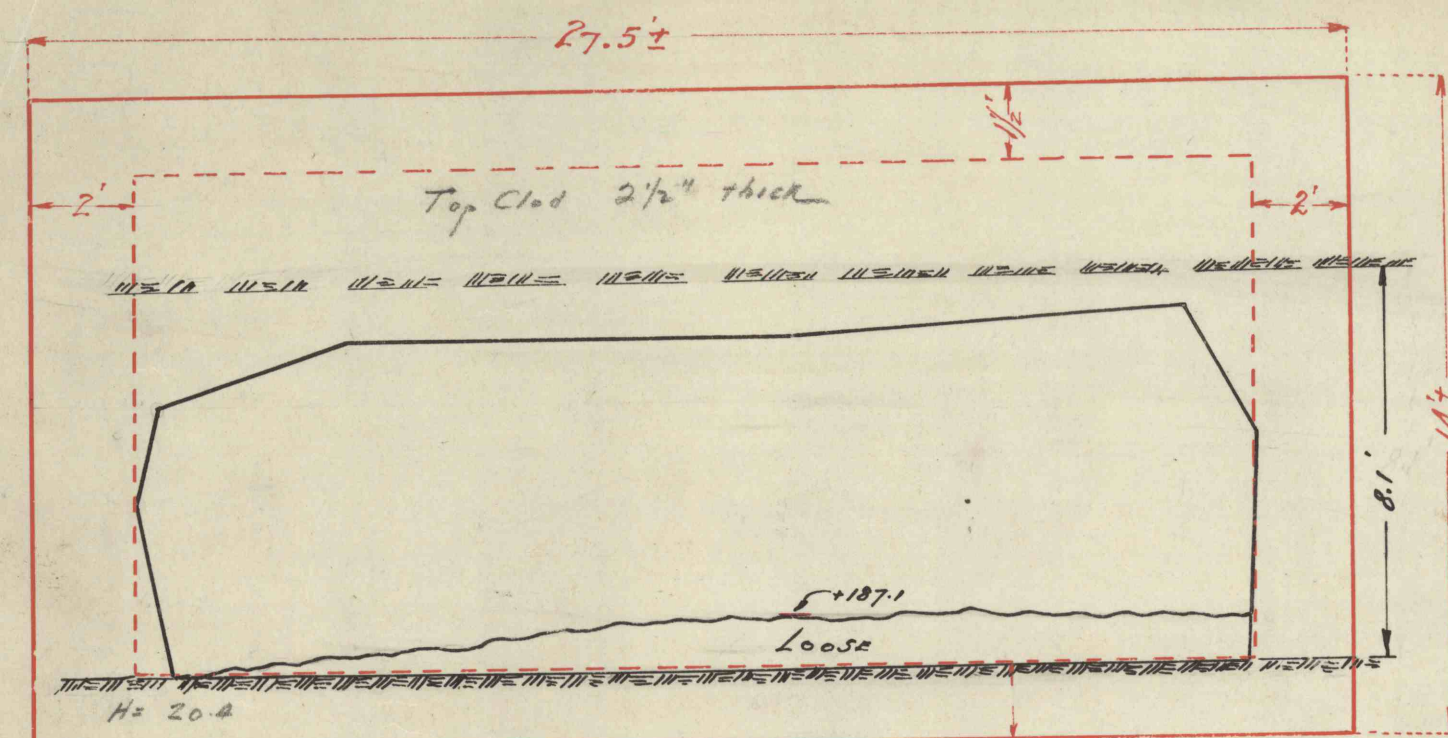


Wall 18" Thick.

5105
CH. 24. Concrete $27\frac{1}{2} \times 14 \times 1\frac{1}{2} = 21.4$ cu. yds.
47-1" Vert. Rebar. 7" ϕ , 14' long = 658 feet
23-3/4" Hor. " 9" ϕ , 15' $\times$ 2" = 690" (1.25' Lap)

$2(15 - 2 \times 6)$

Graveling $\frac{29}{16} \times 27.5 = 67.05$

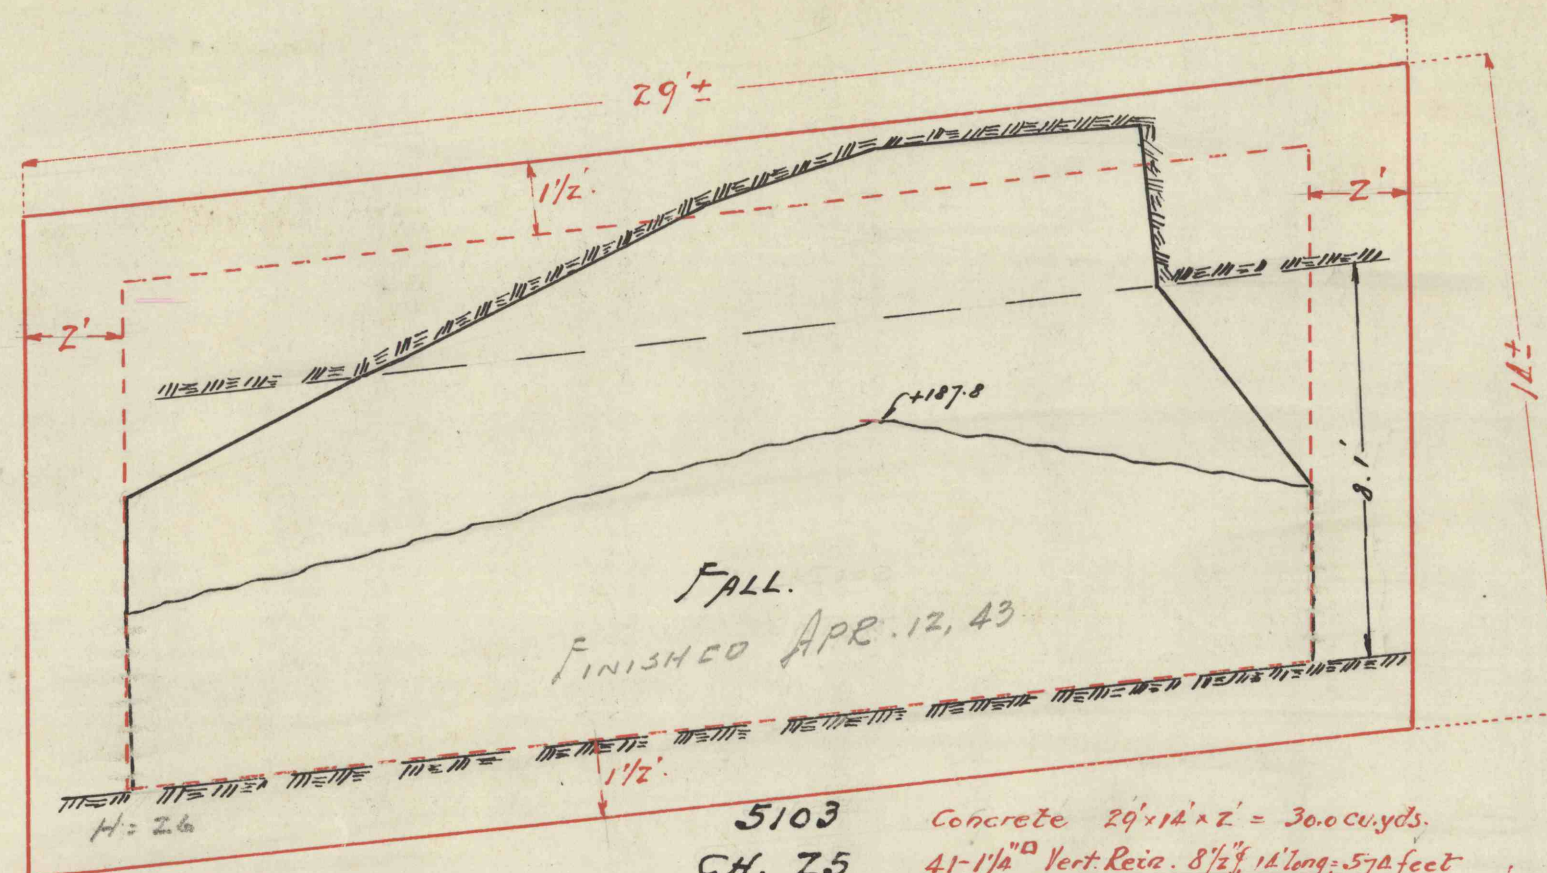


Wall 24" Thick

5103
CH. 25 Concrete $29 \times 14 \times 2' = 30.0$ cu. yds.
41-1" Vert. Rebar. 8 1/2" ϕ , 14' long = 574 feet
23-3/4" Hor. " 9" ϕ , 14' $\times$ 2" = 736" (1.5' Lap)

$2(16 - 2 \times 6)$

Graveling $\frac{29}{16} \times 29 = 70.70$

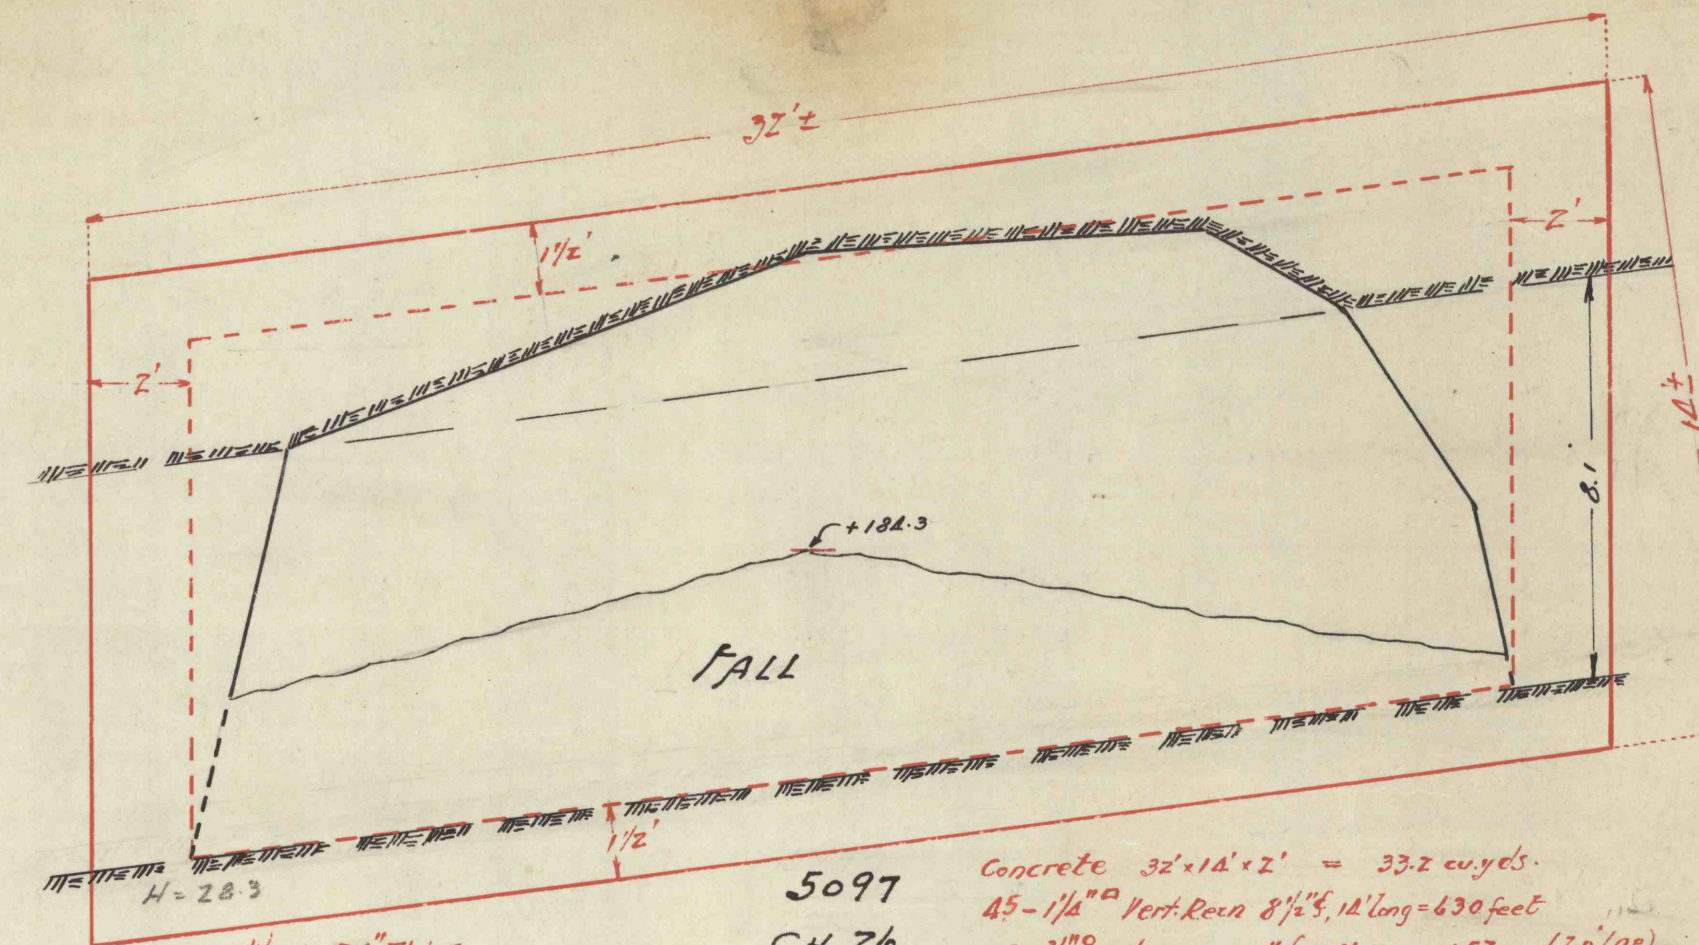


Wall 24" Thick

5097
CH. 26. Concrete $32 \times 14 \times 2' = 33.2$ cu. yds.
45-1" Vert. Rebar. 8 1/2" ϕ , 14' long = 630 feet
32-3/4" Hor. " 6" ϕ , 18' $\times$ 2" = 1152" (2.0' Lap)

$2(17 - 2 \times 6)$

Graveling $\frac{31}{16} \times 32 = 78.02$

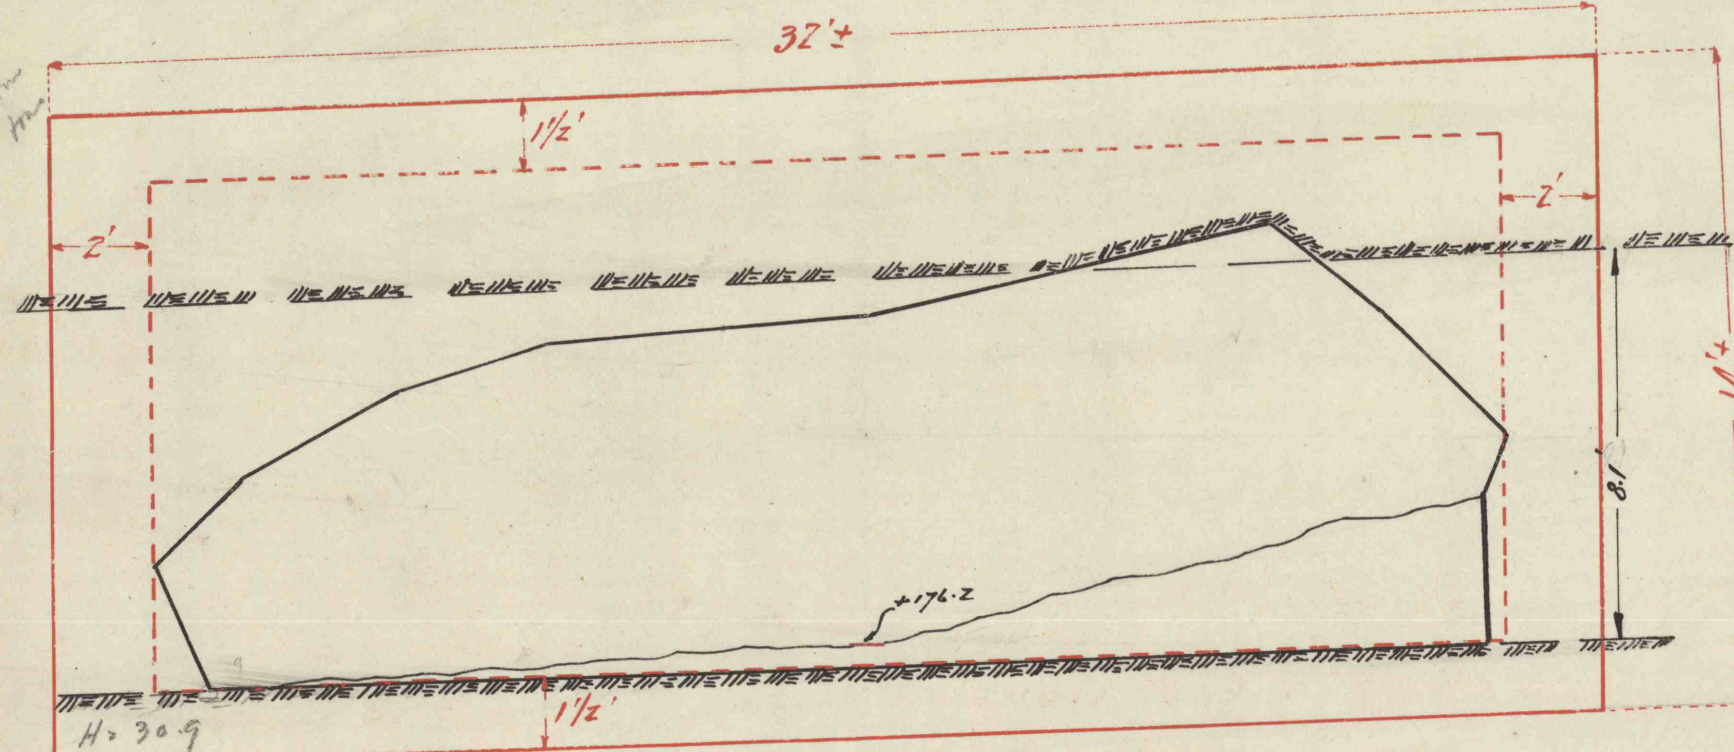


Wall 24" Thick

5094
CH. 27 Concrete $32 \times 14 \times 2' = 33.2$ cu. yds.
51-1" Vert. Rebar. 7 1/2" ϕ , 14' long = 714 feet
32-3/4" Hor. " 6" ϕ , 18' $\times$ 2" = 1152" (2.0' Lap) OVERFLOW + ZOB.1.

$2(17 - 2 \times 6)$

Graveling $\frac{29}{16} \times 32 = 78.02$

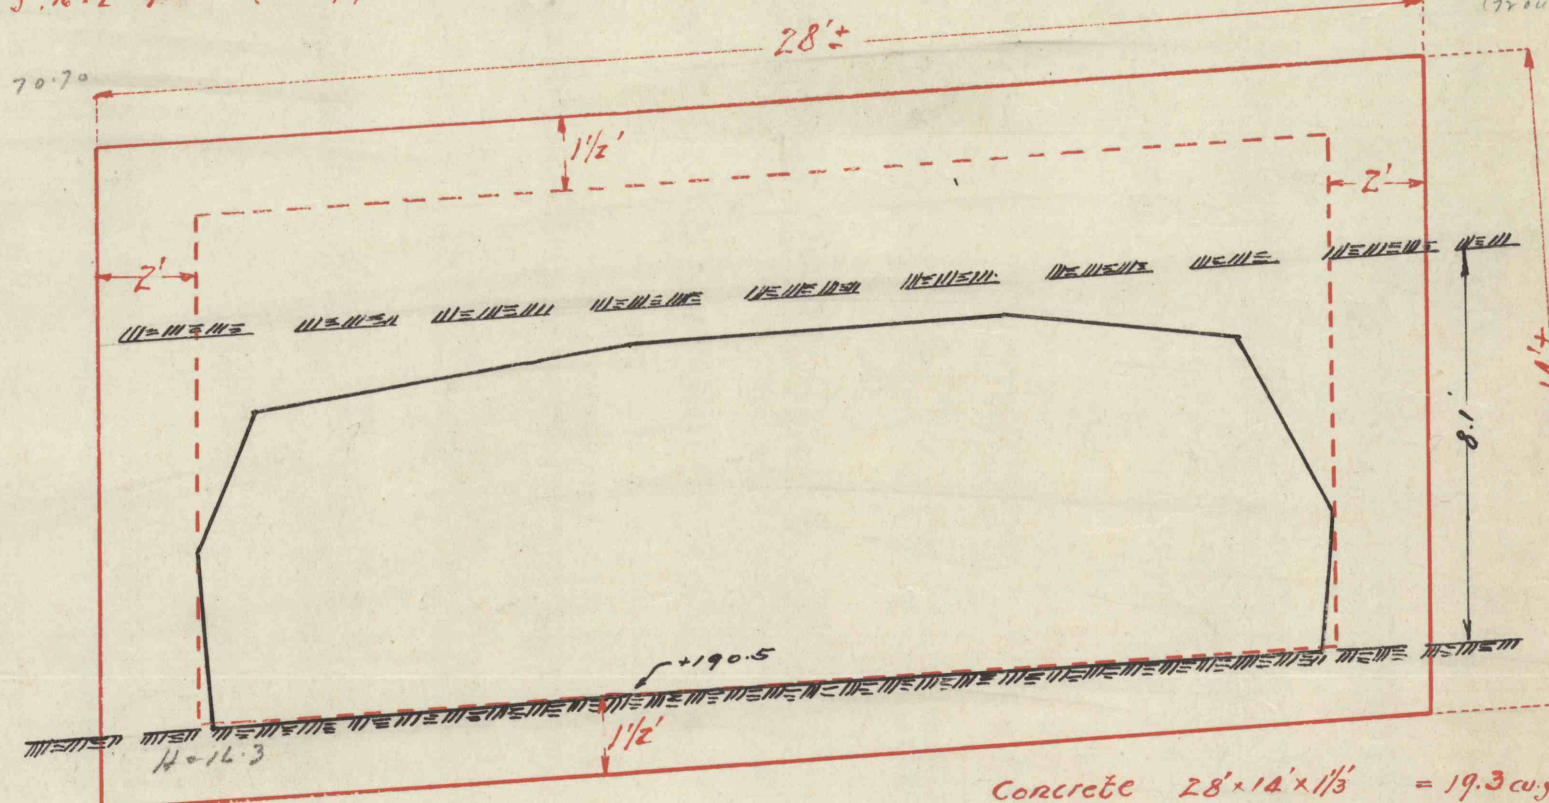

Wall 16" Thick

5096
CH. 28. Concrete $28 \times 14 \times 1\frac{1}{3} = 19.3$ cu. yds.
42-1" Vert. Rebar. 8" ϕ , 14' long = 588 feet
23-3/4" Hor. " 9" ϕ , 15' $\times$ 2" = 690" (1.0' Lap)

$2(17 - 2 \times 6)$

Graveling $\frac{29}{16} \times 28 = 68.26$

67.05

70.70

78.02

78.02

68.26

262.05 cu. yds.

14 cu. yds.
18 bags $\times$ 4 = 72 bags
5.49 cu. yds. $\times$ 1.41 = 8 tons
10.82 " $\times$ rock $\times$ 1.20 = 13 "

NOTTINGHAM COLLY. ROSS VEIN,
CROSS SECTIONS OF CHAMBERS, 1ST WEST, N^O 4 SLOPE,
RE PROPOSED REINFORCED CONCRETE BULKHEADS.
SCALE 1/4" = 1'. OCT. 31, 1942.