


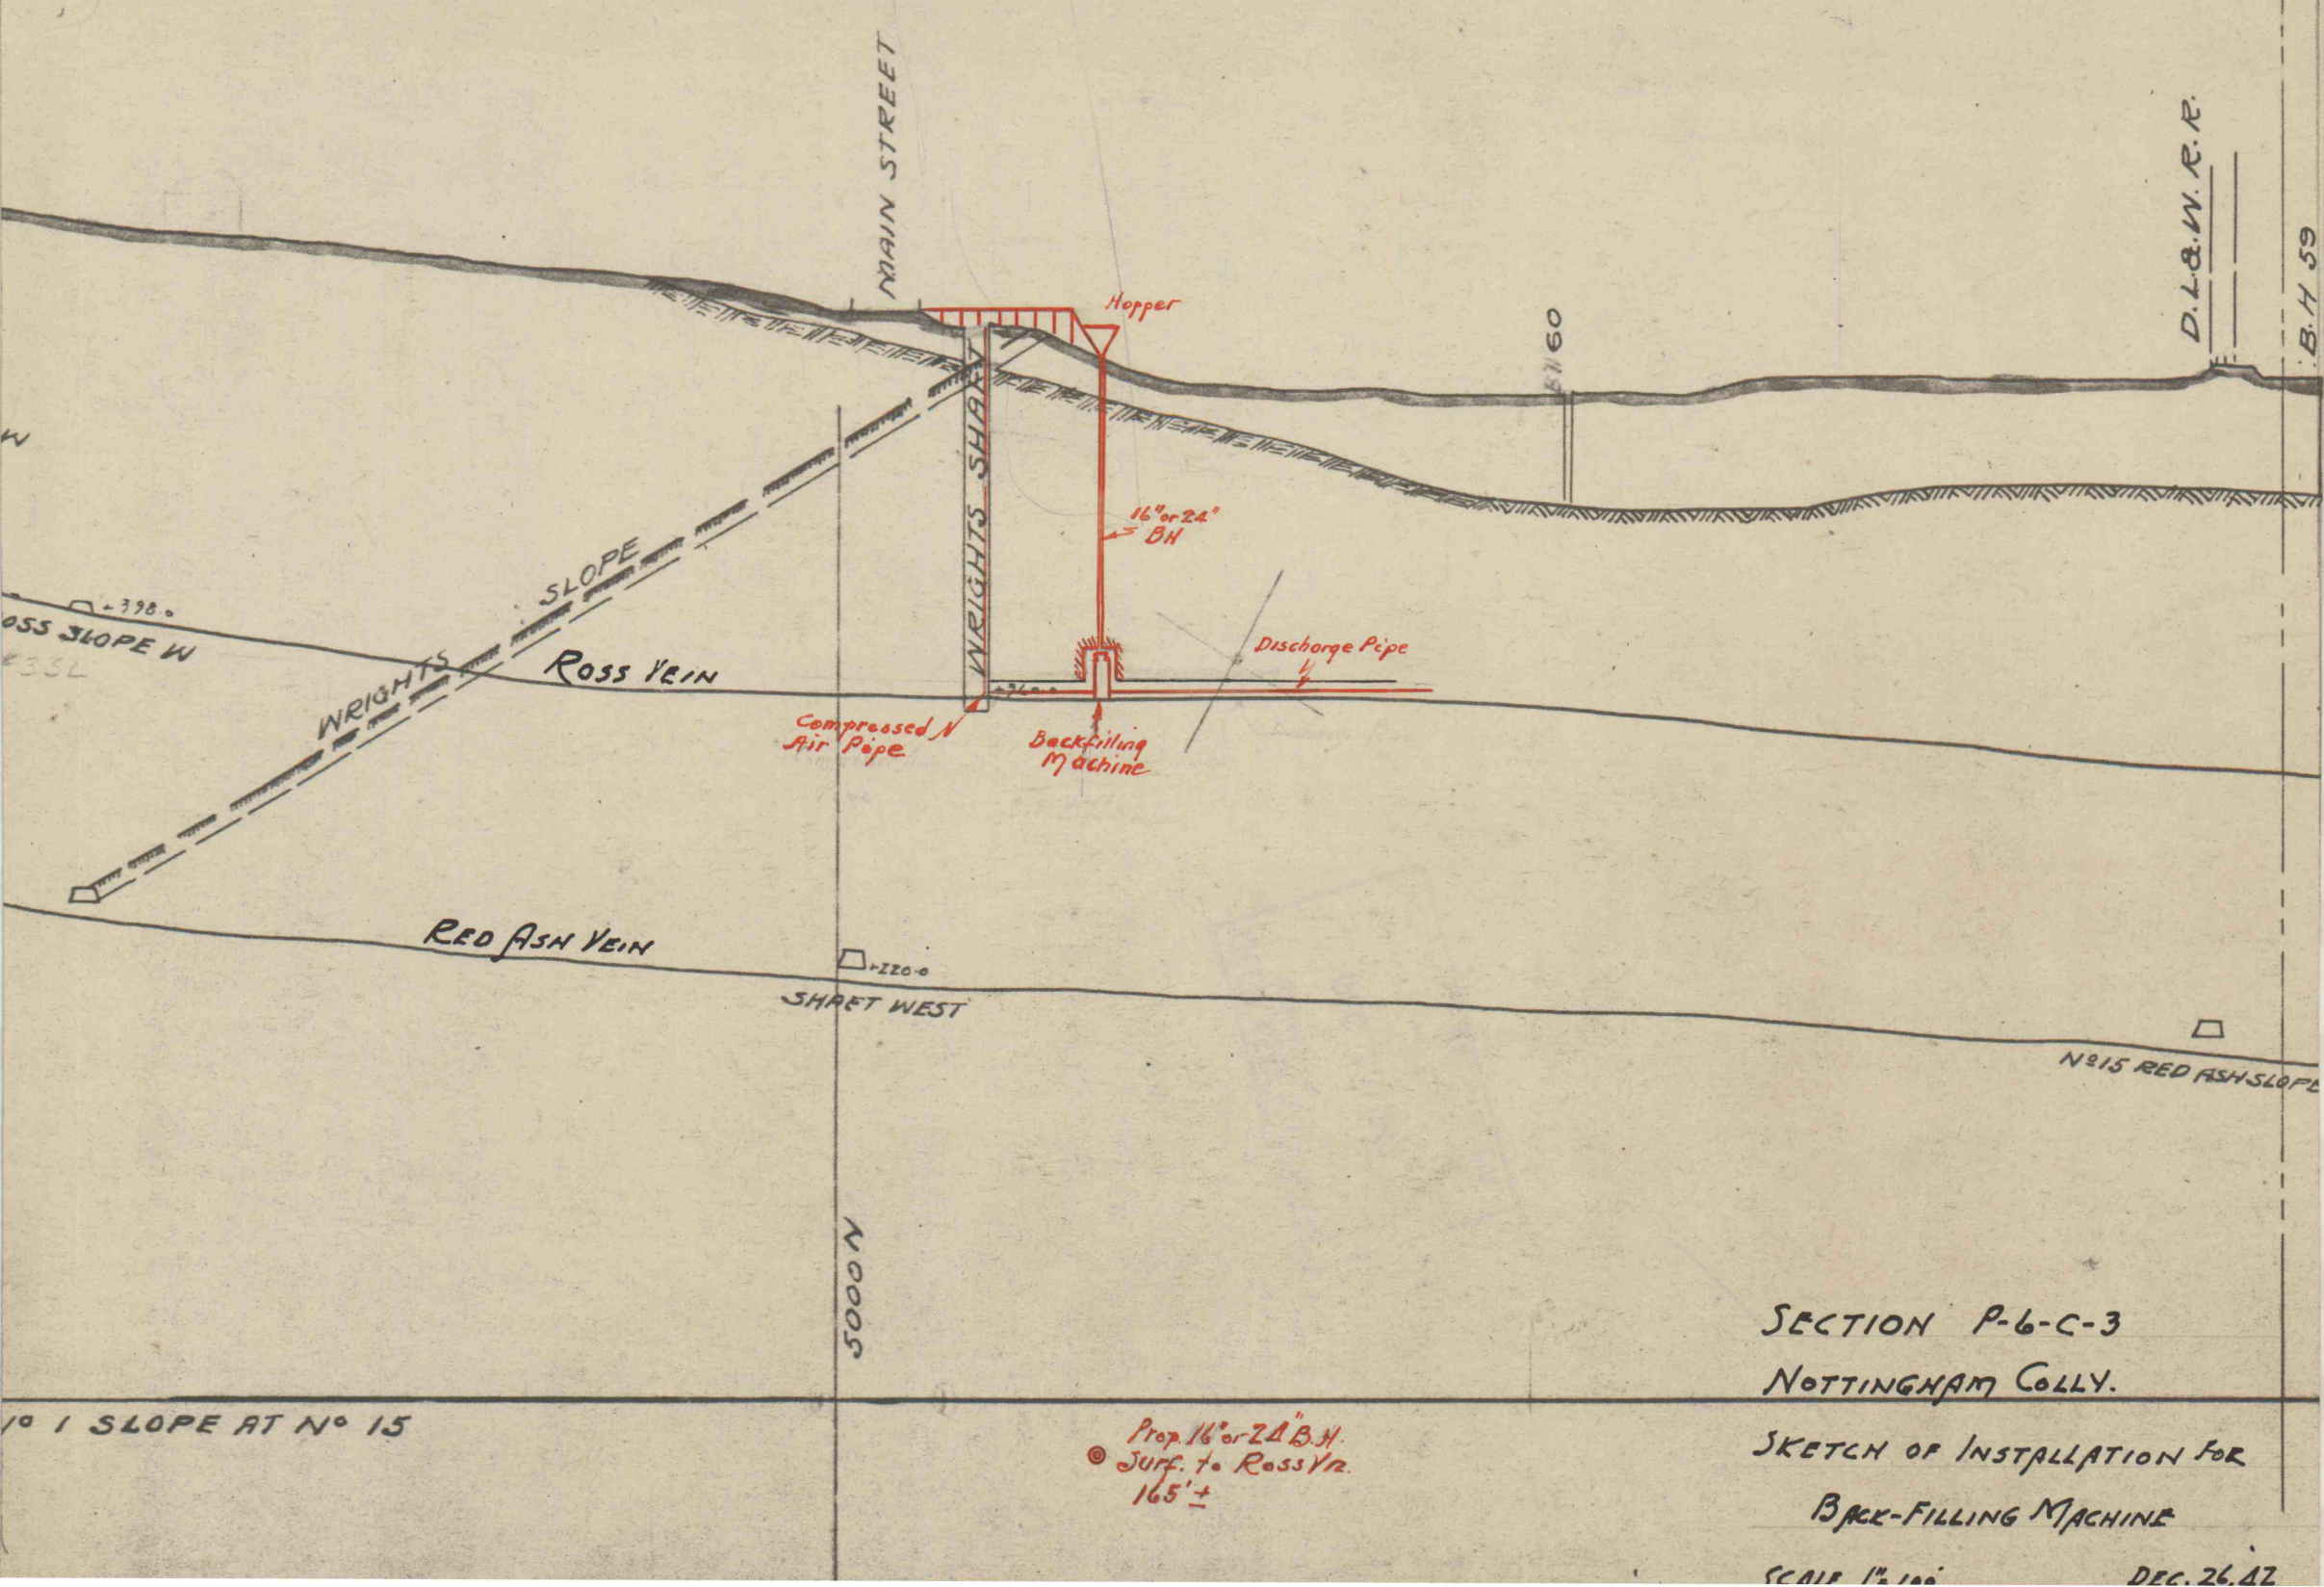

SECTION P-6-C-3

NOTTINGHAM COLLY.

SKETCH OF INSTALLATION FOR
BACK-FILLING MACHINE

SCALE 1" = 100'

DEC. 26.02

Prop. 16" or 24" B.H.
Surf. to Ross Vein.
165' ±

SHAFT WEST

5000'

RED ASH VEIN

ROSS VEIN

WRIGHTS

SLOPE

ROSS SLOPE W

MAIN STREET

D.L. & W. R.R.

B. 4759