


PENNSYLVANIA
DEPARTMENT OF HIGHWAYS
CROSS SECTIONS

Const. X-Sections - Rd.		749+ to 1765+			
District	County	Sect.	Book No.	Final Book No.	Sheet No.
4-0	Luzerne	4	22	15797	8

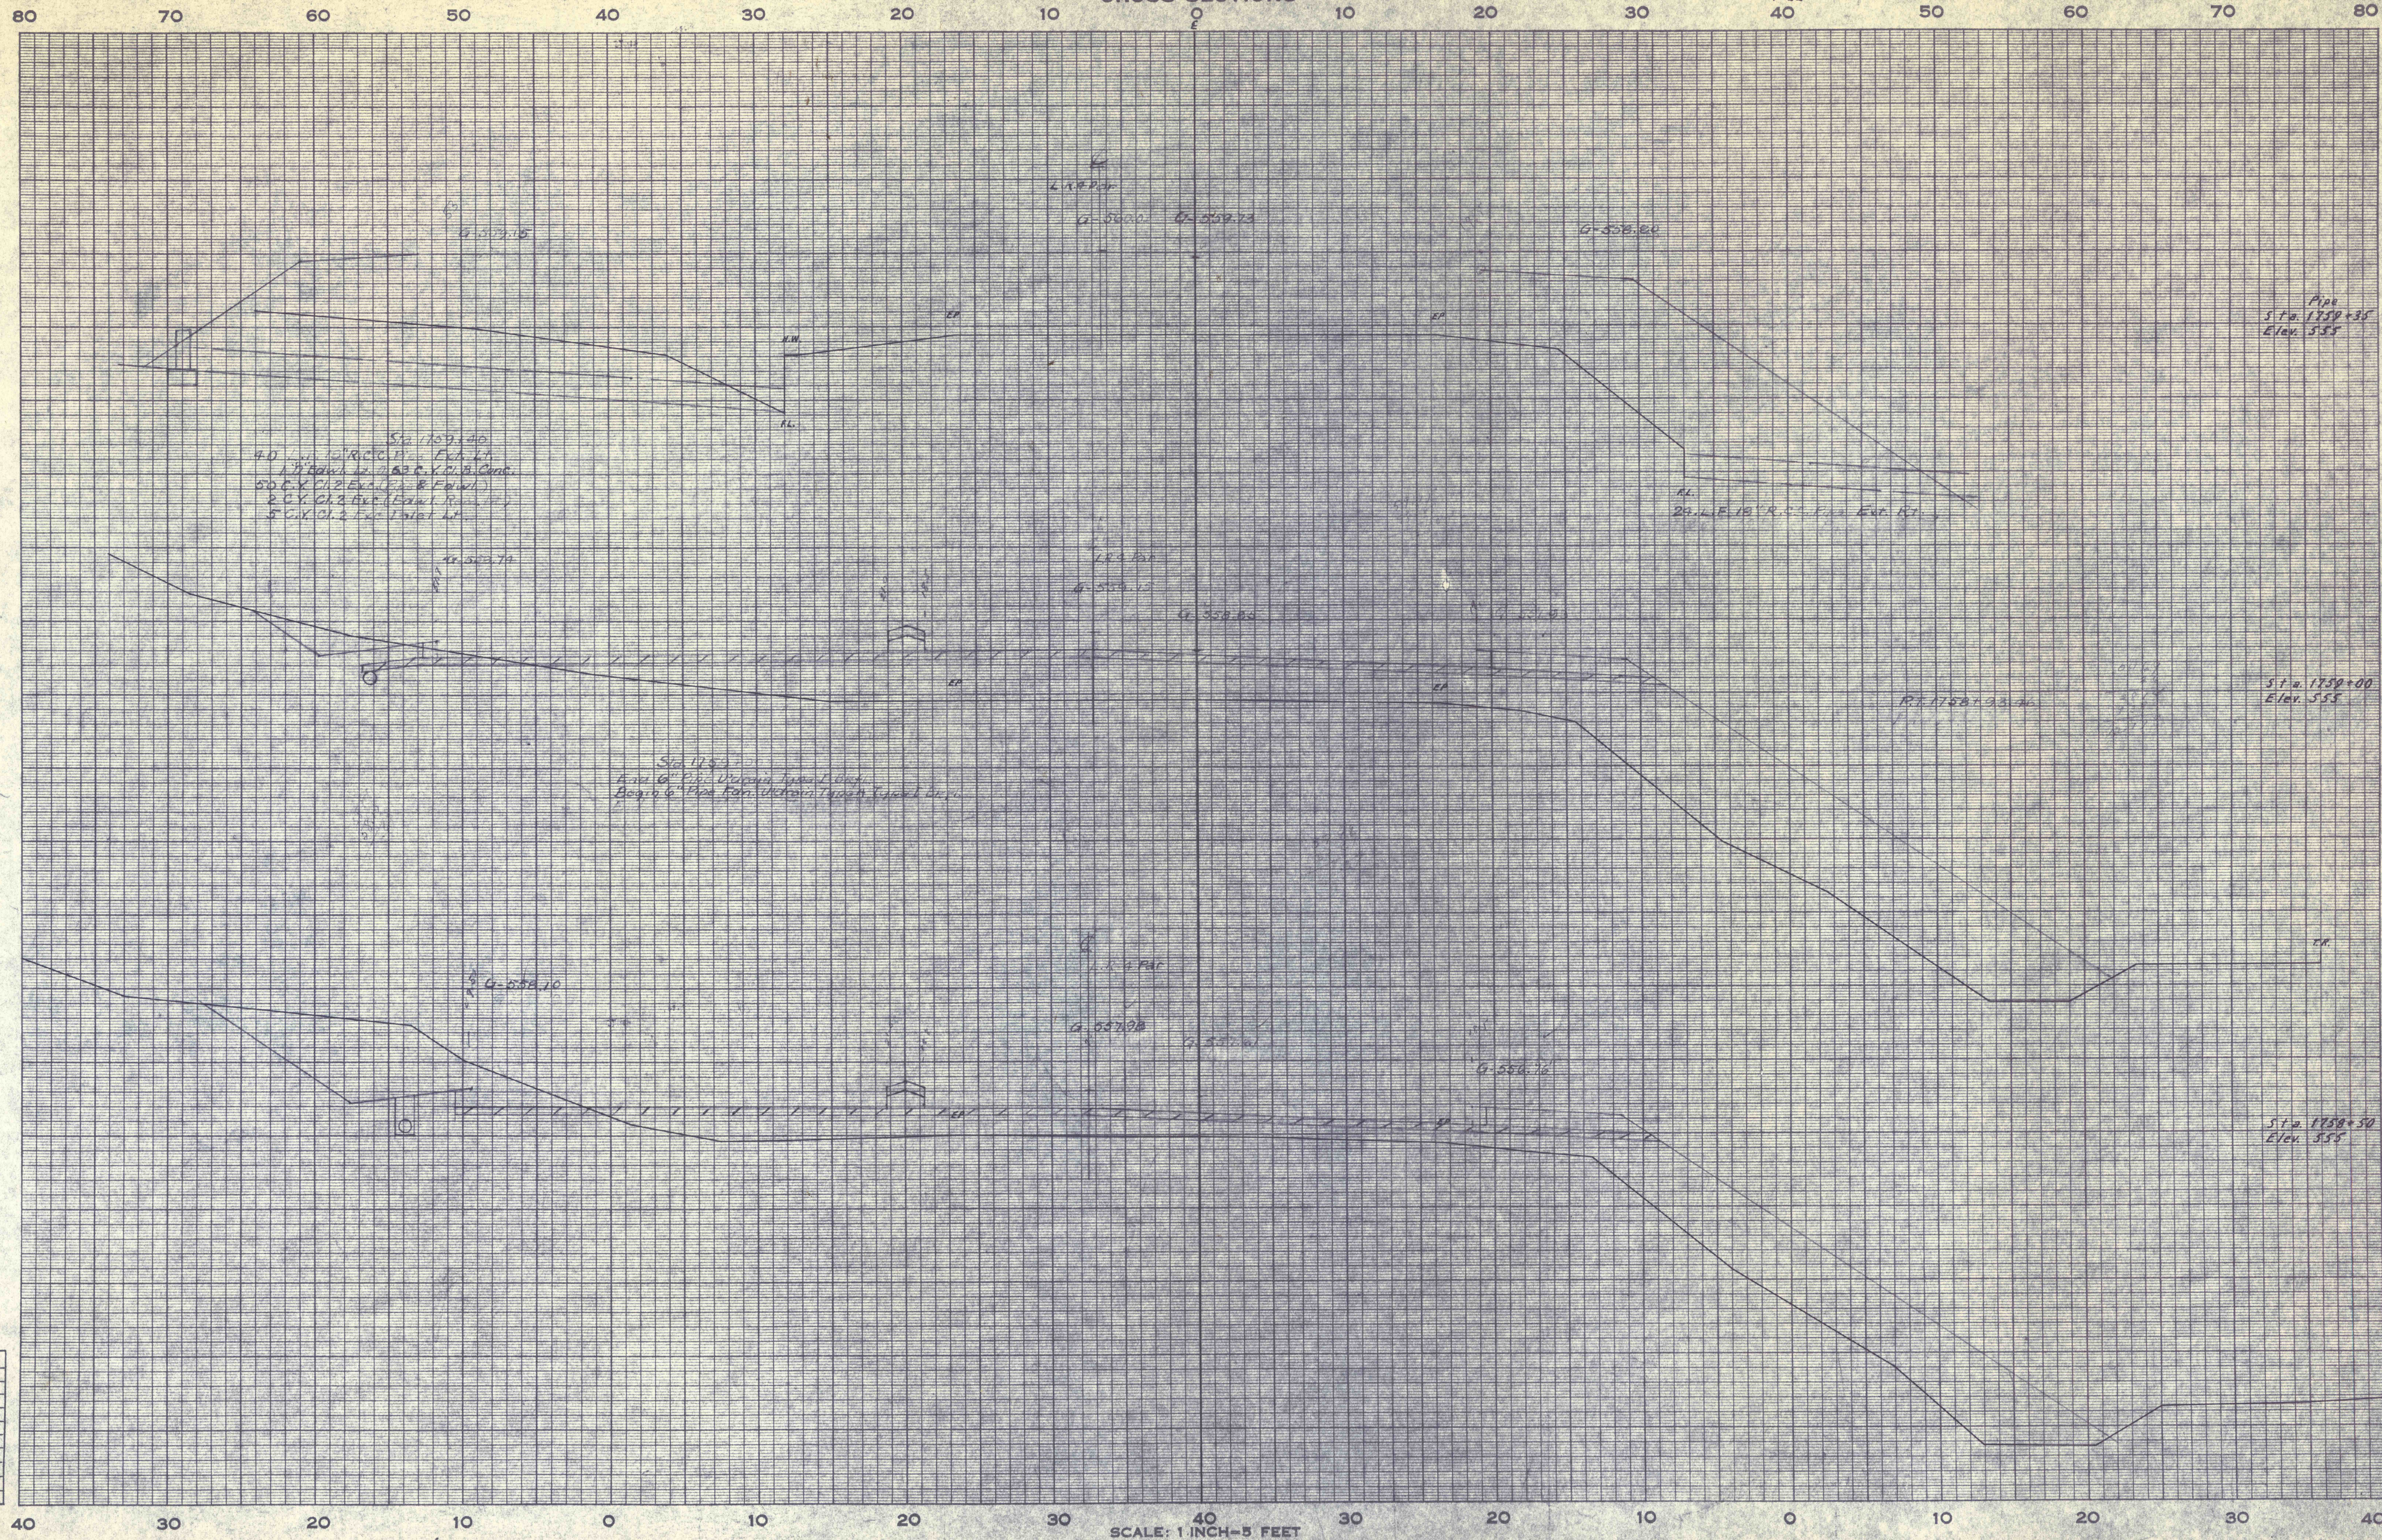

Application No.	_____
Route No.	_____
Original Plotted by	_____
Checked by	_____
Template by	_____
Area by	_____
Finals Plotted by	_____
Checked by	_____
Area by	_____
Checked by	_____