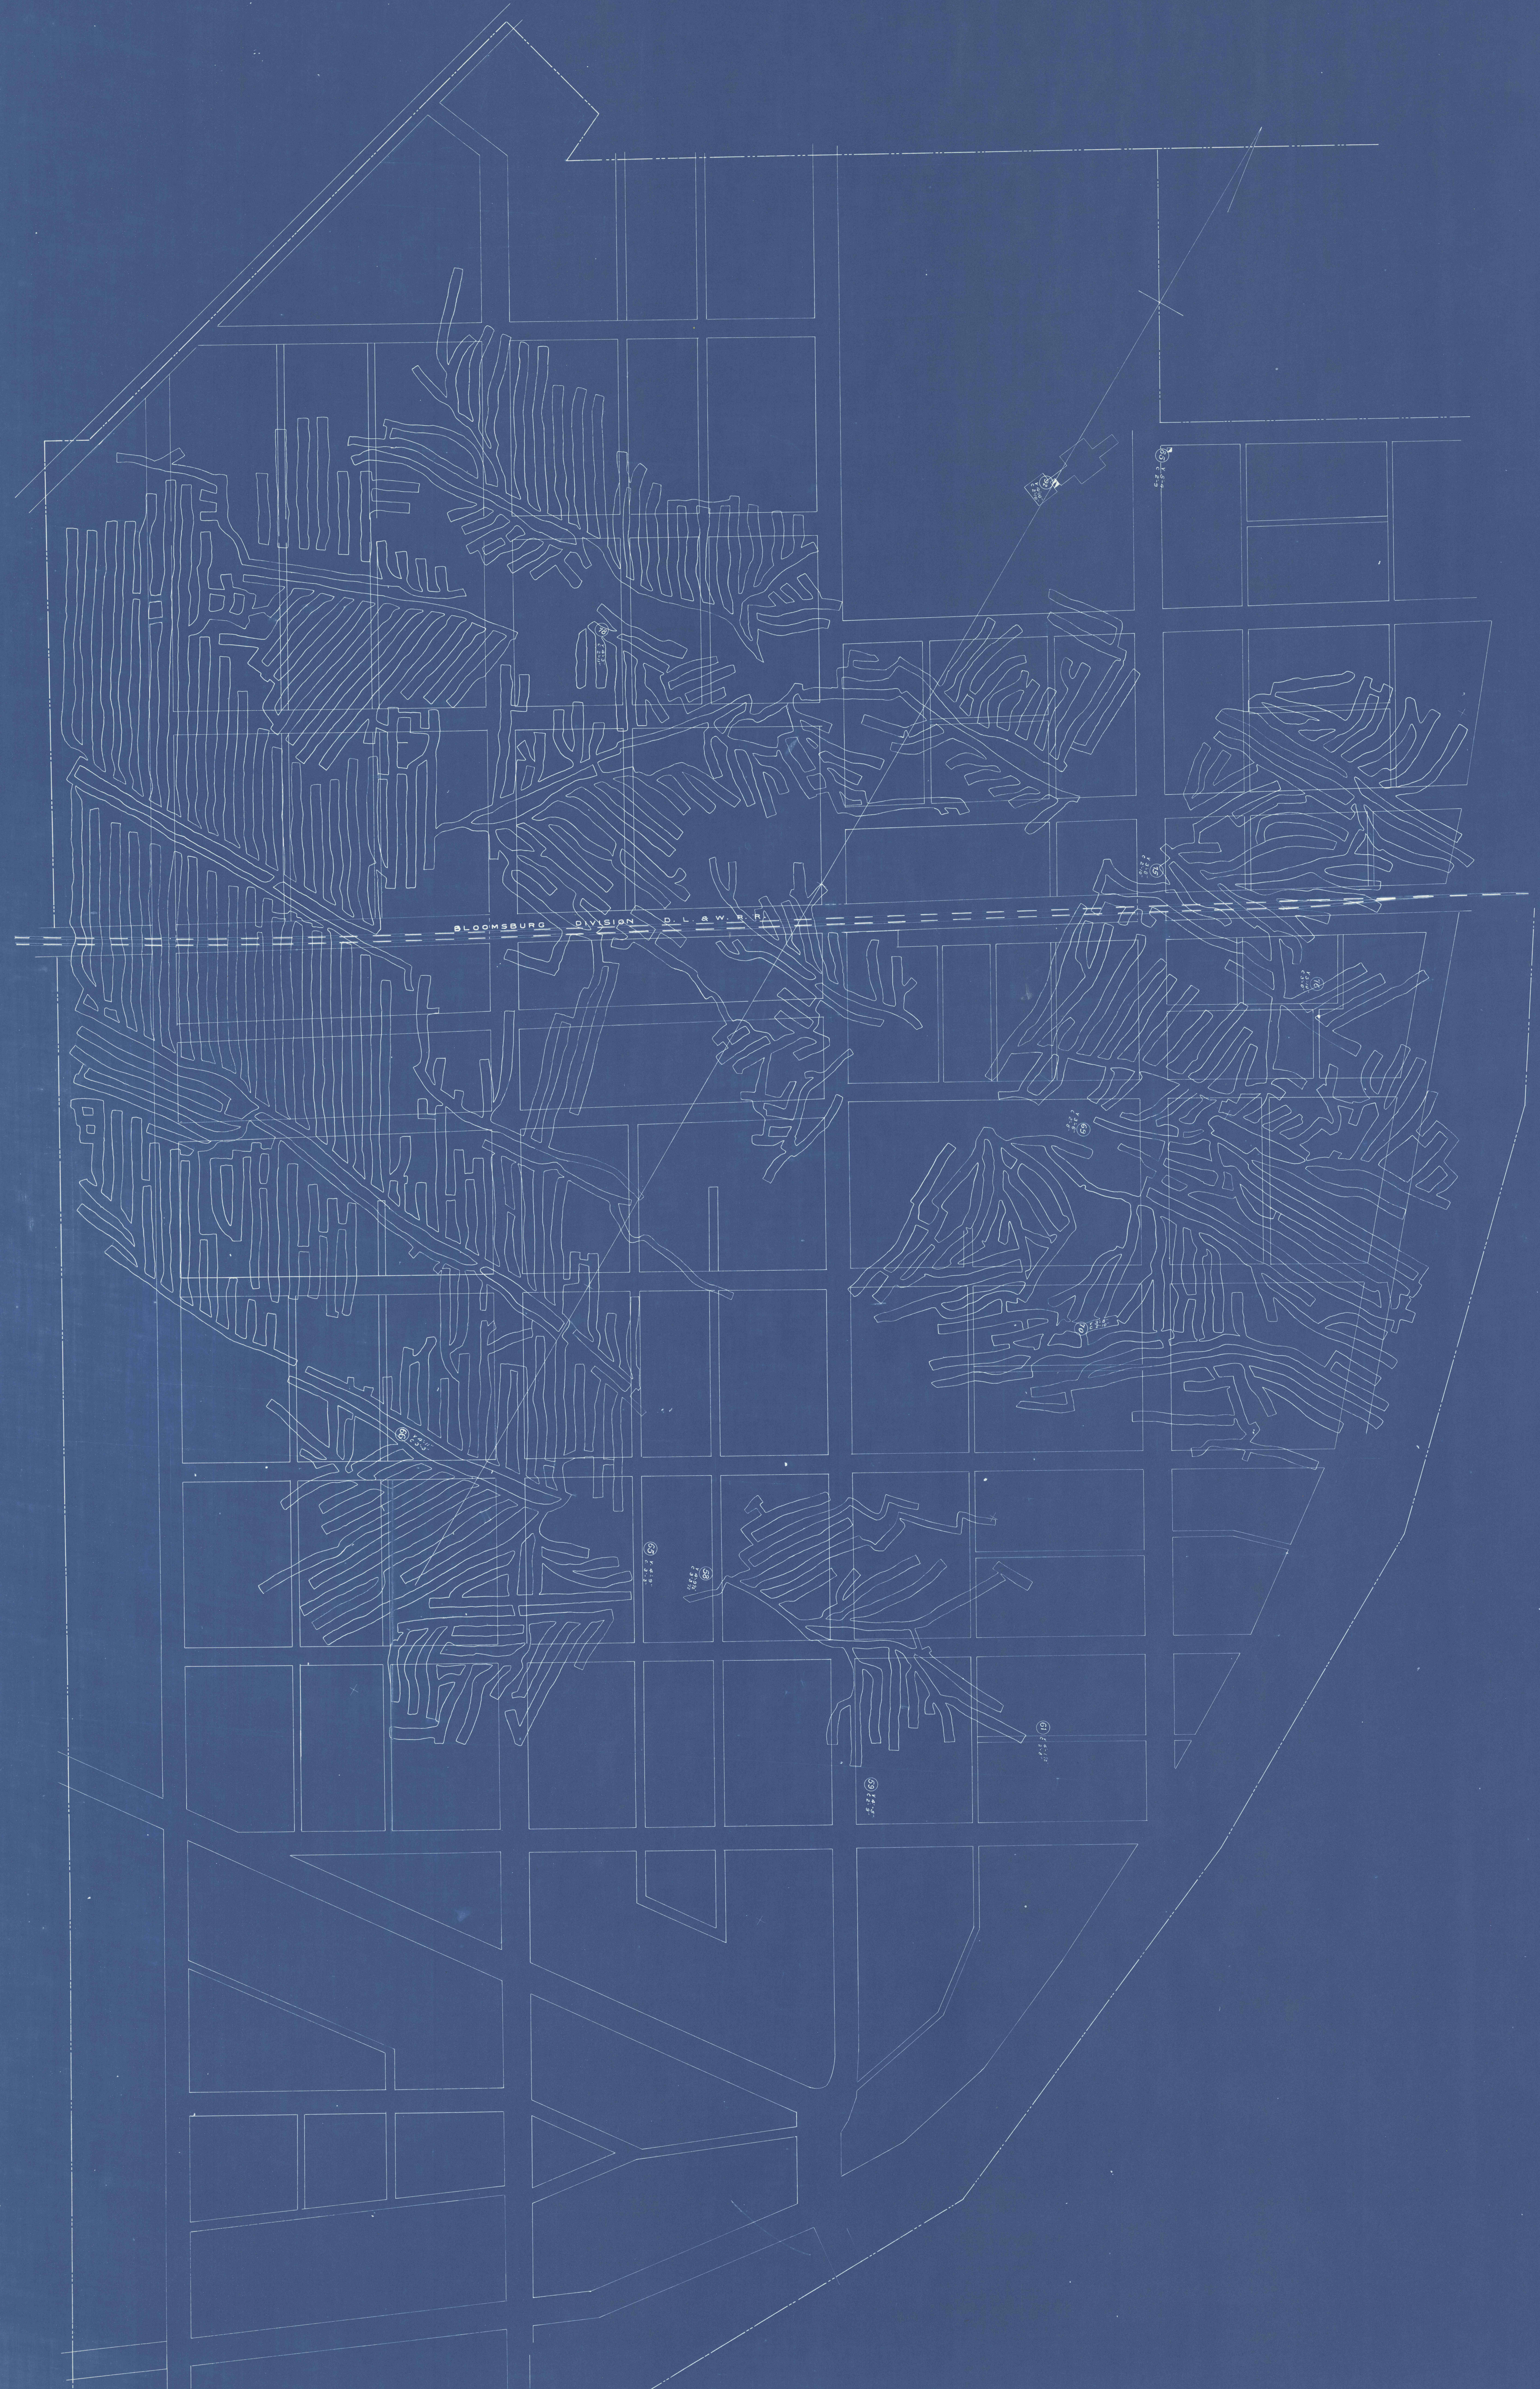
BLOOMSBURG DIVISION D.L.&W.R.R.
92 Y 4'-10" C 2'-10"
85 Y 5'-4" C 2'-9"
65 Y 4'-9" C 3'-3"
58 Y 4'-9½" C 3'-3½"
59 Y 4'-5" C 2'-9"
61 Y 4'-1½" C 2'-8"
70 Y 3'-8" C 2'-10"
69 Y 3'-6" C 2'-8"
75 Y 3'-8" C 2'-10"
76 Y 3'-10" C 3'-0"
99 Y 4'-11" C 3'-3"
78 Y 4'-3" C 2'-11"