
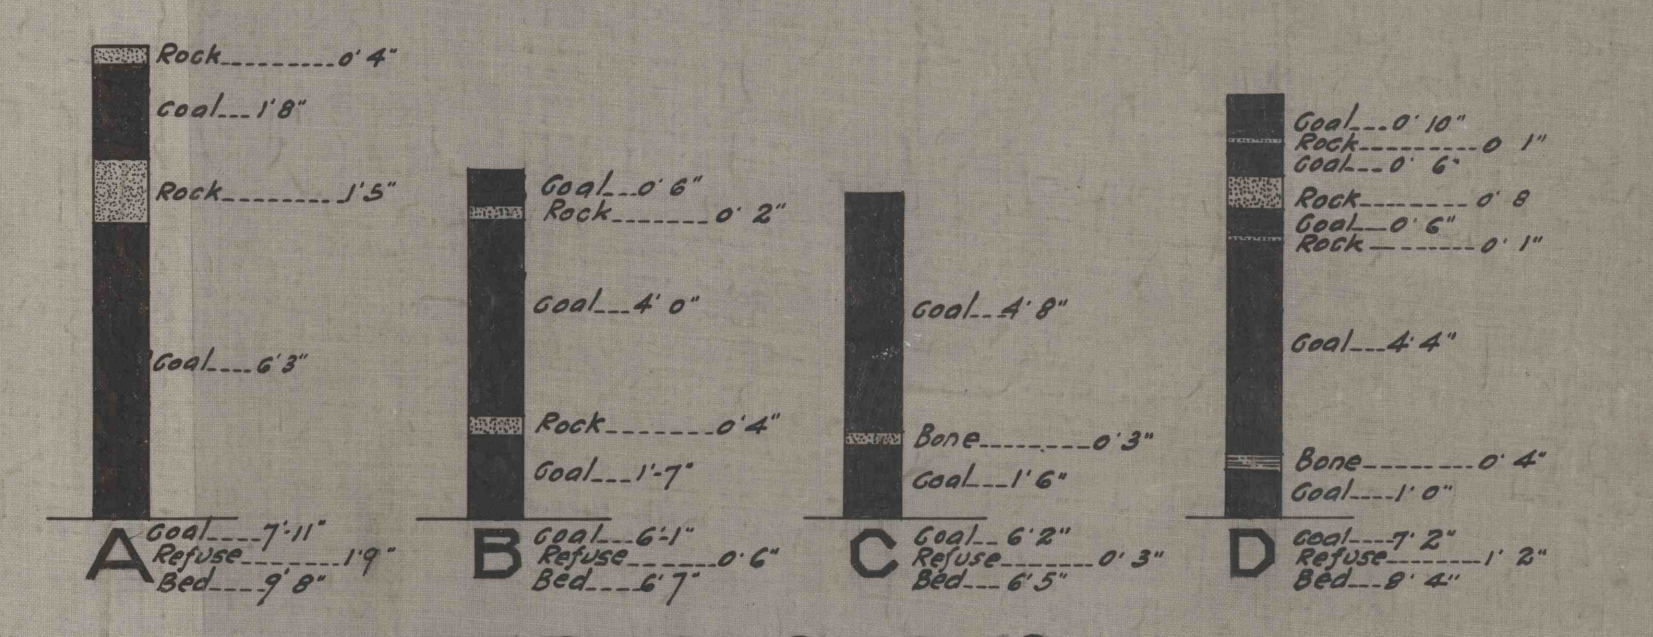


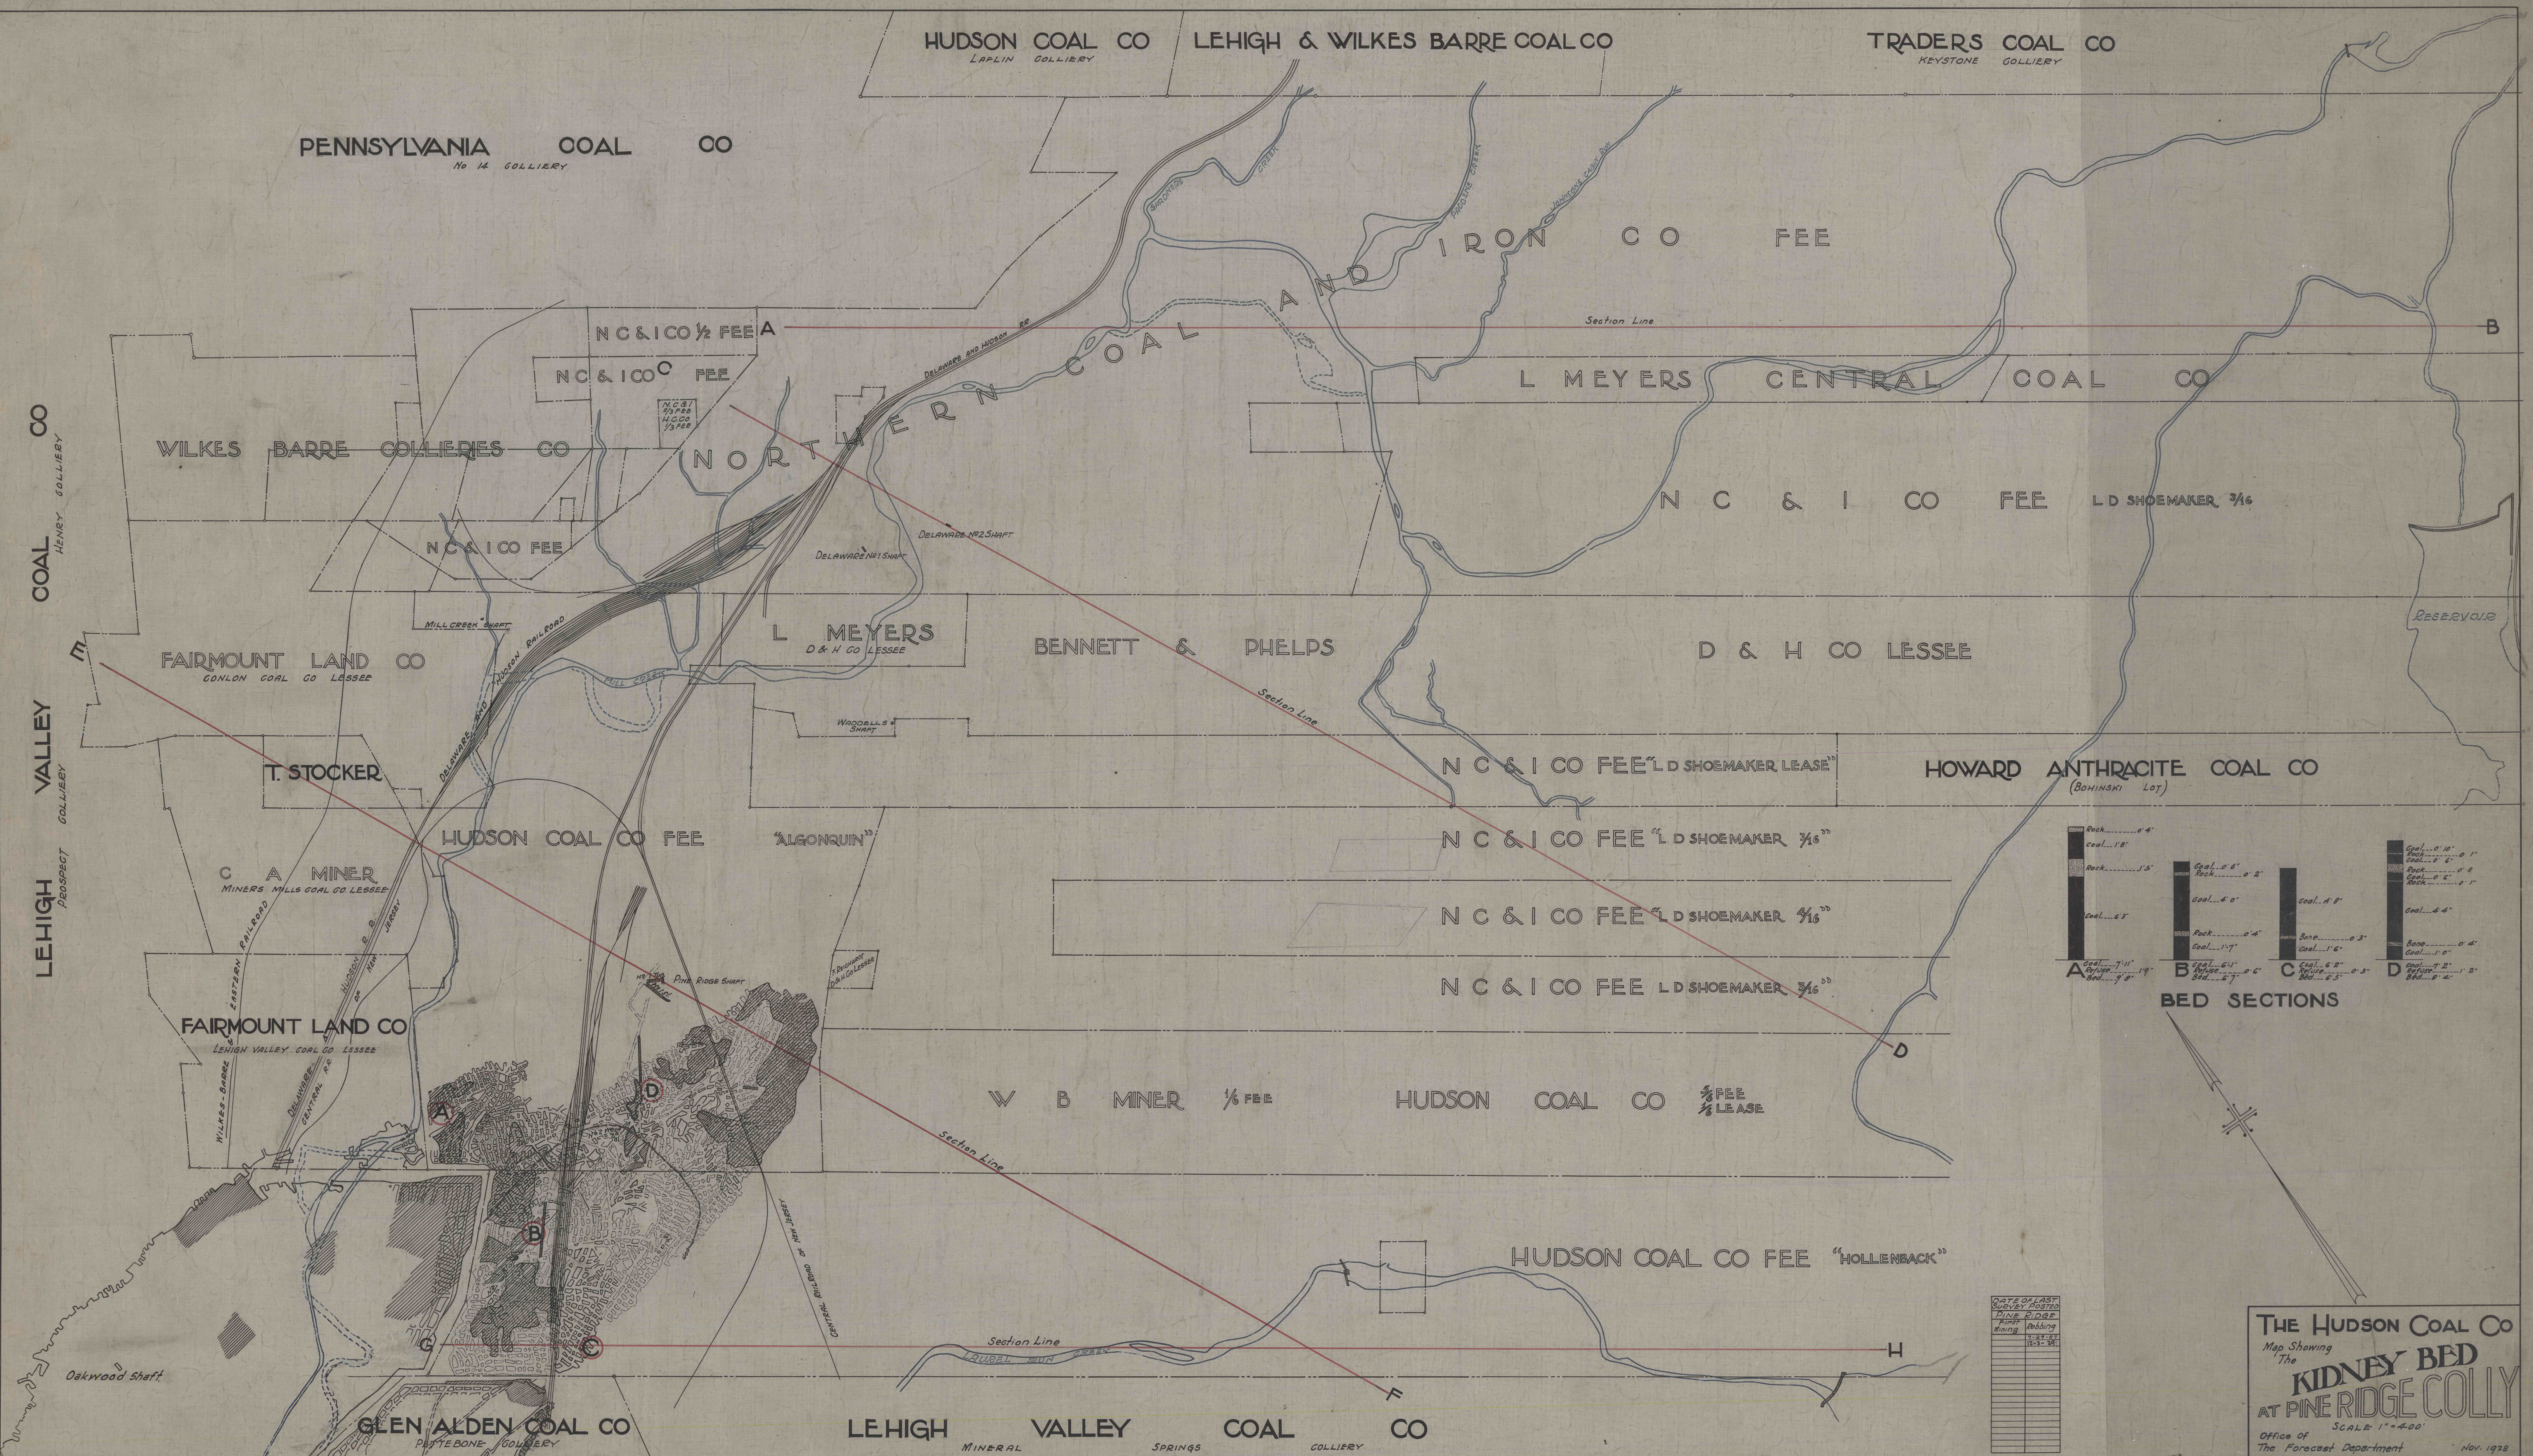

DATE OF LAST SURVEY POSTED	DATE OF LAST SURVEY POSTED
1925	1925
1926	1926
1927	1927
1928	1928
1929	1929
1930	1930
1931	1931
1932	1932
1933	1933
1934	1934
1935	1935
1936	1936
1937	1937
1938	1938
1939	1939
1940	1940
1941	1941
1942	1942
1943	1943
1944	1944
1945	1945
1946	1946
1947	1947
1948	1948
1949	1949
1950	1950

THE HUDSON COAL CO
Map Showing
The
KIDNEY BED
AT PINE RIDGE COLLY
SCALE 1"=400'
Office of
The Forecast Department
Nov. 1928