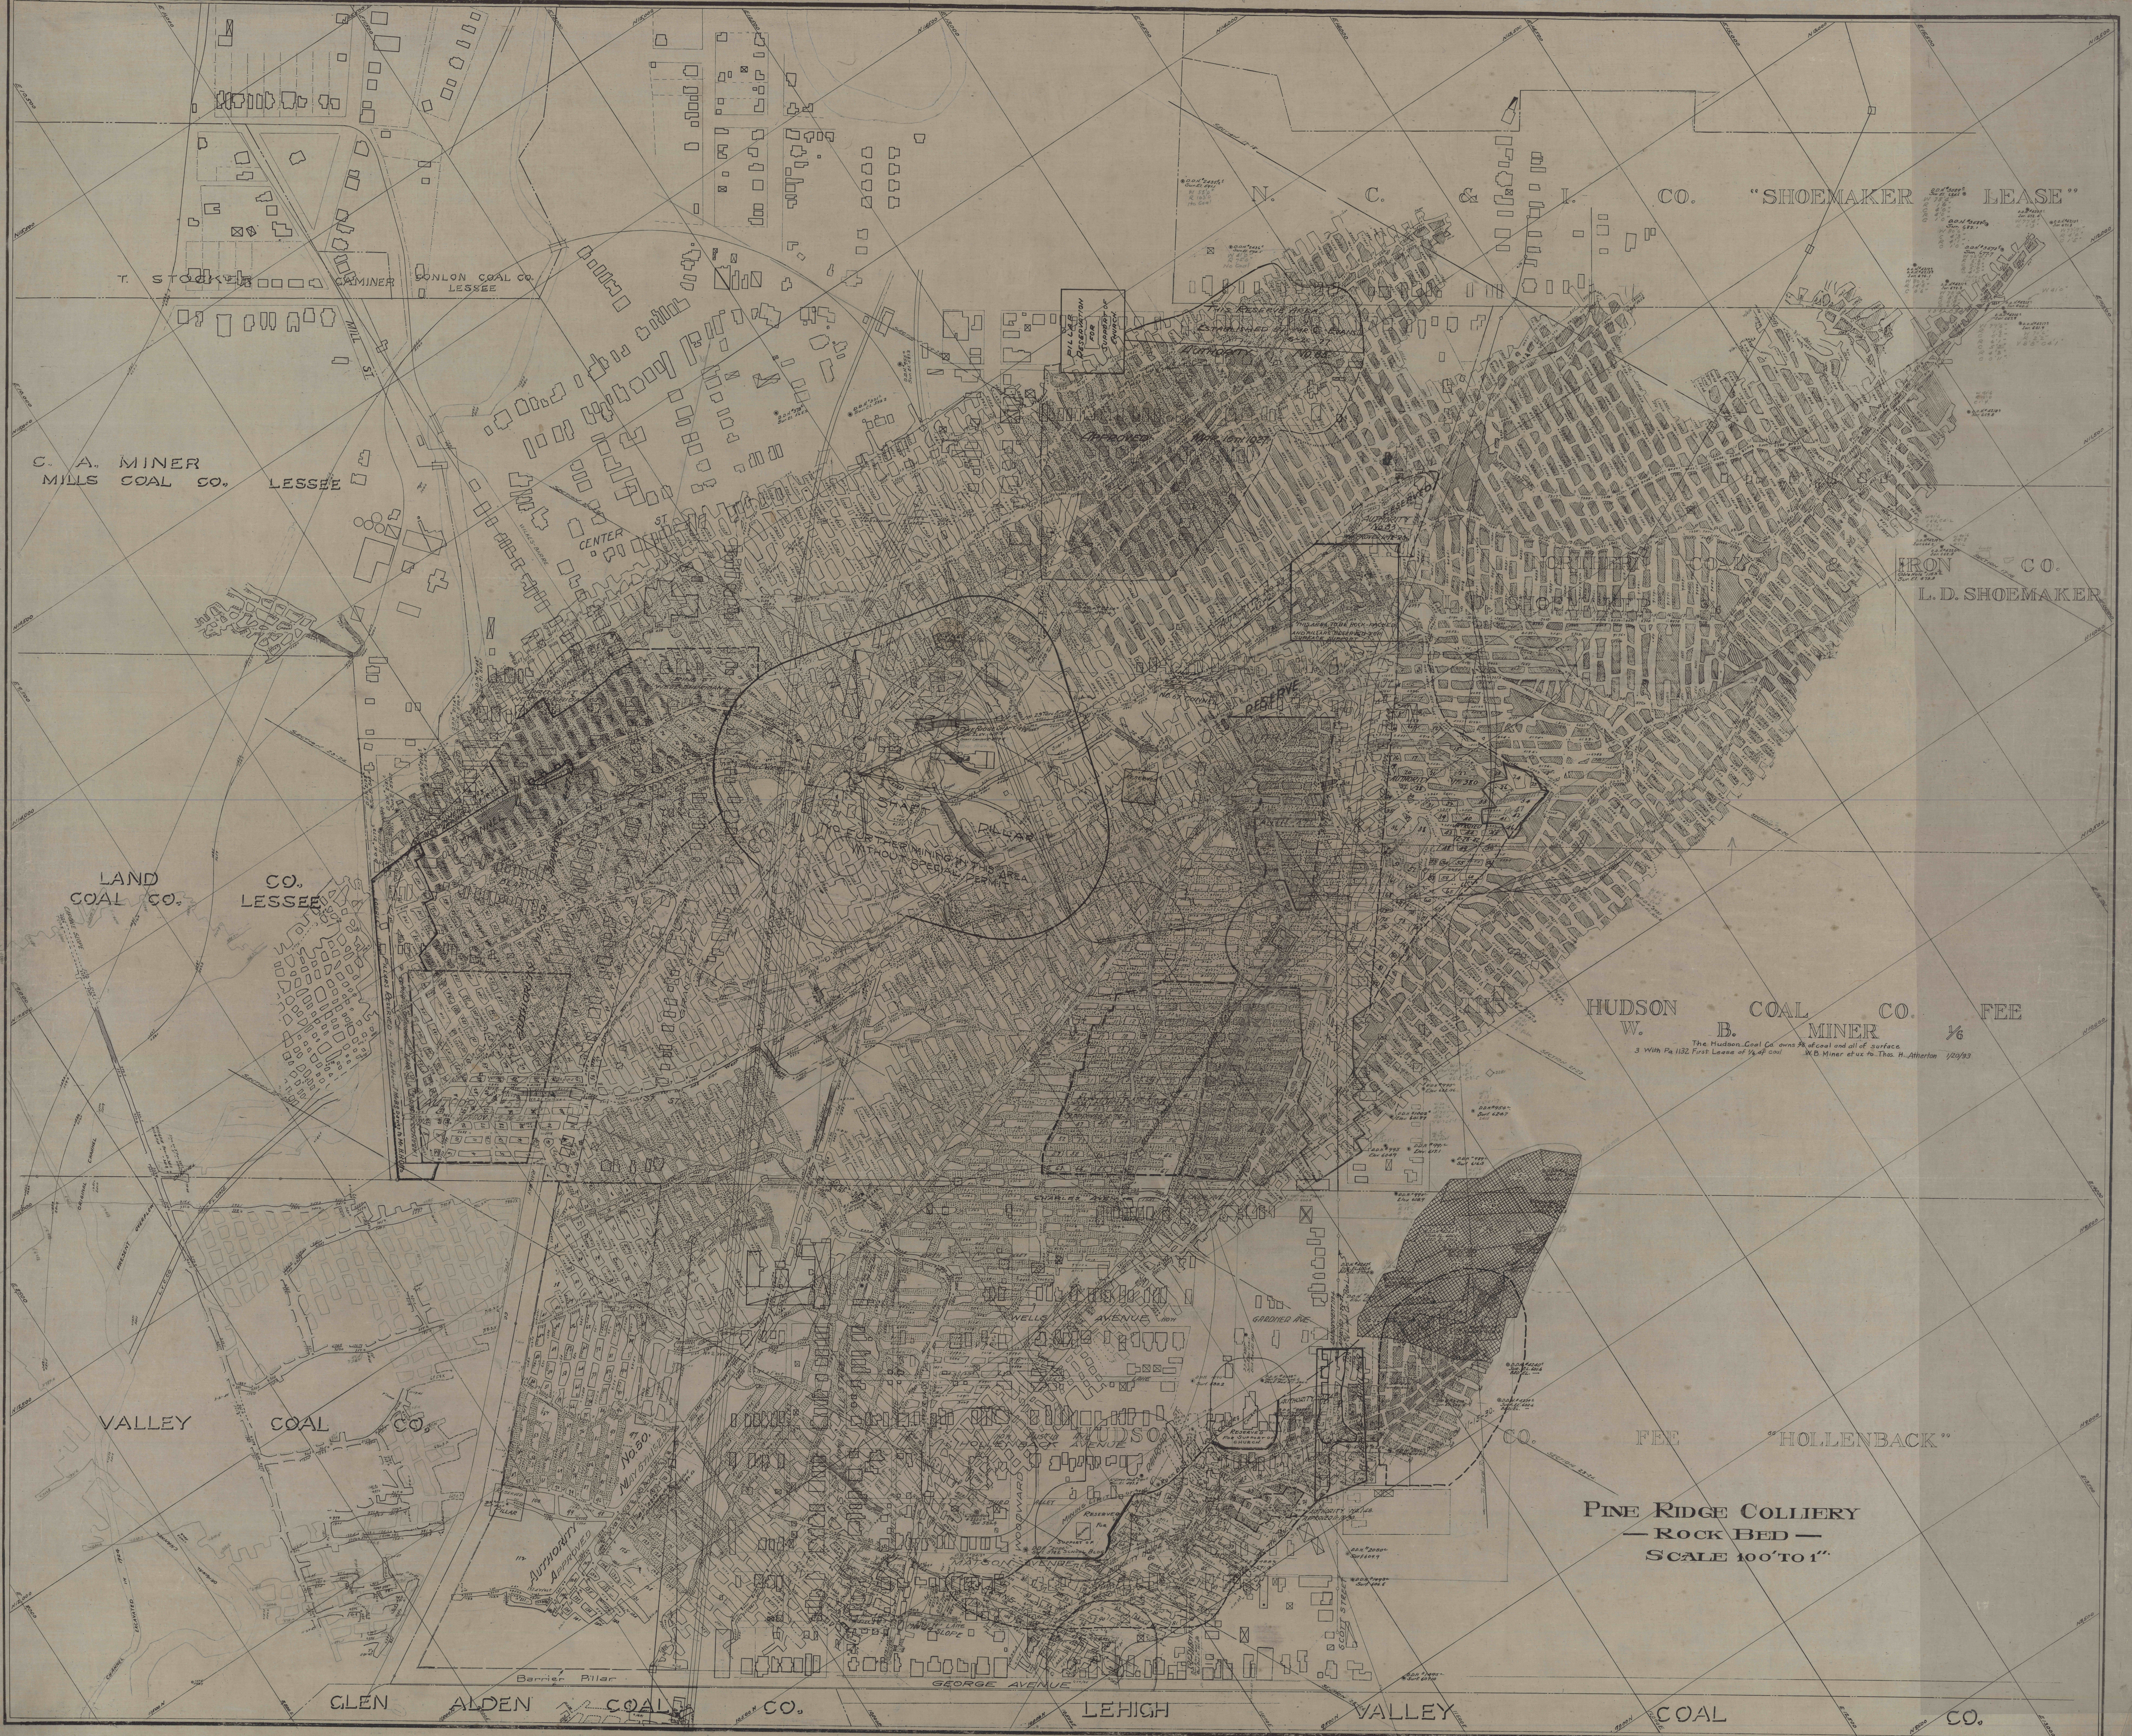

PINE RIDGE COLLIERY
— ROCK BED —
SCALE 100' TO 1"