


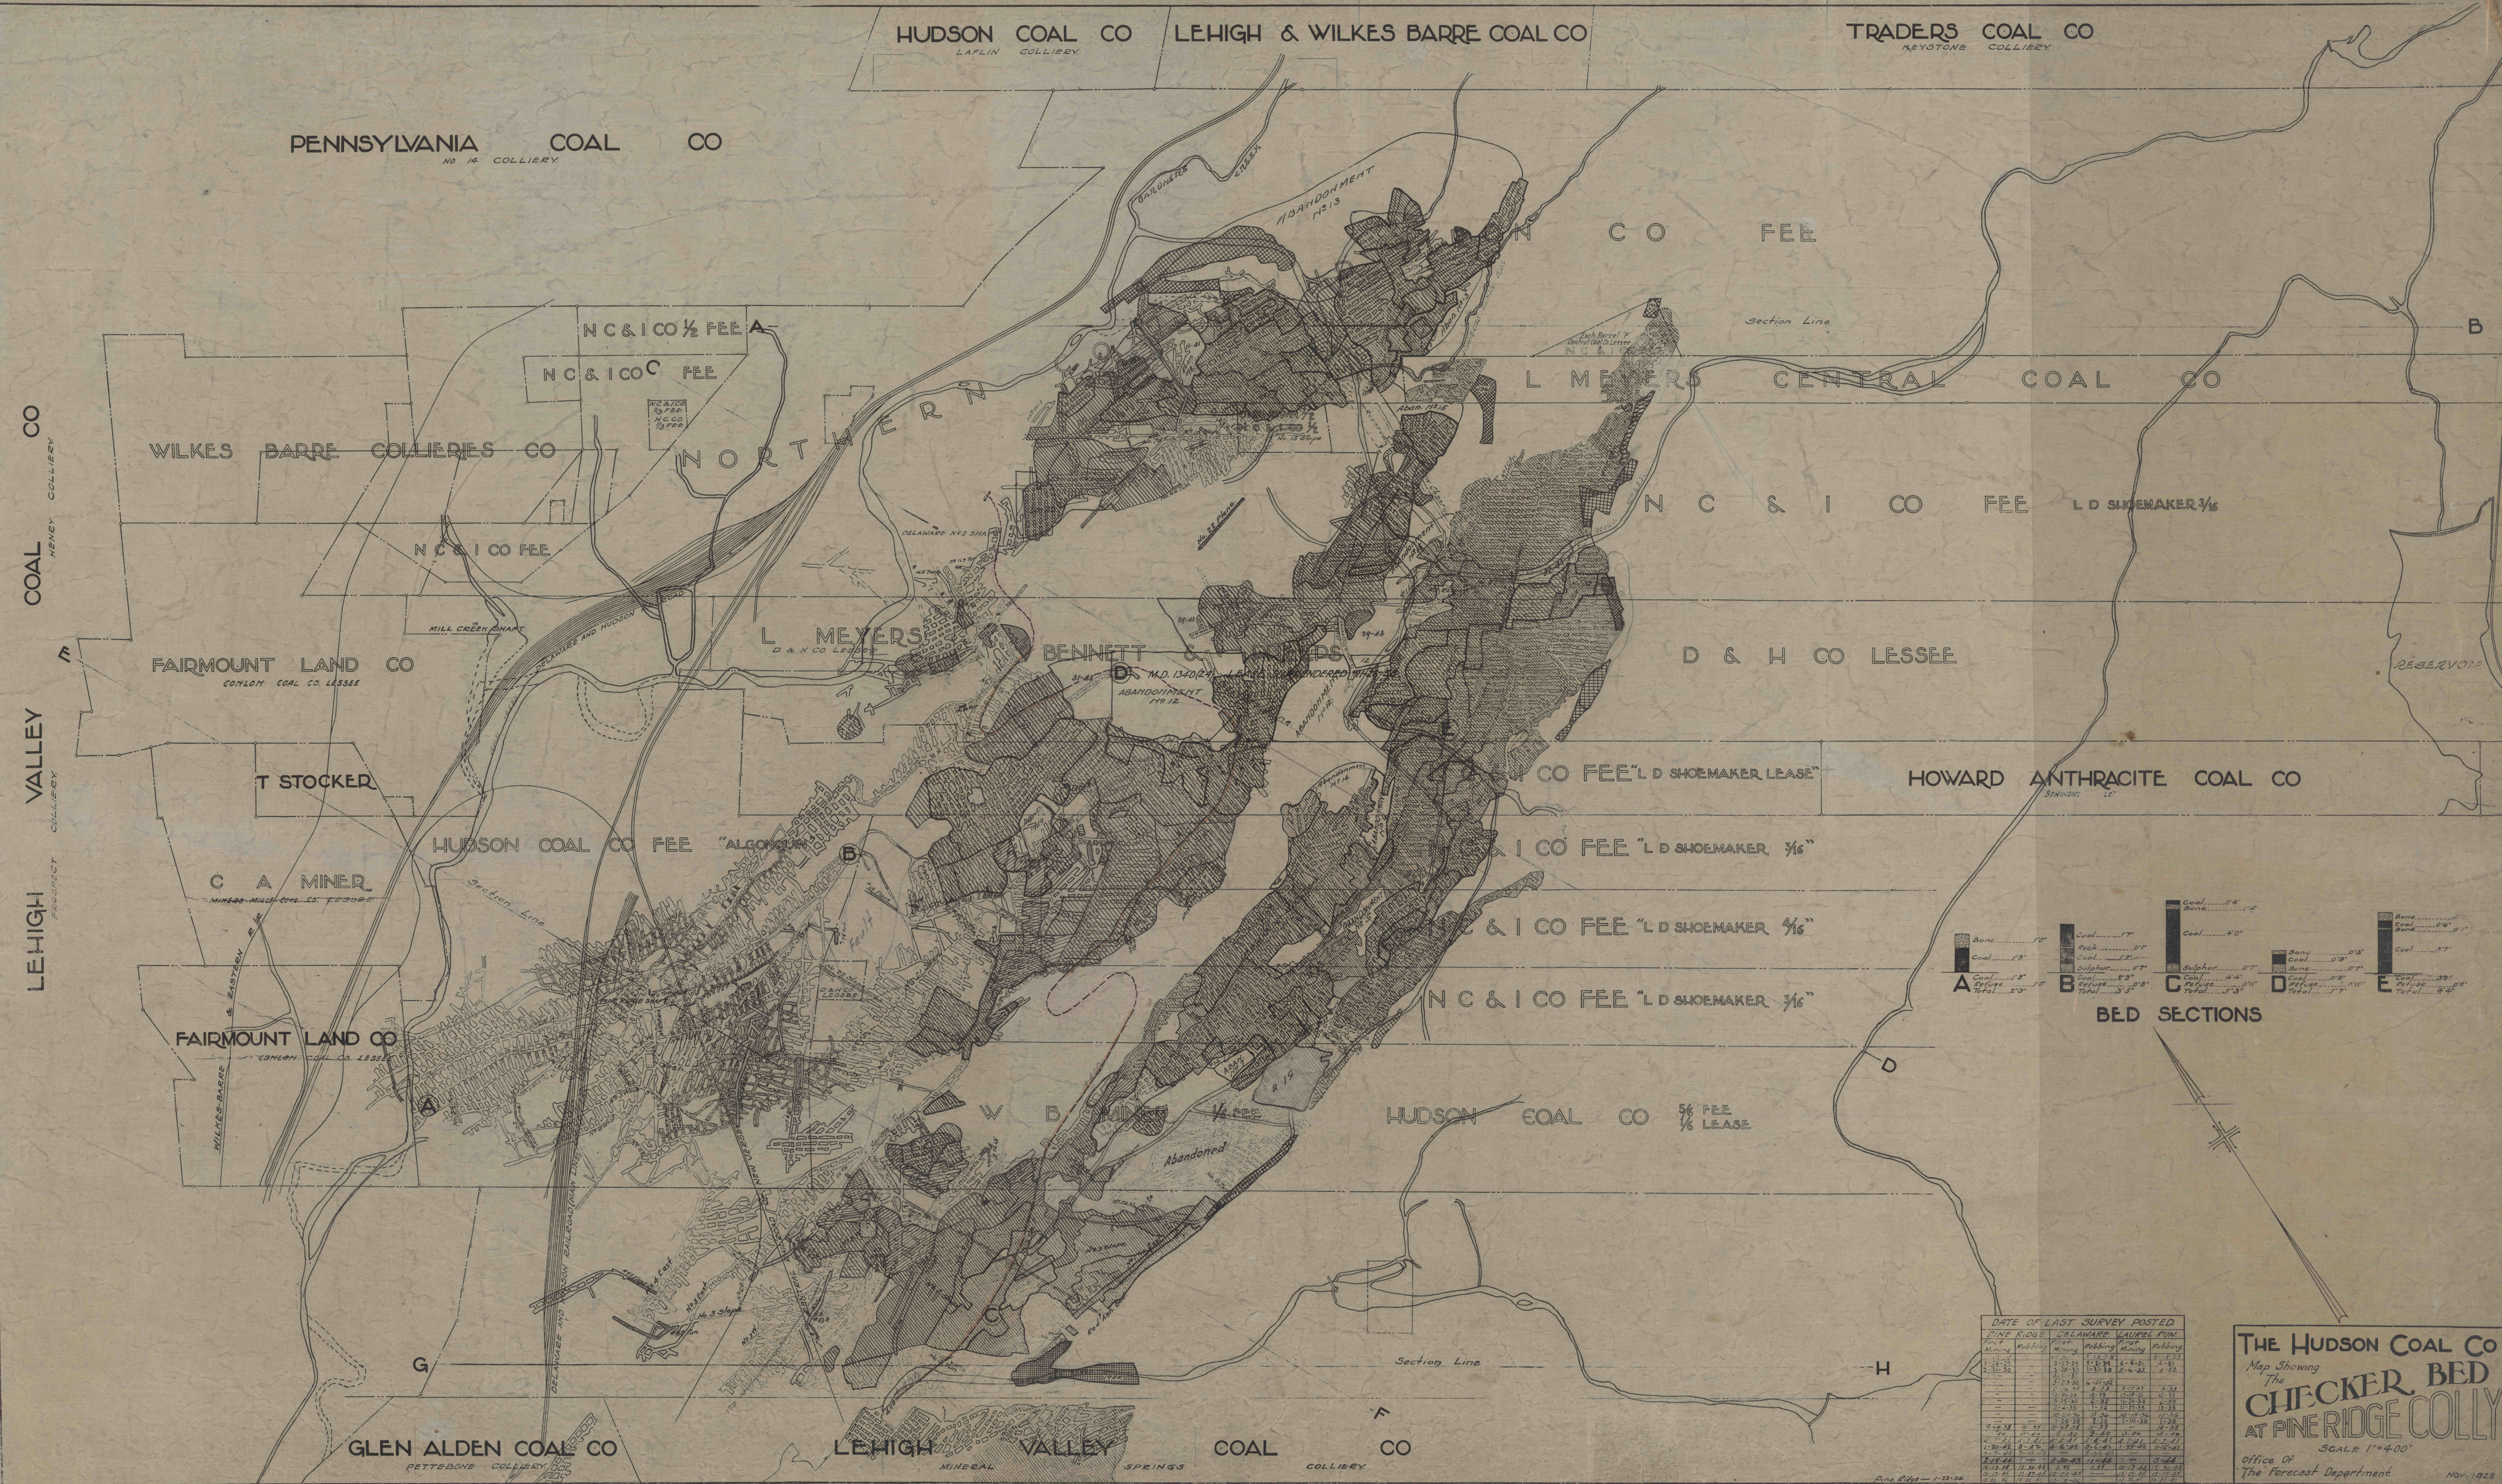

| DATE OF LAST SURVEY POSTED |           |          |           |             |           |
|----------------------------|-----------|----------|-----------|-------------|-----------|

THE HUDSON COAL CO  
Map Showing  
The  
CHECKER BED  
AT PINE RIDGE COLLY  
SCALE 1"=400'  
Office Of  
The Forecast Department  
Nov. 1925