


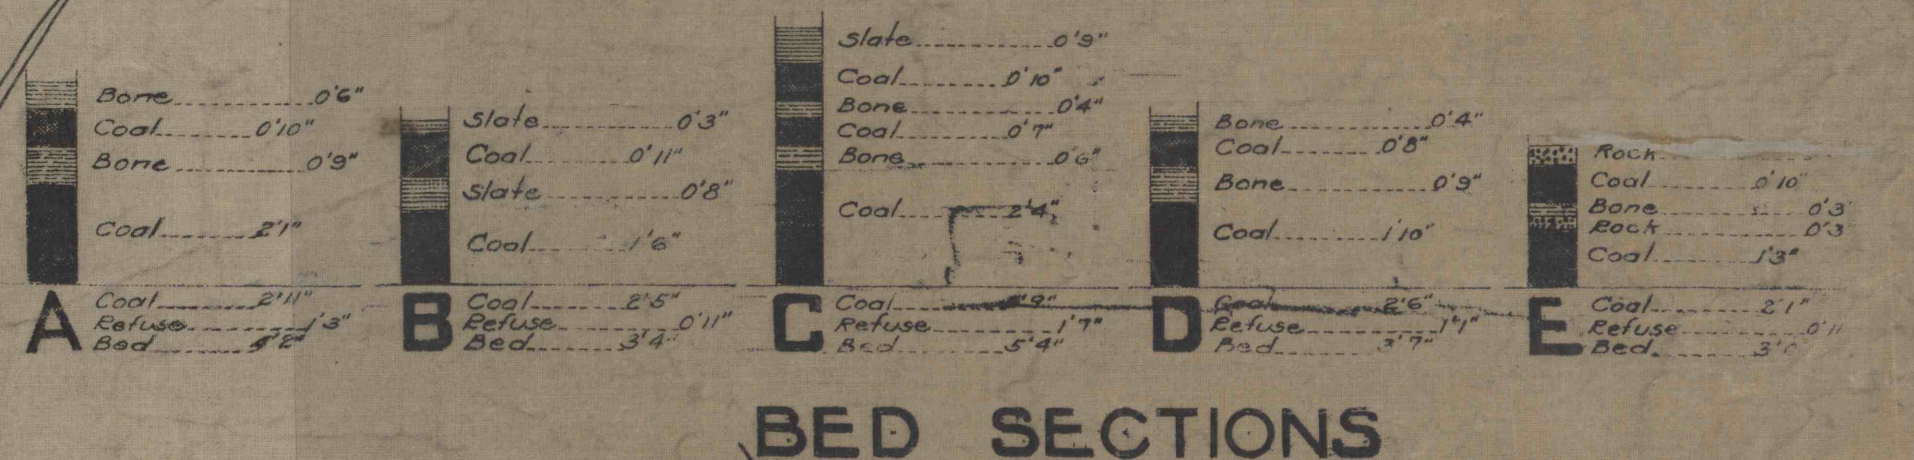

DATE OF LAST SURVEY POSTED									
THE HUDSON COAL CO
Map Showing
The
ROSS BED
AT PINE RIDGE COLLY
SCALE 1" = 400'
Office of
