


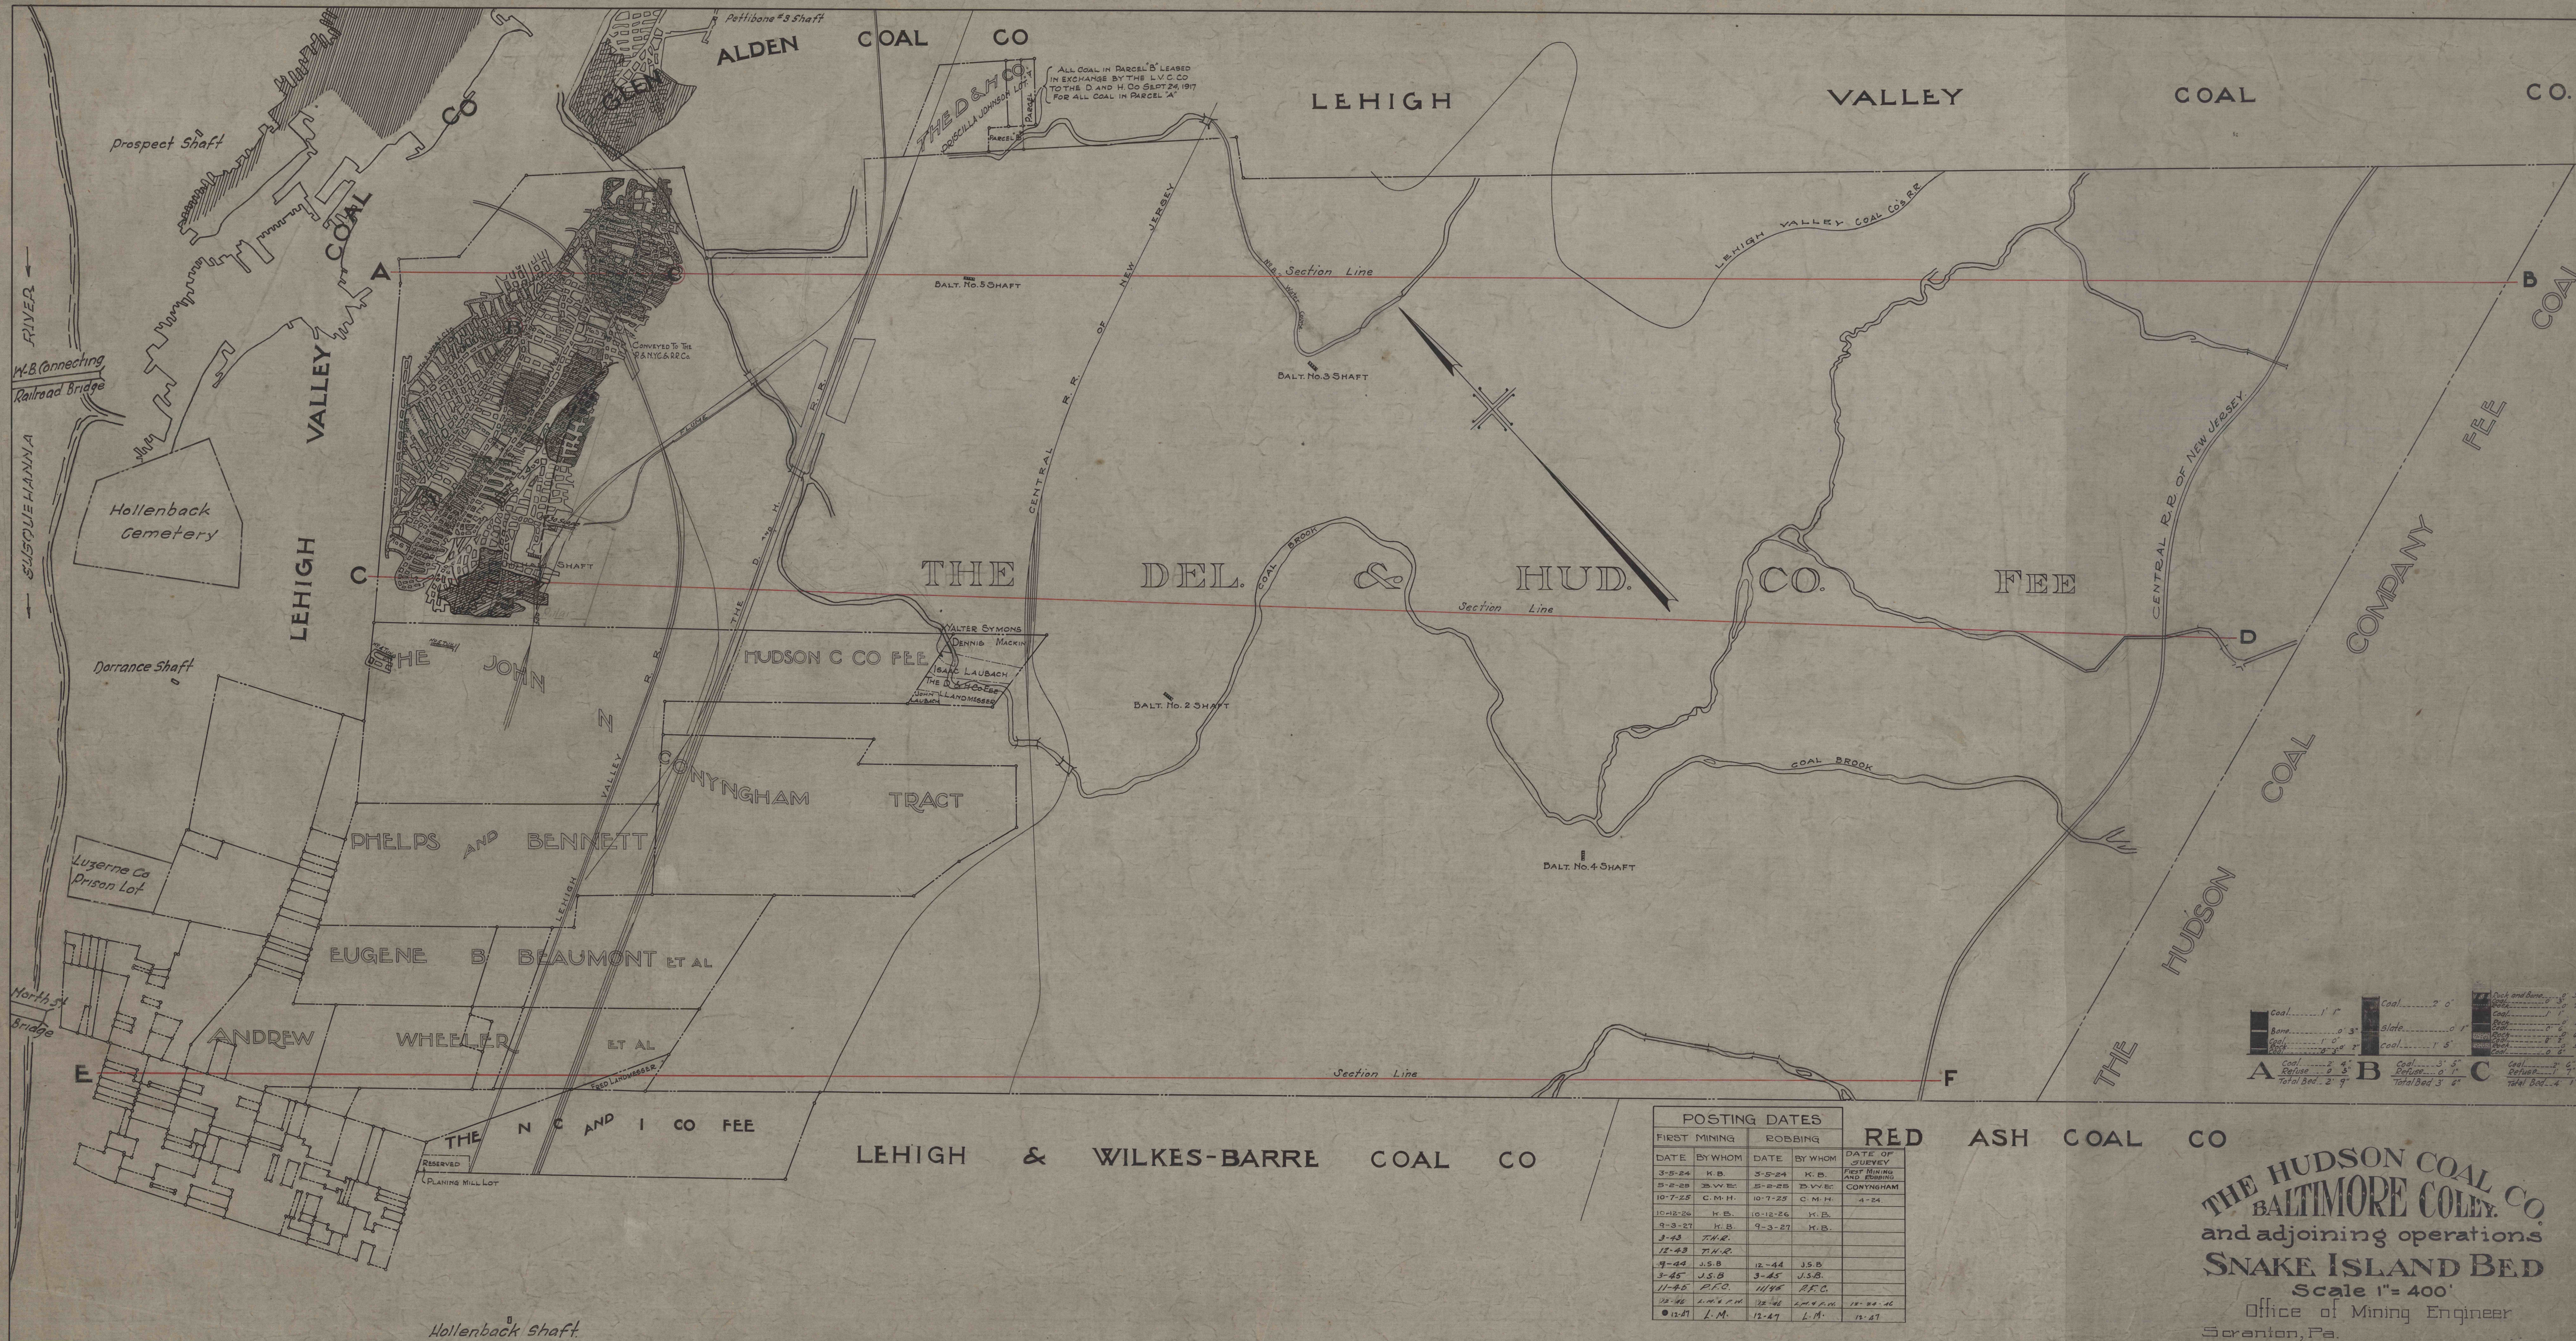

POSTING DATES					
FIRST MINING			ROBBING		
DATE	BY WHOM		DATE	BY WHOM	DATE OF SUEVEY
3-5-24	K.B.		3-5-24	K.B.	FIRST MINING
5-8-25	J.W.E.		5-8-25	D.V.E.	CONYNGHAM
10-7-25	C.M.H.		10-7-25	C.M.H.	4-24
10-12-26	K.B.		10-12-26	K.B.	
9-3-27	K.B.		9-3-27	K.B.	
3-23	T.H.R.				
12-43	T.H.R.				
9-44	J.S.B.		12-44	J.S.B.	
3-45	J.S.B.		3-45	J.S.B.	
11-45	P.F.C.		11-45	P.F.C.	
12-46	L.M.		12-46	L.M.	
12-47	L.M.		12-47	L.M.	

RED ASH COAL CO
THE HUDSON COAL CO.
BALTIMORE COLEY CO.
and adjoining operations
SNAKE ISLAND BED
Scale 1"= 400'
Office of Mining Engineer
Scranton, Pa.
April 1925