


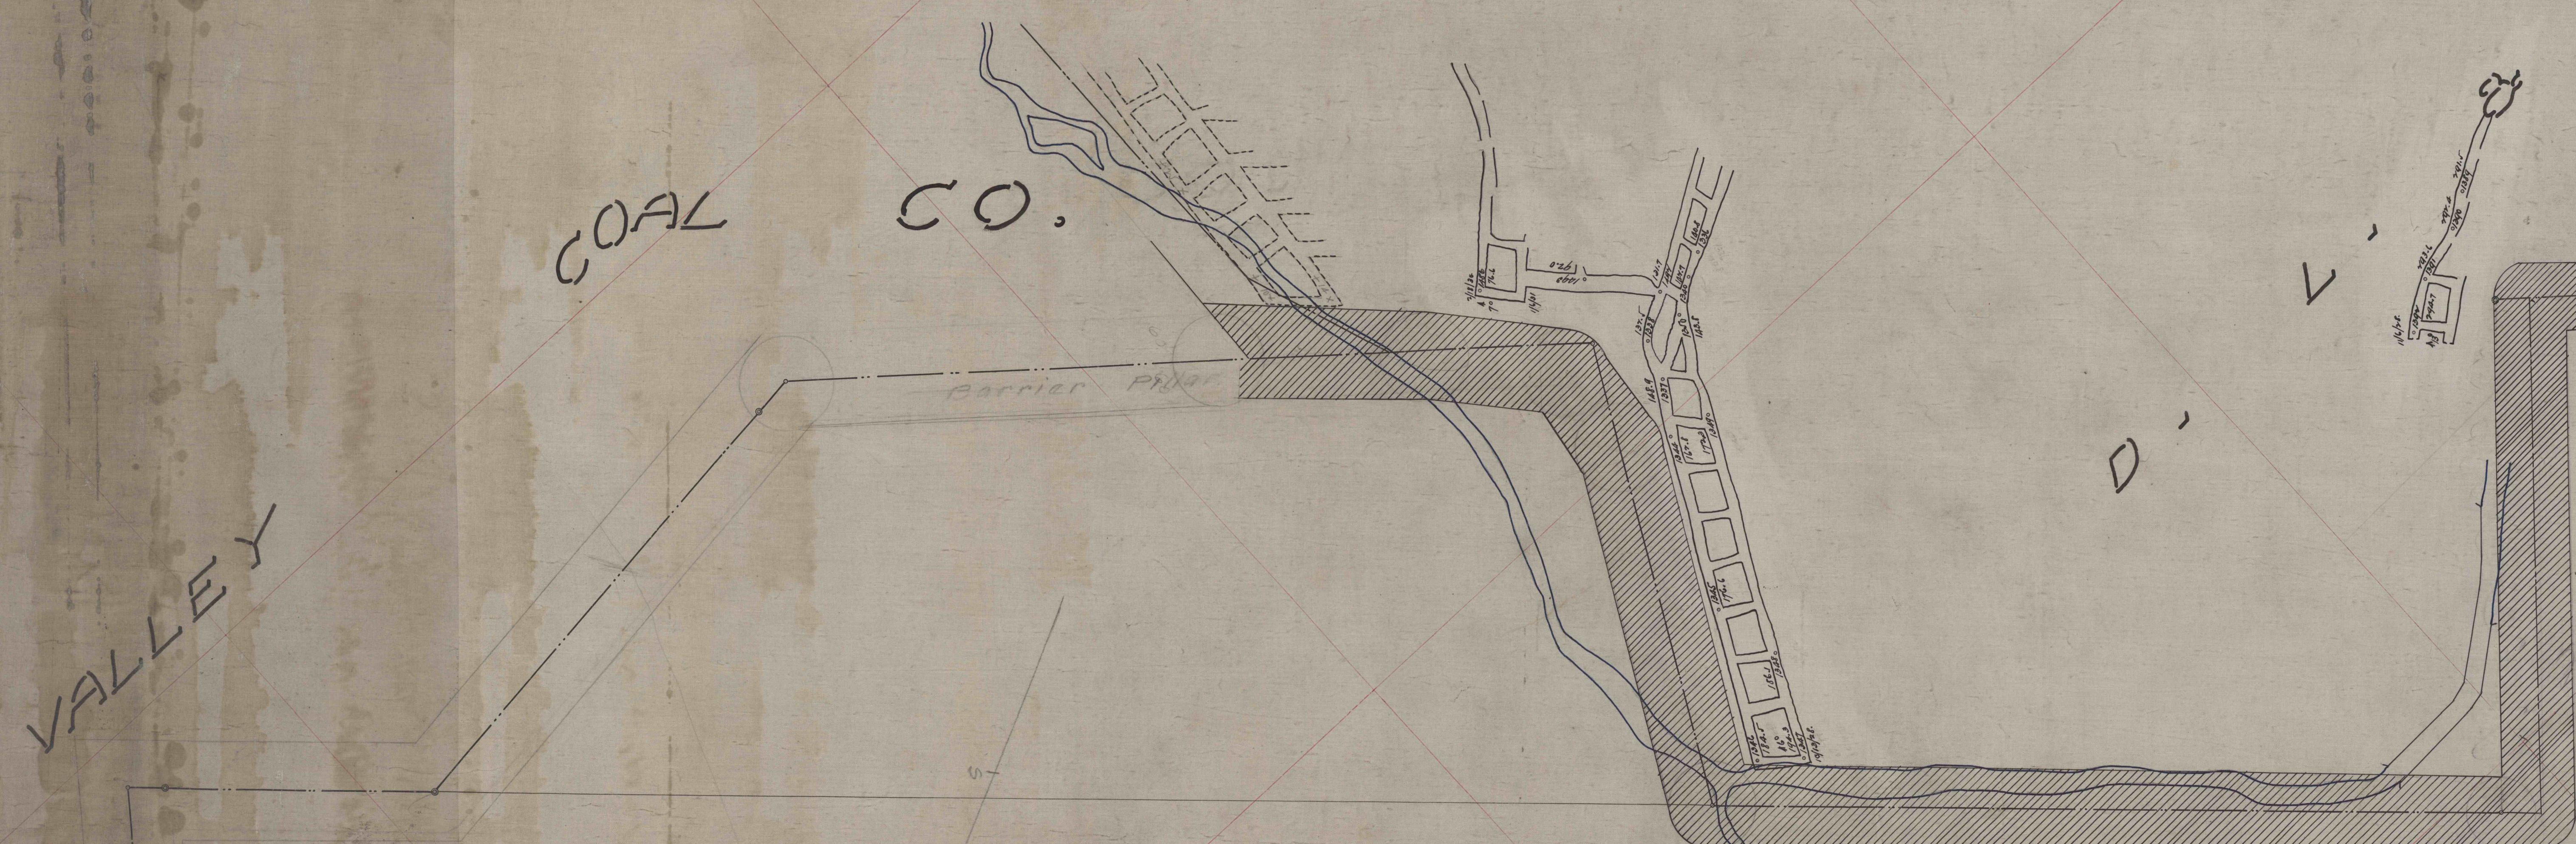

R. R. CO.
W.
PRISCILLA JOHNSON
THE D & H COAL CO. FEE
M.D. 1890
Exchange Coal Lease
L.V.C. Co. To
The D & H Co.

SHAFT RESERVATION.
NO FURTHER MINING
WITHOUT SP AUTHORITY.

DELAWARE

AND

HUDSON

CO.



SHAFT RESERVATION
NO FURTHER MINING
ON EST. CO. LINES

THE HUDSON COAL CO.

D. MACKIN