


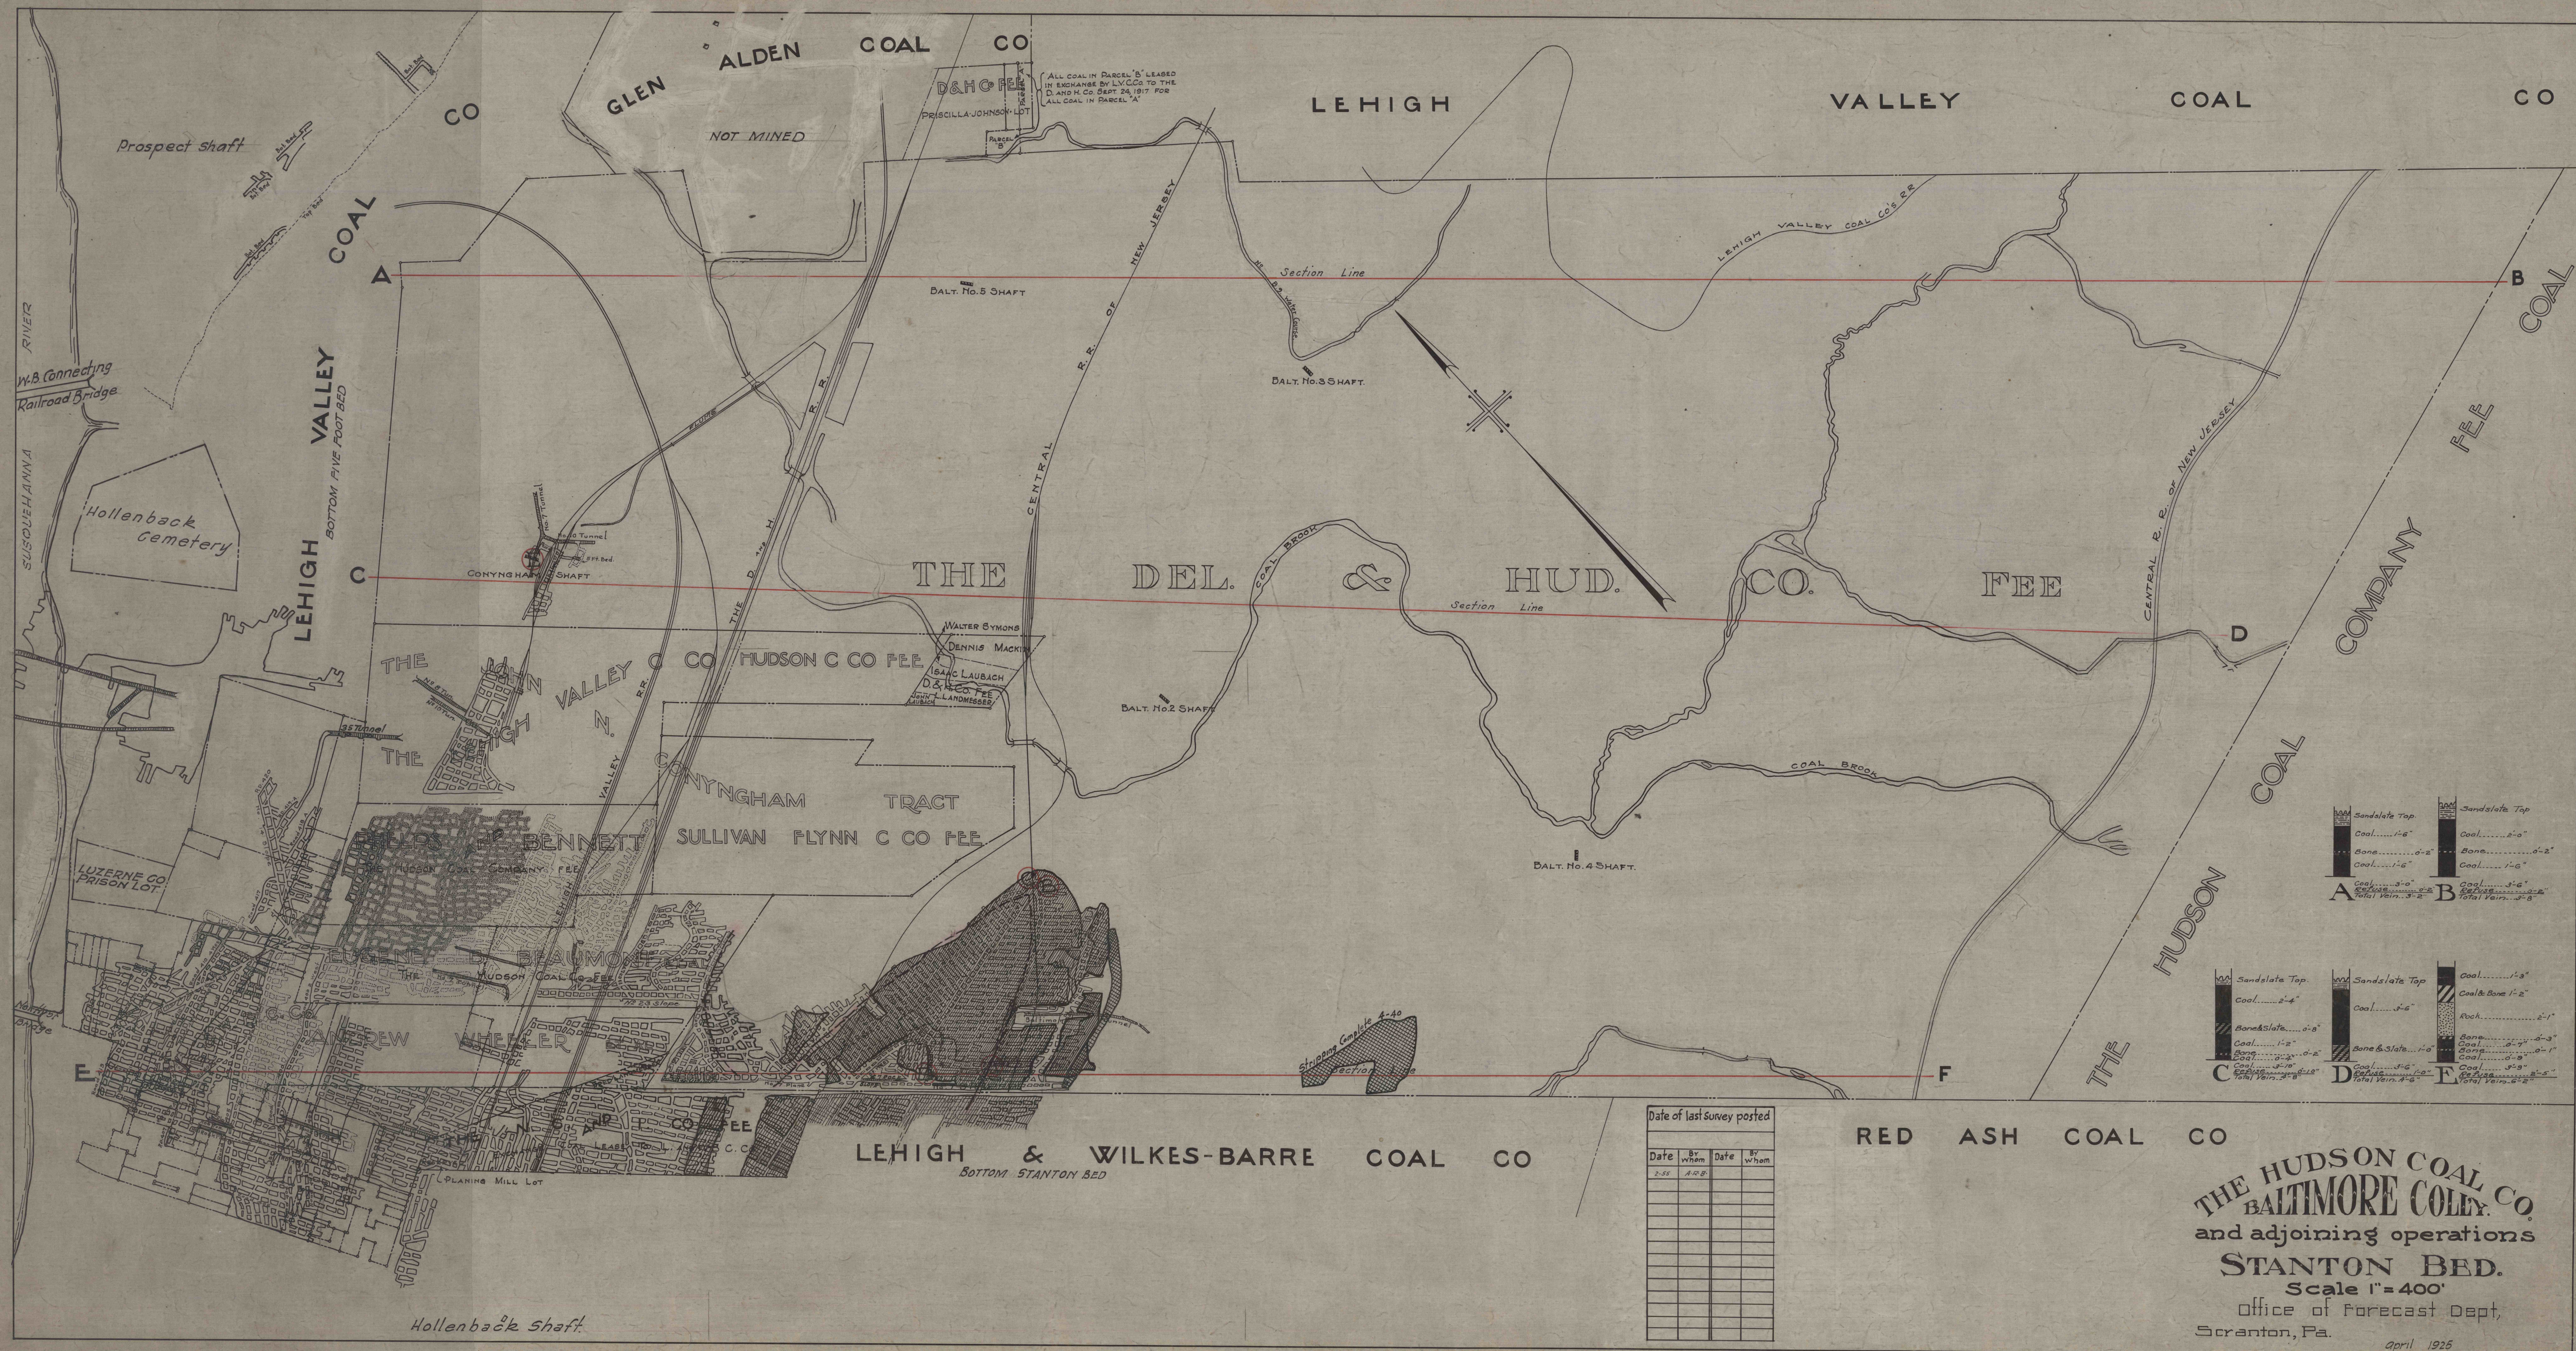

April 1928