


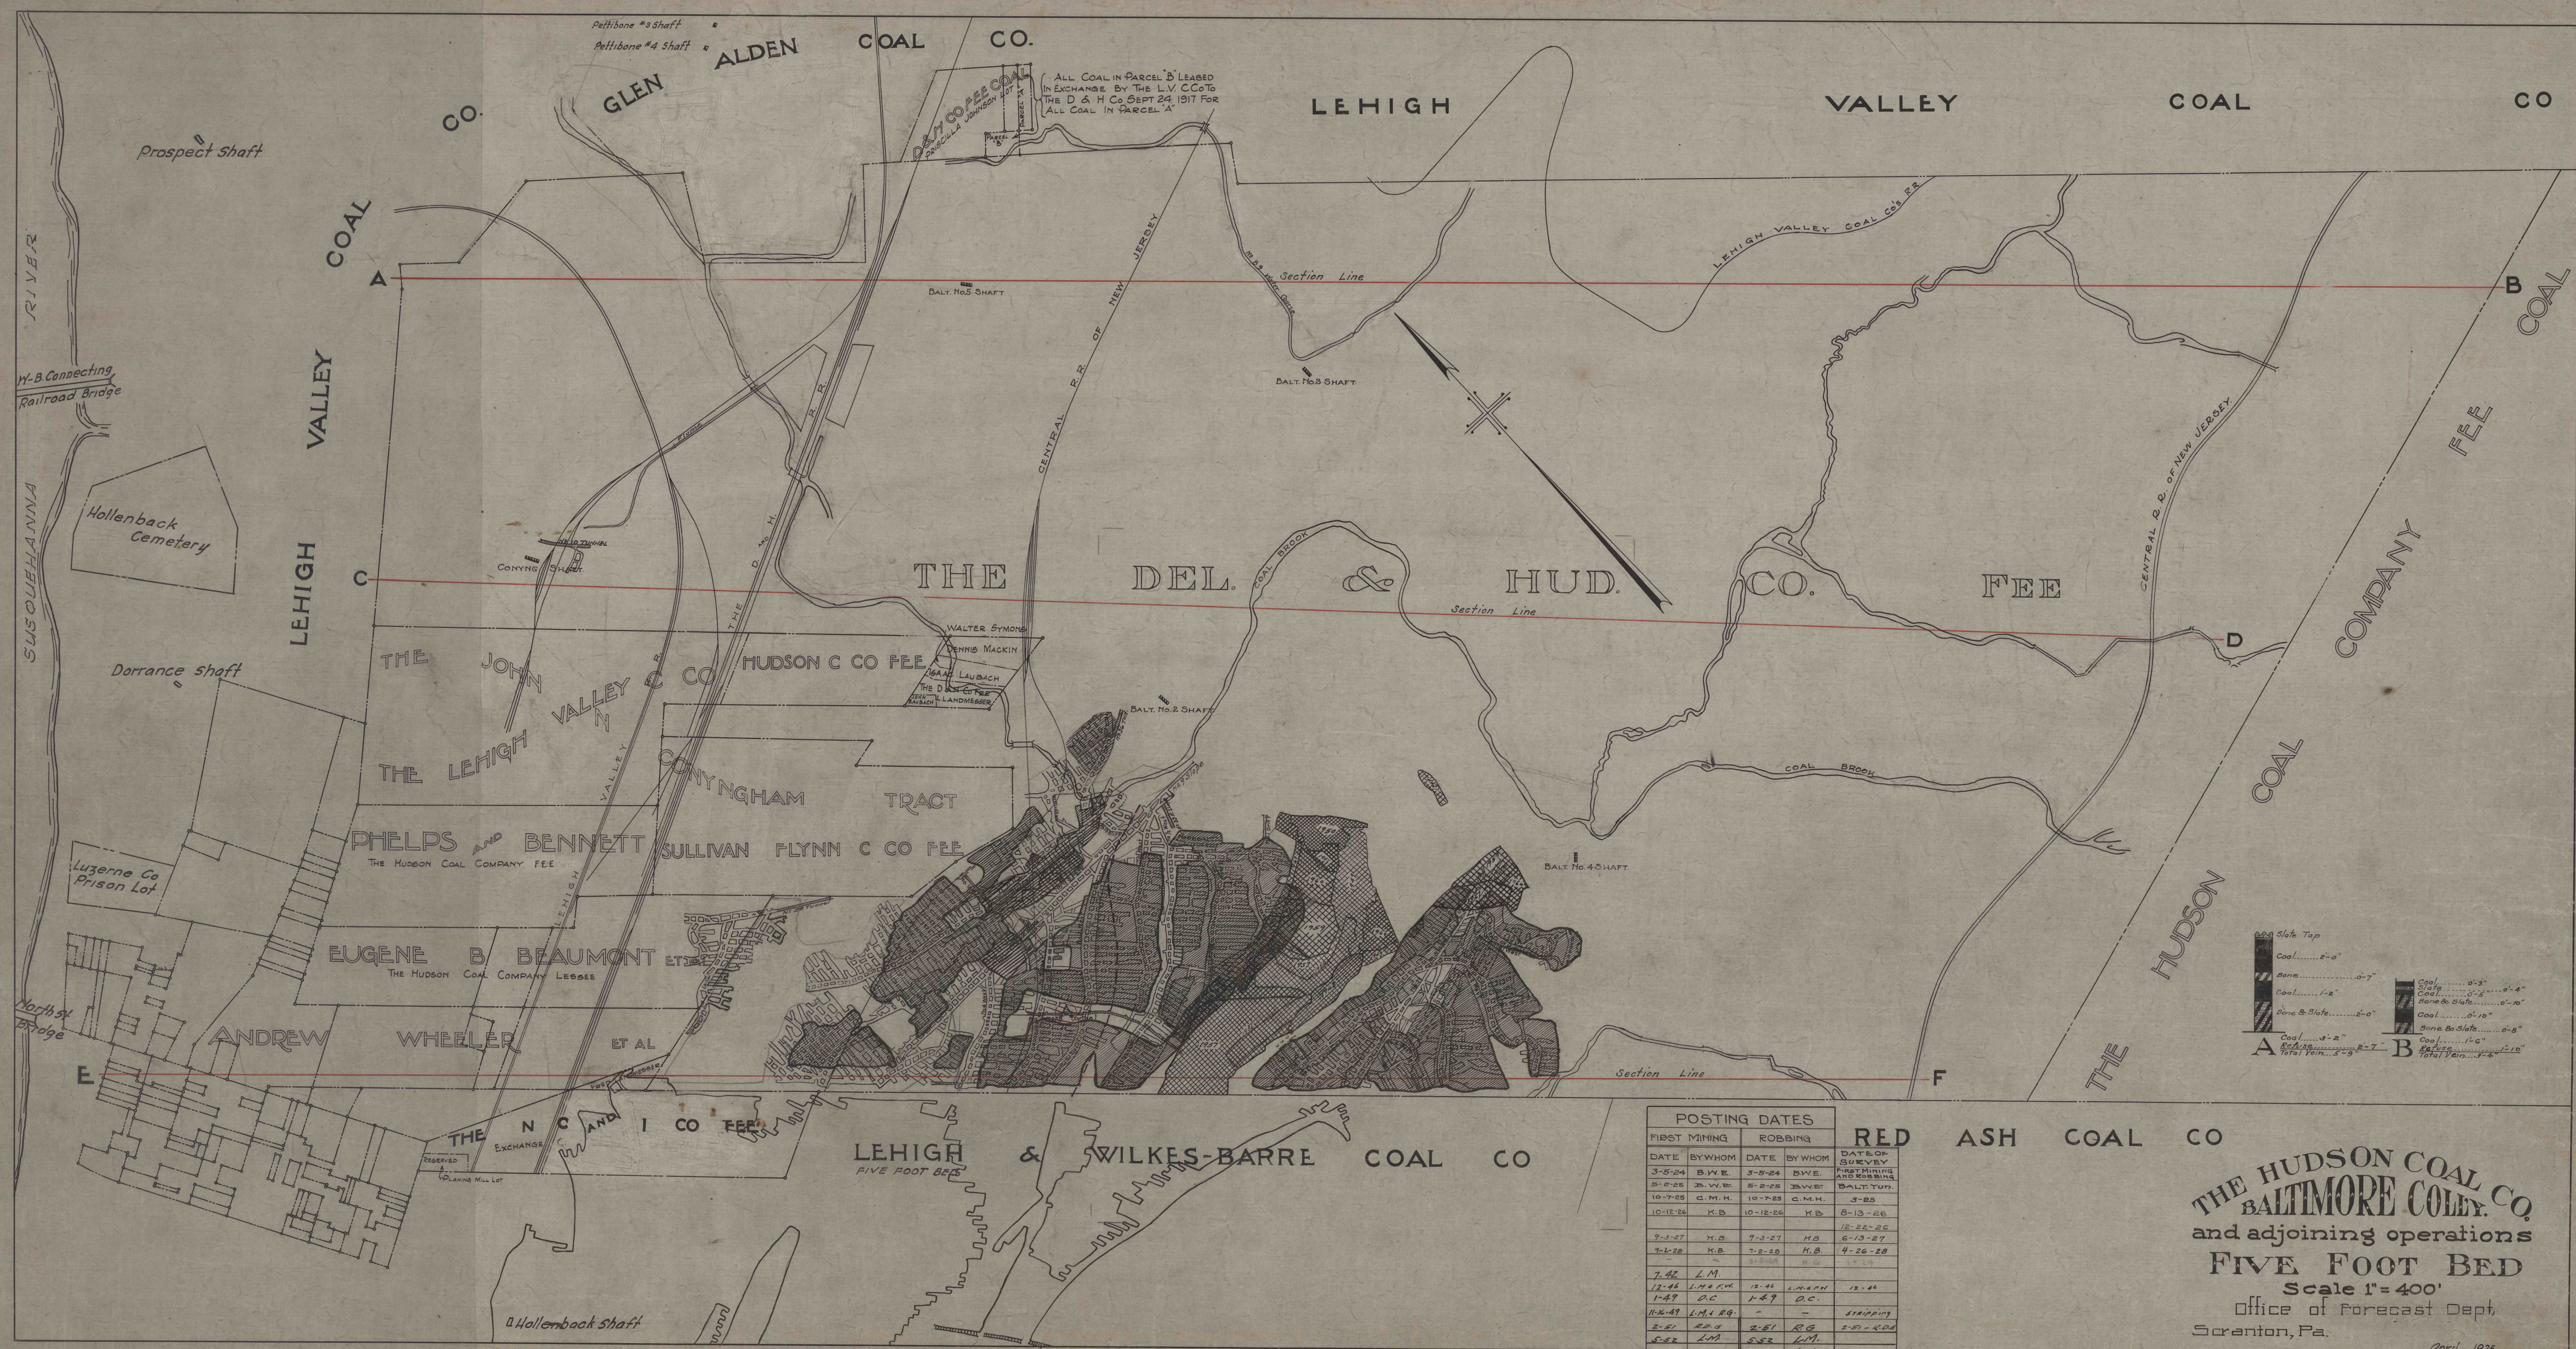

POSTING DATES			
FIRST MINING		ROBBING	
DATE	BY WHOM	DATE	BY WHOM
3-5-24	B.W.E.	3-5-24	B.W.E.
5-2-25	B.W.E.	5-2-25	B.W.E.
10-7-25	C.M.H.	10-7-25	C.M.H.
10-12-26	K.B.	10-12-26	K.B.
2-51	R.G.	2-51	R.G.
5-52	L.M.	5-52	L.M.
2-53	L.M.		

RED ASH COAL CO

THE HUDSON COAL CO.
BALTIMORE COLEY. CO.
and adjoining operations
FIVE FOOT BED
Scale 1"=400'
Office of Forecast Dept.
Scranton, Pa.
April 1925