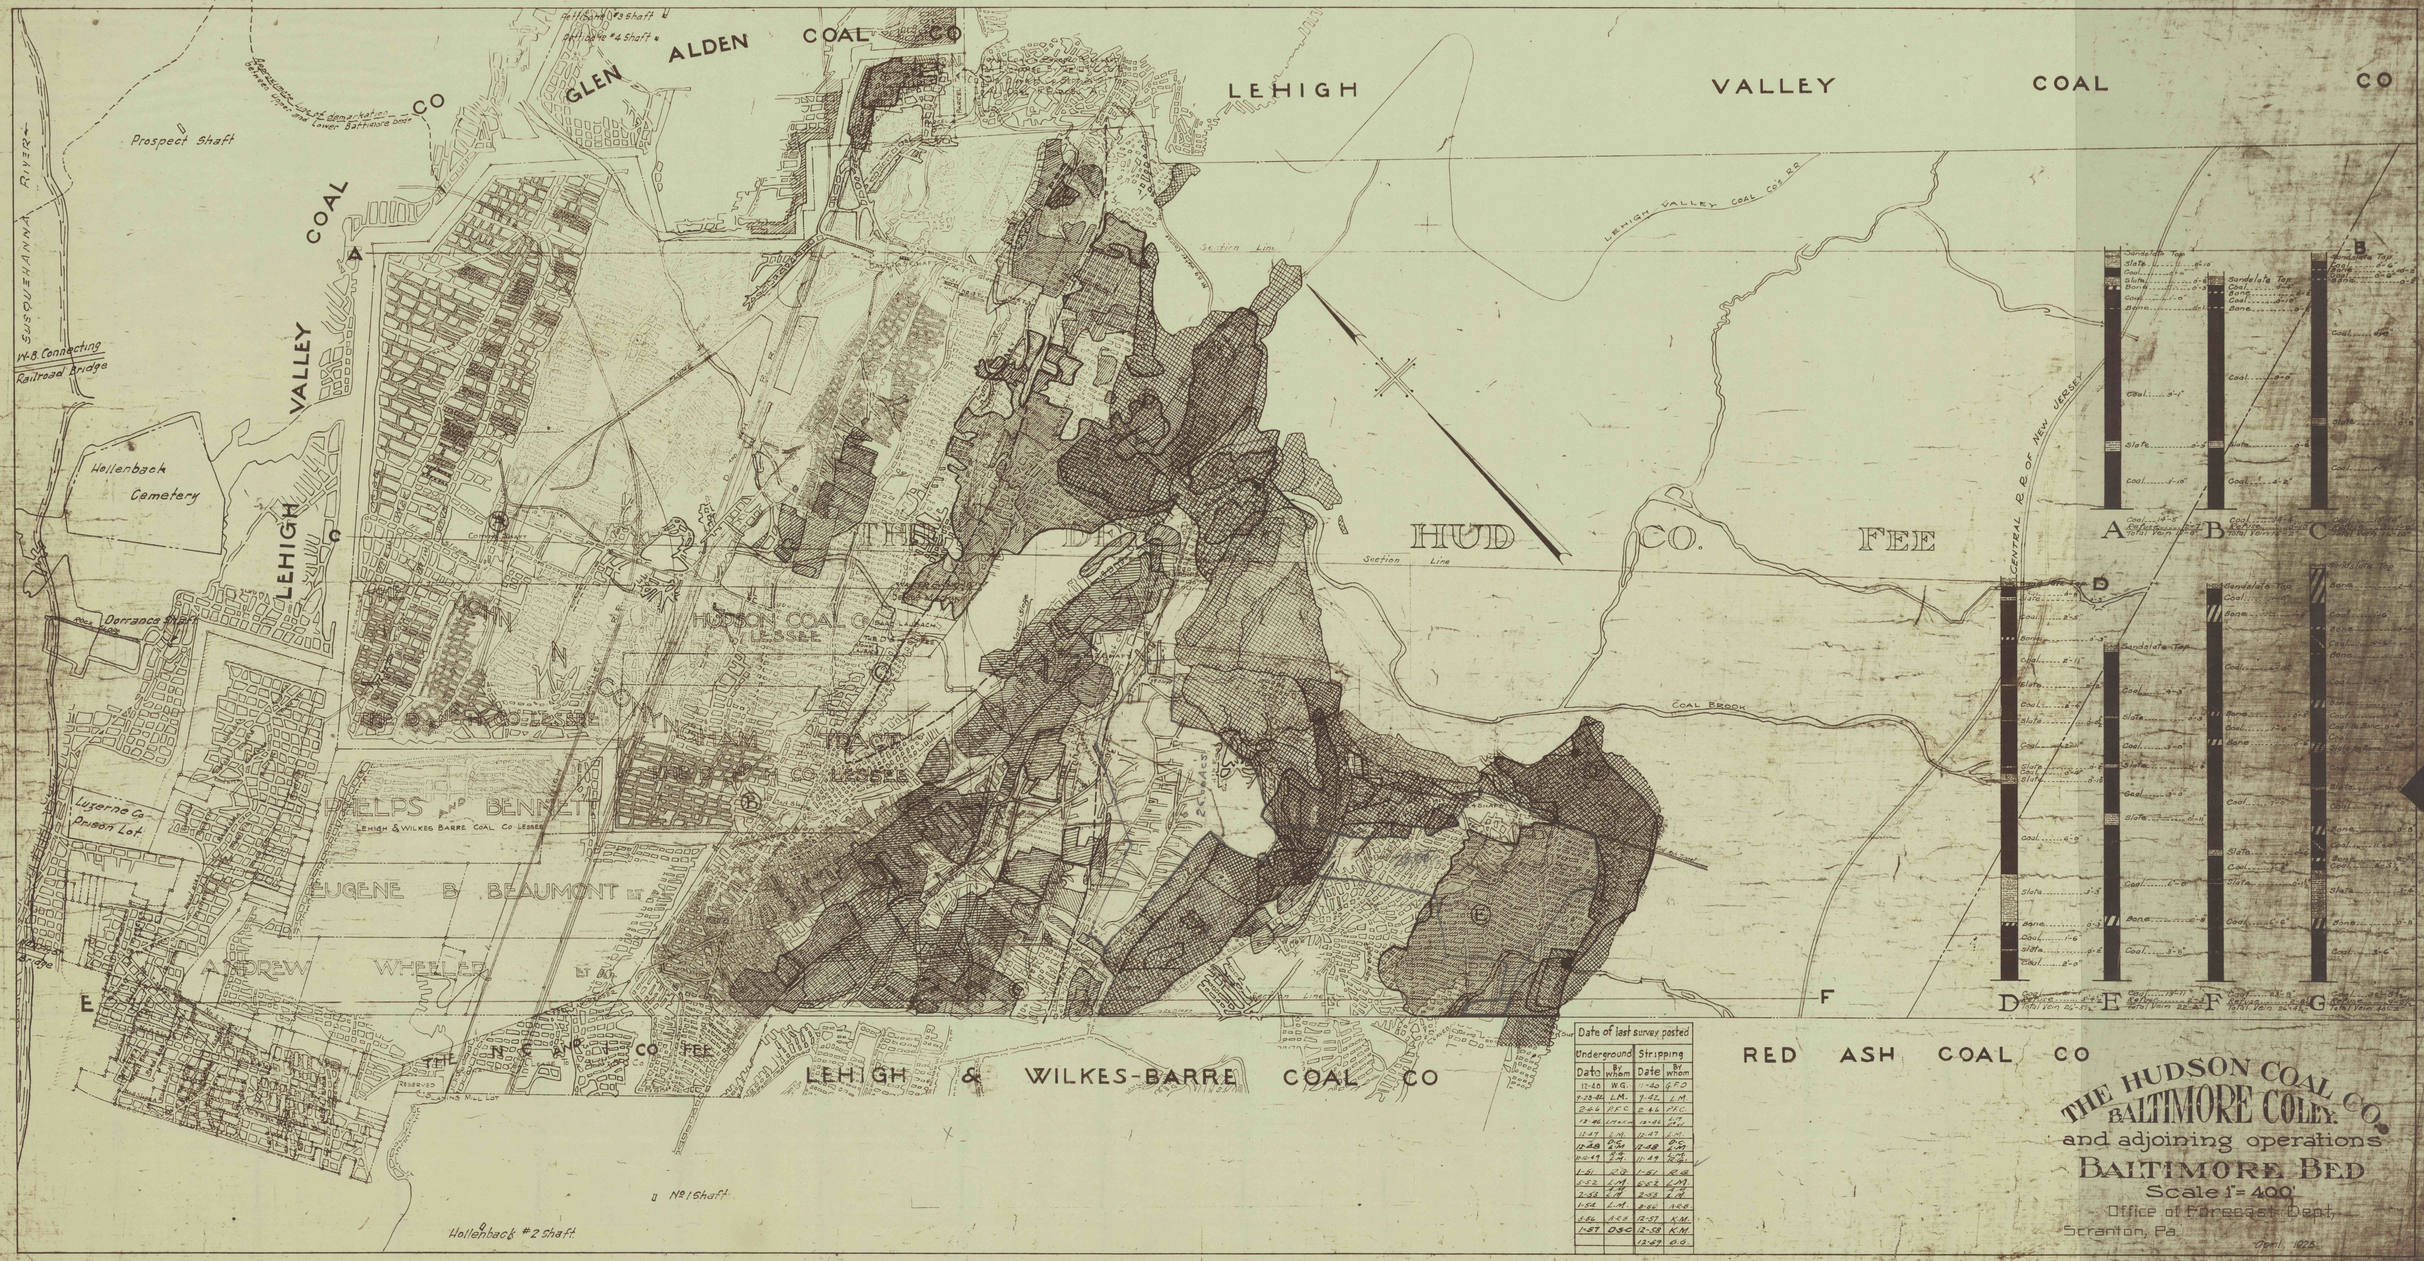
GLEN ALDEN COAL CO
LEHIGH VALLEY COAL CO
LEHIGH VALLEY COAL CO
Prospect Shaft
SUSQUEHANNA RIVER
N.B. Connecting Railroad Bridge
Hollenback Cemetery
Darrance Shaft
Luzerne Co. Prison Lot
HUD CO. FEE
HUDSON COAL CO LESSEE
PHELPS AND BENNETT
LEHIGH & WILKES BARRE COAL CO LESSEE
EUGENE B. BEAUMONT ET AL
ANDREW WHEELER ET AL
THE N.C.R.R. CO. FEE
LEHIGH & WILKES-BARRE COAL CO
RED ASH COAL CO
CENTRAL R.R. OF NEW JERSEY
COAL BROOK
Section Line
No 1 Shaft
Hollenback #2 Shaft
Date of last survey posted
Underground
Stripping
Date
By whom
THE HUDSON COAL CO.
BALTIMORE COLLY.
and adjoining operations
BALTIMORE BED
Scale 1" = 400'
Office of Foreman Dept.
Scranton, Pa.
April 1925