
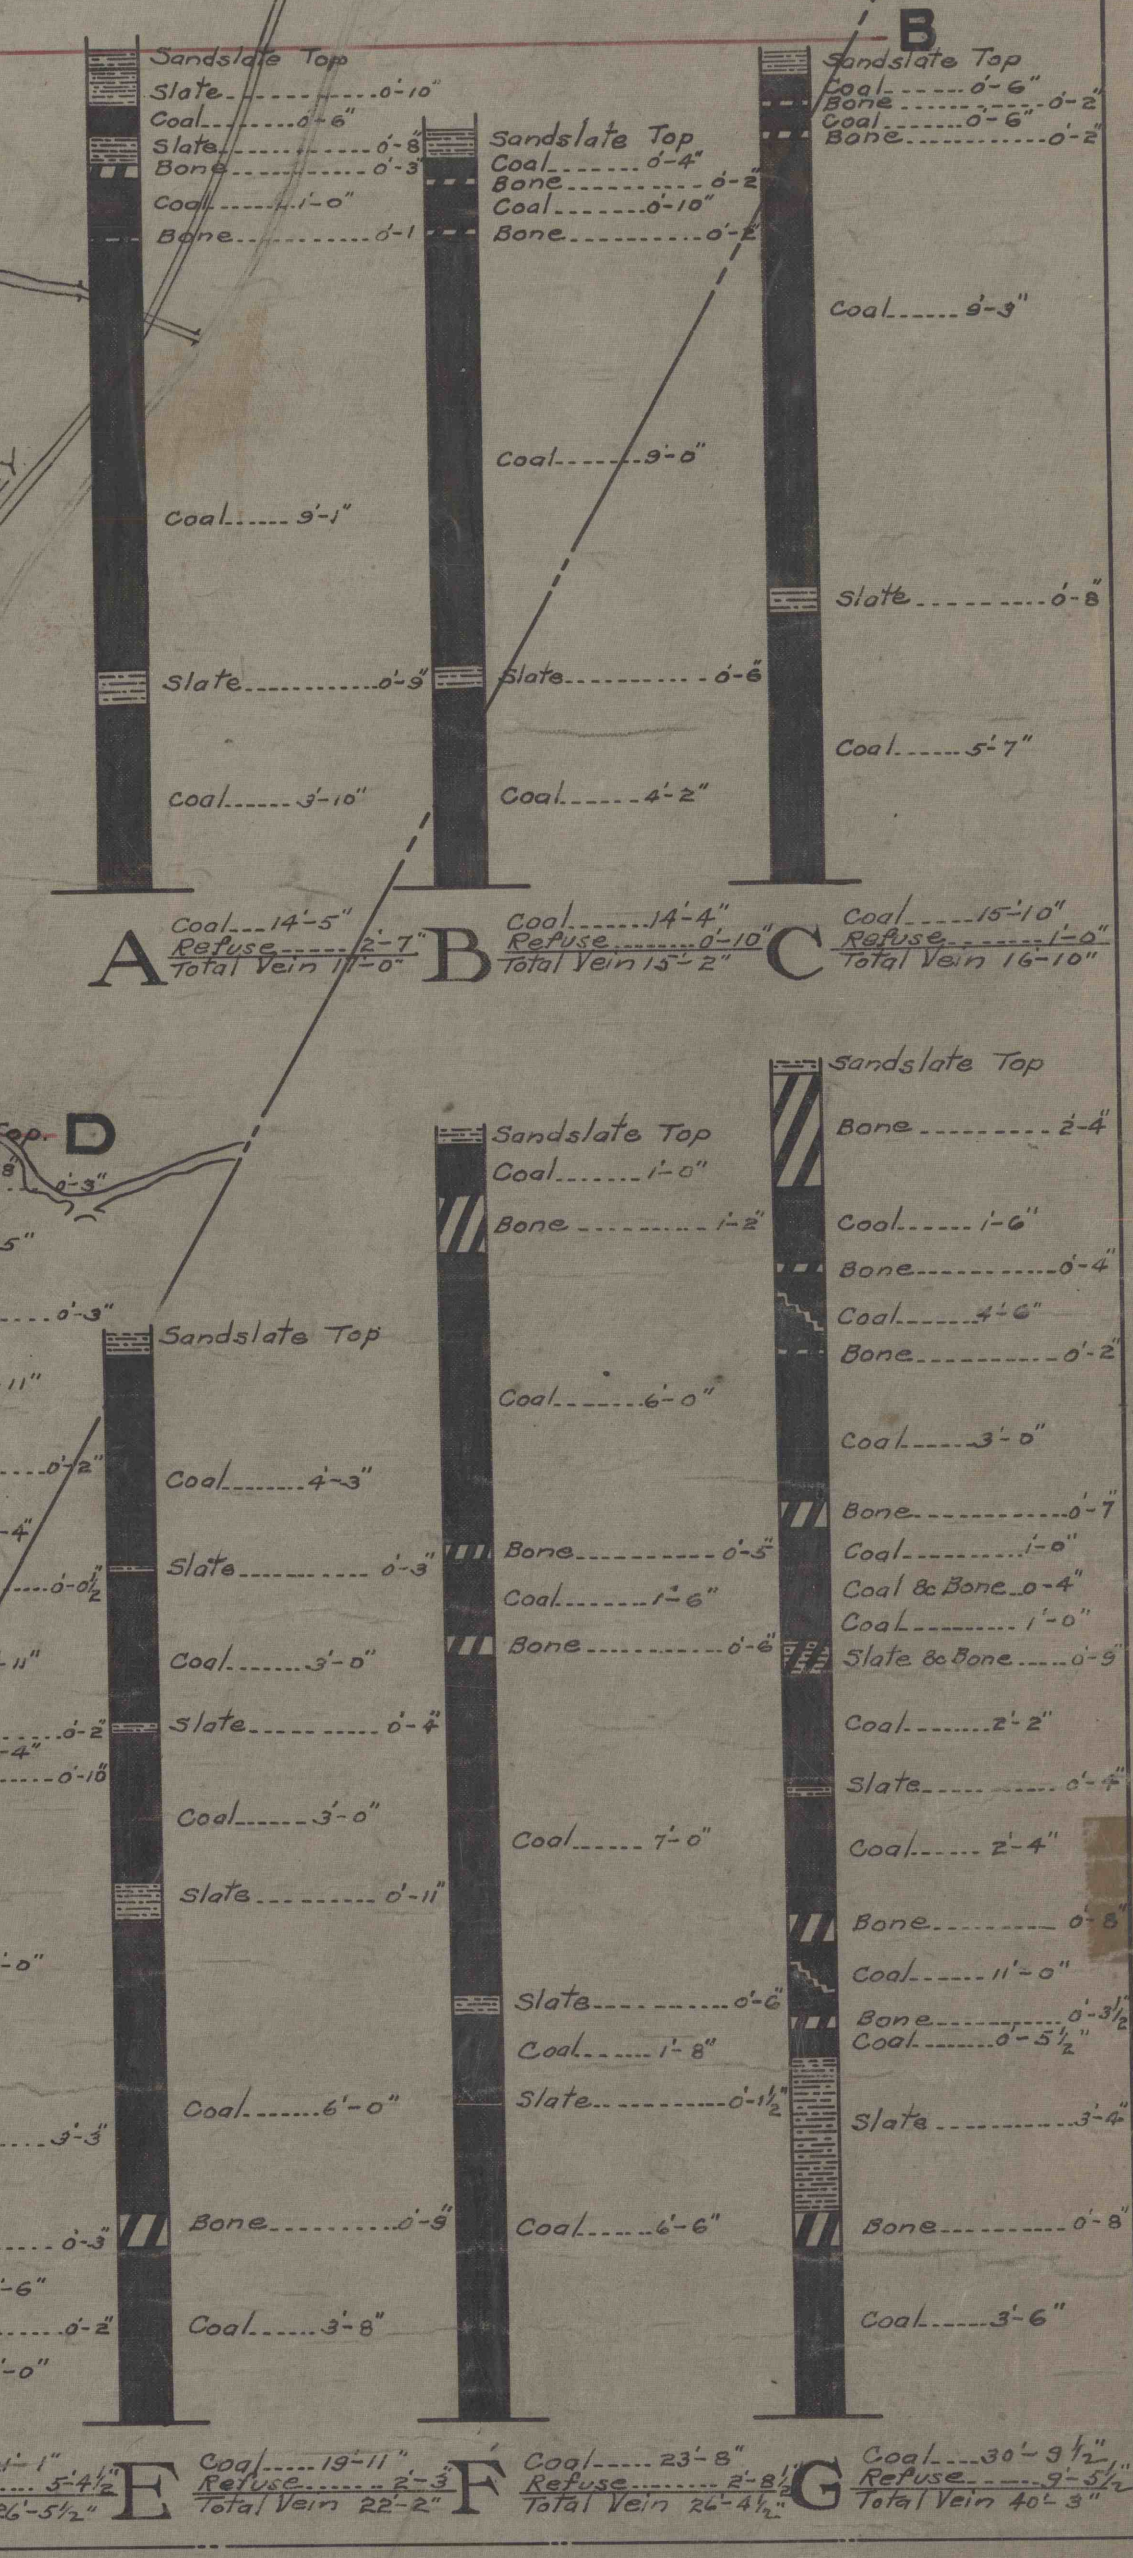


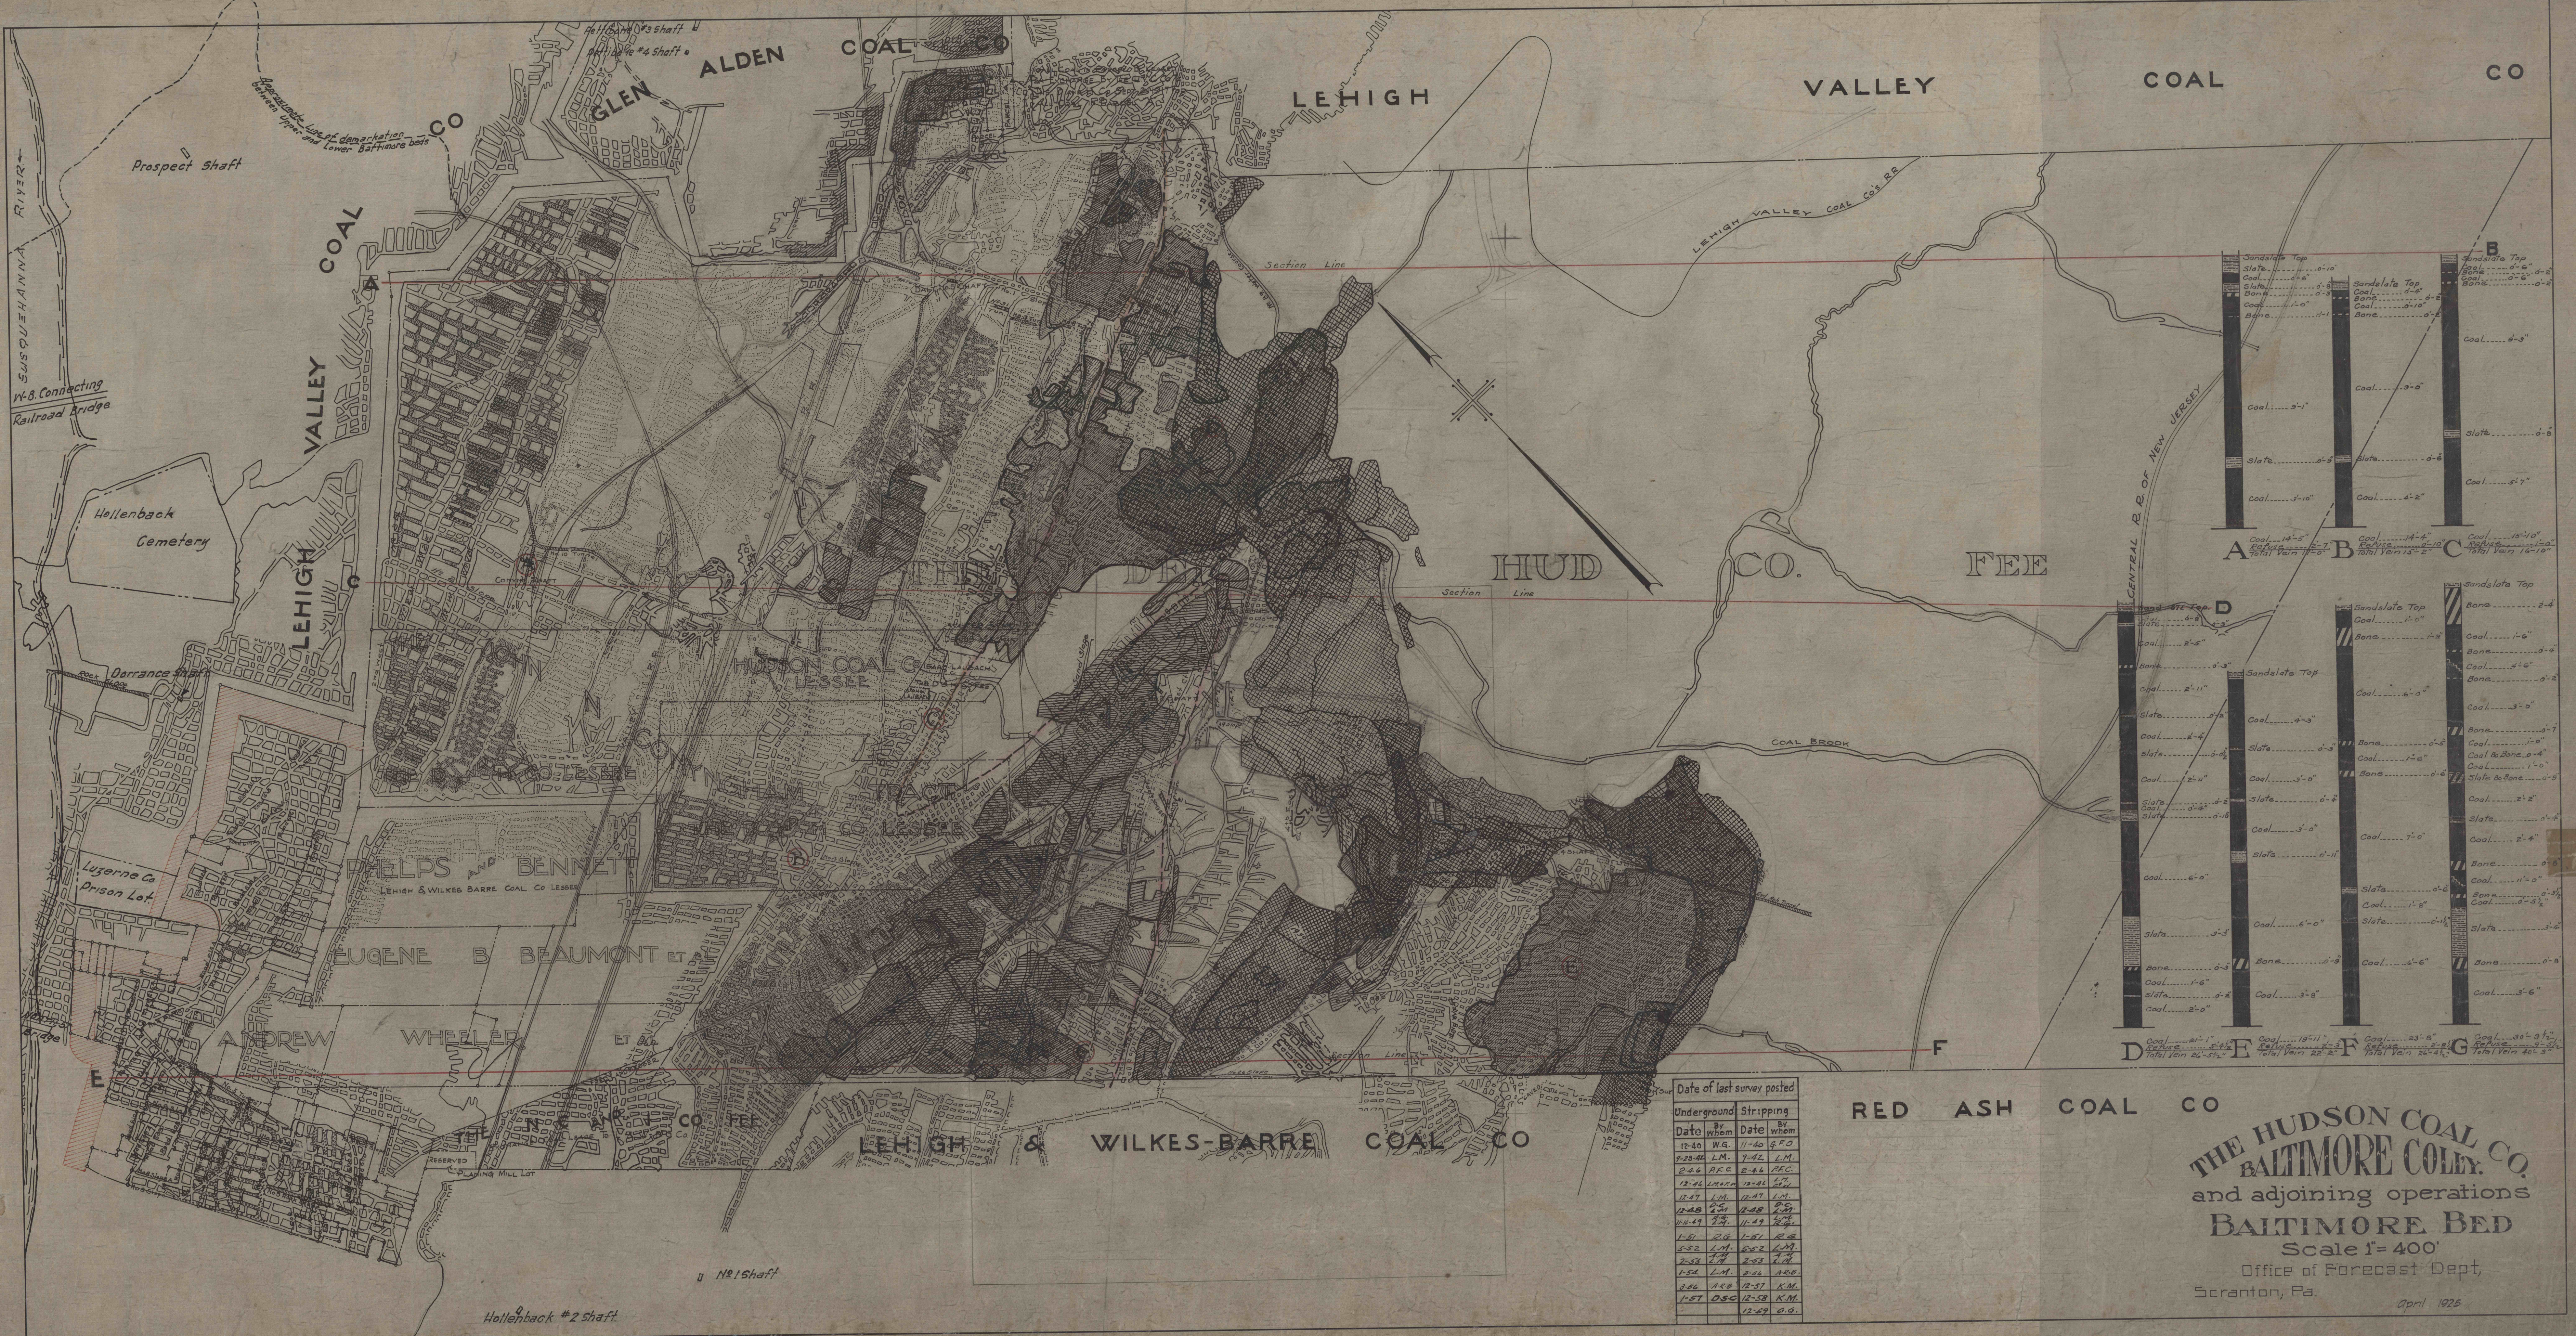

Date of last survey posted			
Underground	By whom	Stripping	By whom
12-40	W.G.	11-40	G.F.O.
9-23-42	L.M.	9-42	L.M.
2-26	A.F.C.	2-46	P.F.C.
12-46	L.M.	12-46	P.F.C.
12-47	L.M.	12-47	L.M.
12-48	L.M.	12-48	L.M.
10-49	L.M.	11-49	L.M.
1-51	L.M.	1-51	L.M.
5-52	L.M.	5-52	L.M.
2-53	L.M.	2-53	L.M.
1-54	L.M.	1-54	L.M.
3-56	A.S.B.	12-57	K.M.
1-57	D.S.C.	12-58	K.M.
		12-59	O.G.

RED ASH COAL CO

THE HUDSON COAL
BALTIMORE COLEY CO.
and adjoining operations
BALTIMORE BED
Scale 1" = 400'
Office of Forecast Dept,
Scranton, Pa.
April 1925