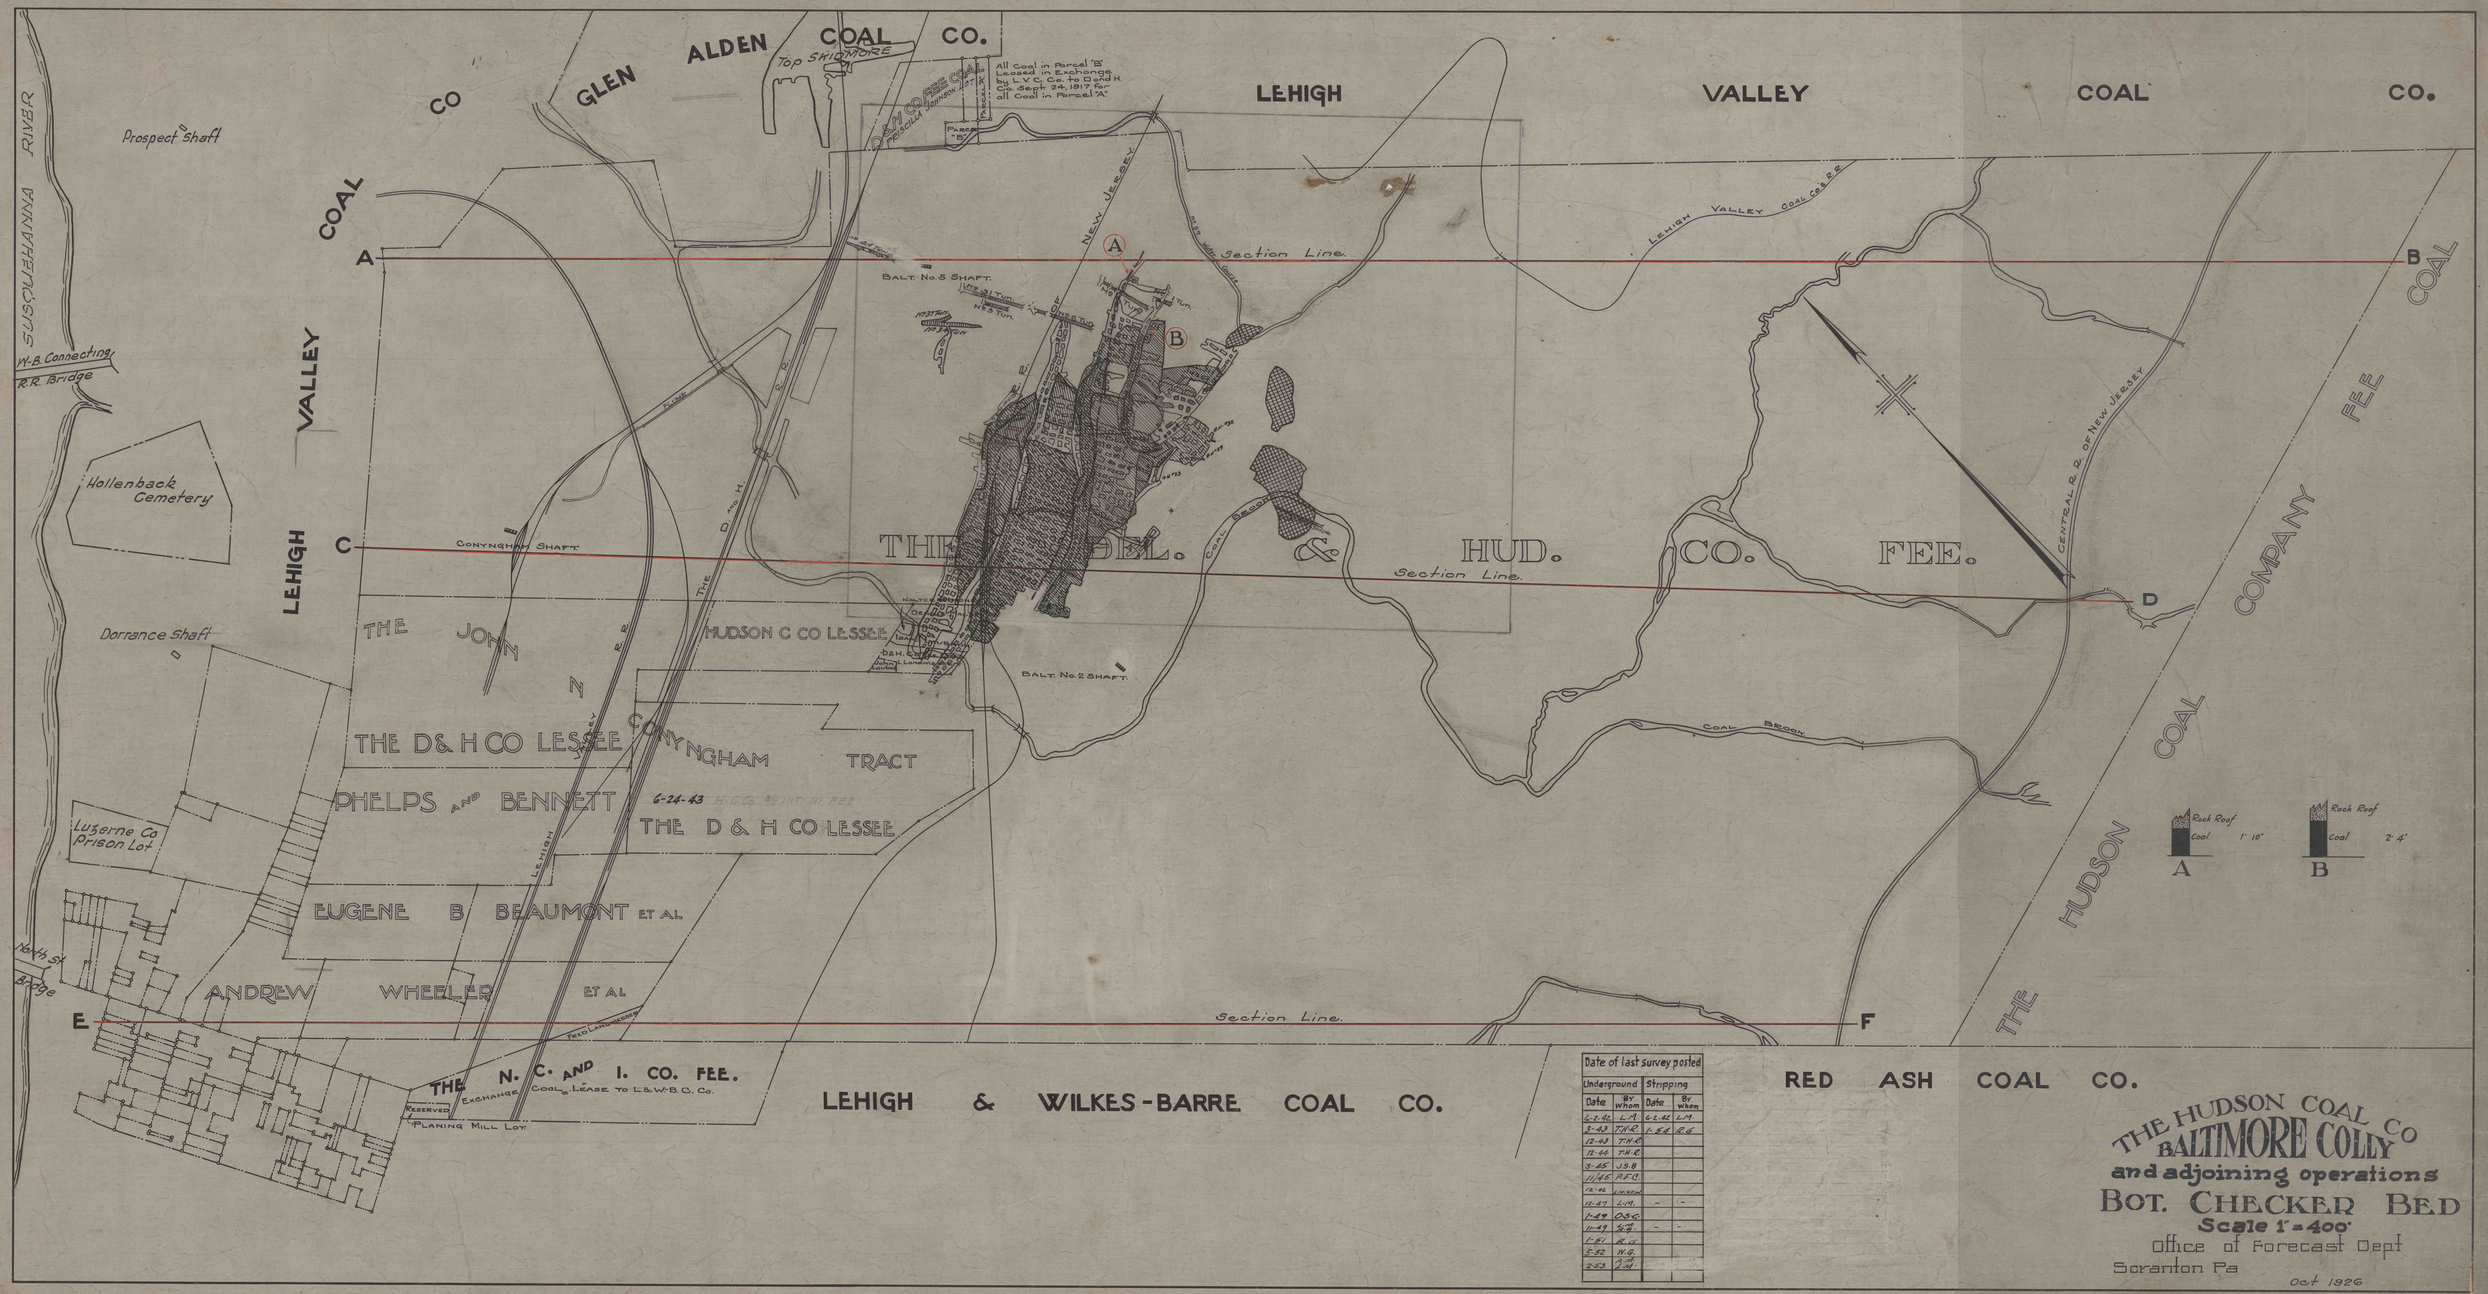
GLEN ALDEN COAL CO.
LEHIGH VALLEY COAL CO.
LEHIGH VALLEY COAL CO.
SUSQUEHANNA RIVER
Prospect Shaft
W.B. Connecting R.R. Bridge
Hollenback Cemetery
Dorrance Shaft
Luzerne Co Prison Lot
North St Bridge
Top Shiomore
All Coal in Parcel "B" Leased in Exchange by L.V.C. Co. to D and H. Co. Sept 24, 1917 for all Coal in Parcel "A"
Section Line
Balt. No. 5 Shaft
Conyngham Shaft
Balt. No. 2 Shaft
Coal Brook
Central R.R. of New Jersey
THE JOHN N CONYNGHAM TRACT
HUDSON C CO LESSEE
THE D & H CO LESSEE
PHELPS AND BENNETT
6-24-43
THE D & H CO LESSEE
EUGENE B BEAUMONT ET AL
ANDREW WHEELER ET AL
THE N. C. AND I. CO. FEE.
Exchange Coal Lease to L&W-B.C. Co.
Reserved
Planing Mill Lot
LEHIGH & WILKES-BARRE COAL CO.
RED ASH COAL CO.
THE HUDSON COAL COMPANY FEE
Rock Roof
Coal
1' 10"
A
Rock Roof
Coal
2' 4"
B
Date of last survey posted
Underground
Stripping
Date
By whom
Date
By when
6-2-42 L.A. 6-2-42 L.A.
3-43 T.H.R. 1-54 R.G.
12-43 T.H.R.
12-44 T.H.R.
3-45 J.S.B.
11-45 P.F.O.
12-46 Wilson
12-47 L.A. - -
1-49 O.S.C.
11-49 S.T. - -
1-51 R.G.
5-52 W.G.
2-53 J.H.
THE HUDSON COAL CO
BALTIMORE COLLY
and adjoining operations
BOT. CHECKER BED
Scale 1" = 400'
Office of Forecast Dept
Scranton Pa
Oct 1926