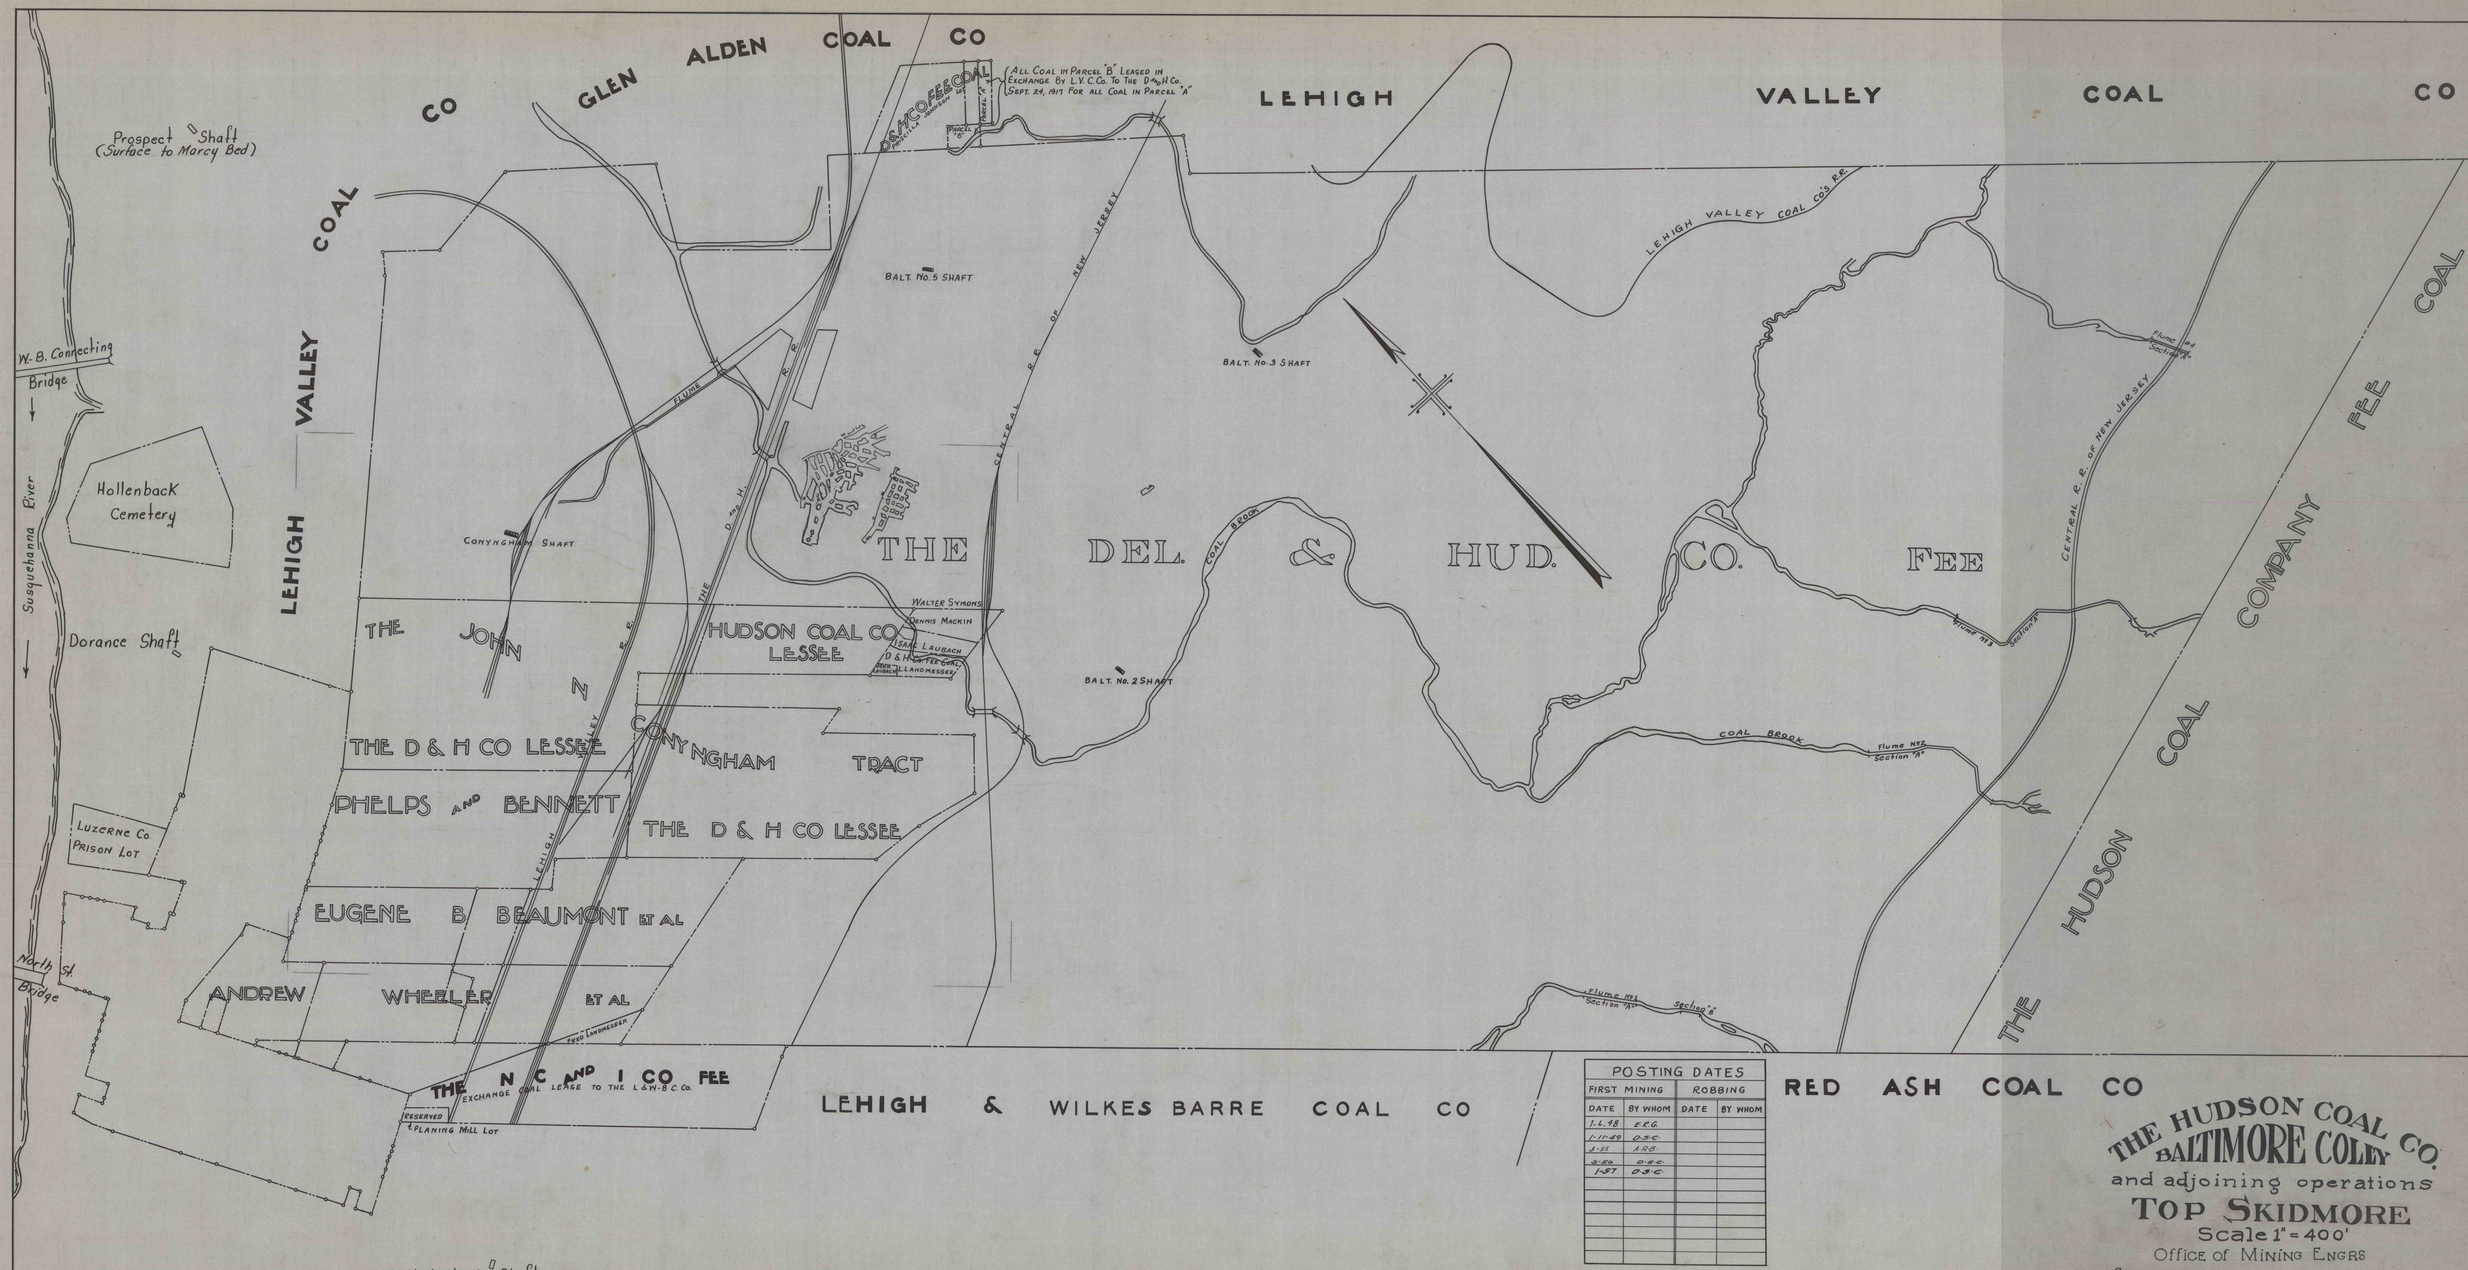

POSTING DATES			
FIRST MINING		ROBBING	
DATE	BY WHOM	DATE	BY WHOM
1-6-98	E.E.G.		
1-11-49	O.S.C.		
1-55	A.R.O.		
8-58	O.E.E.		
1-57	O.S.C.		

THE HUDSON COAL CO.
BALTIMORE COLLY
and adjoining operations
TOP SKIDMORE
Scale 1" = 400'
Office of Mining Engrs
Scranton, Pa.
January - 1948