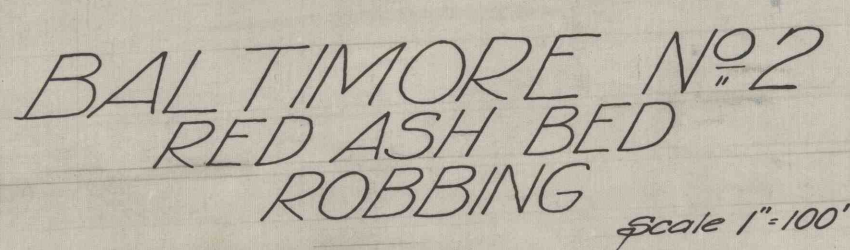


44-#1
B-155

[illegible]