


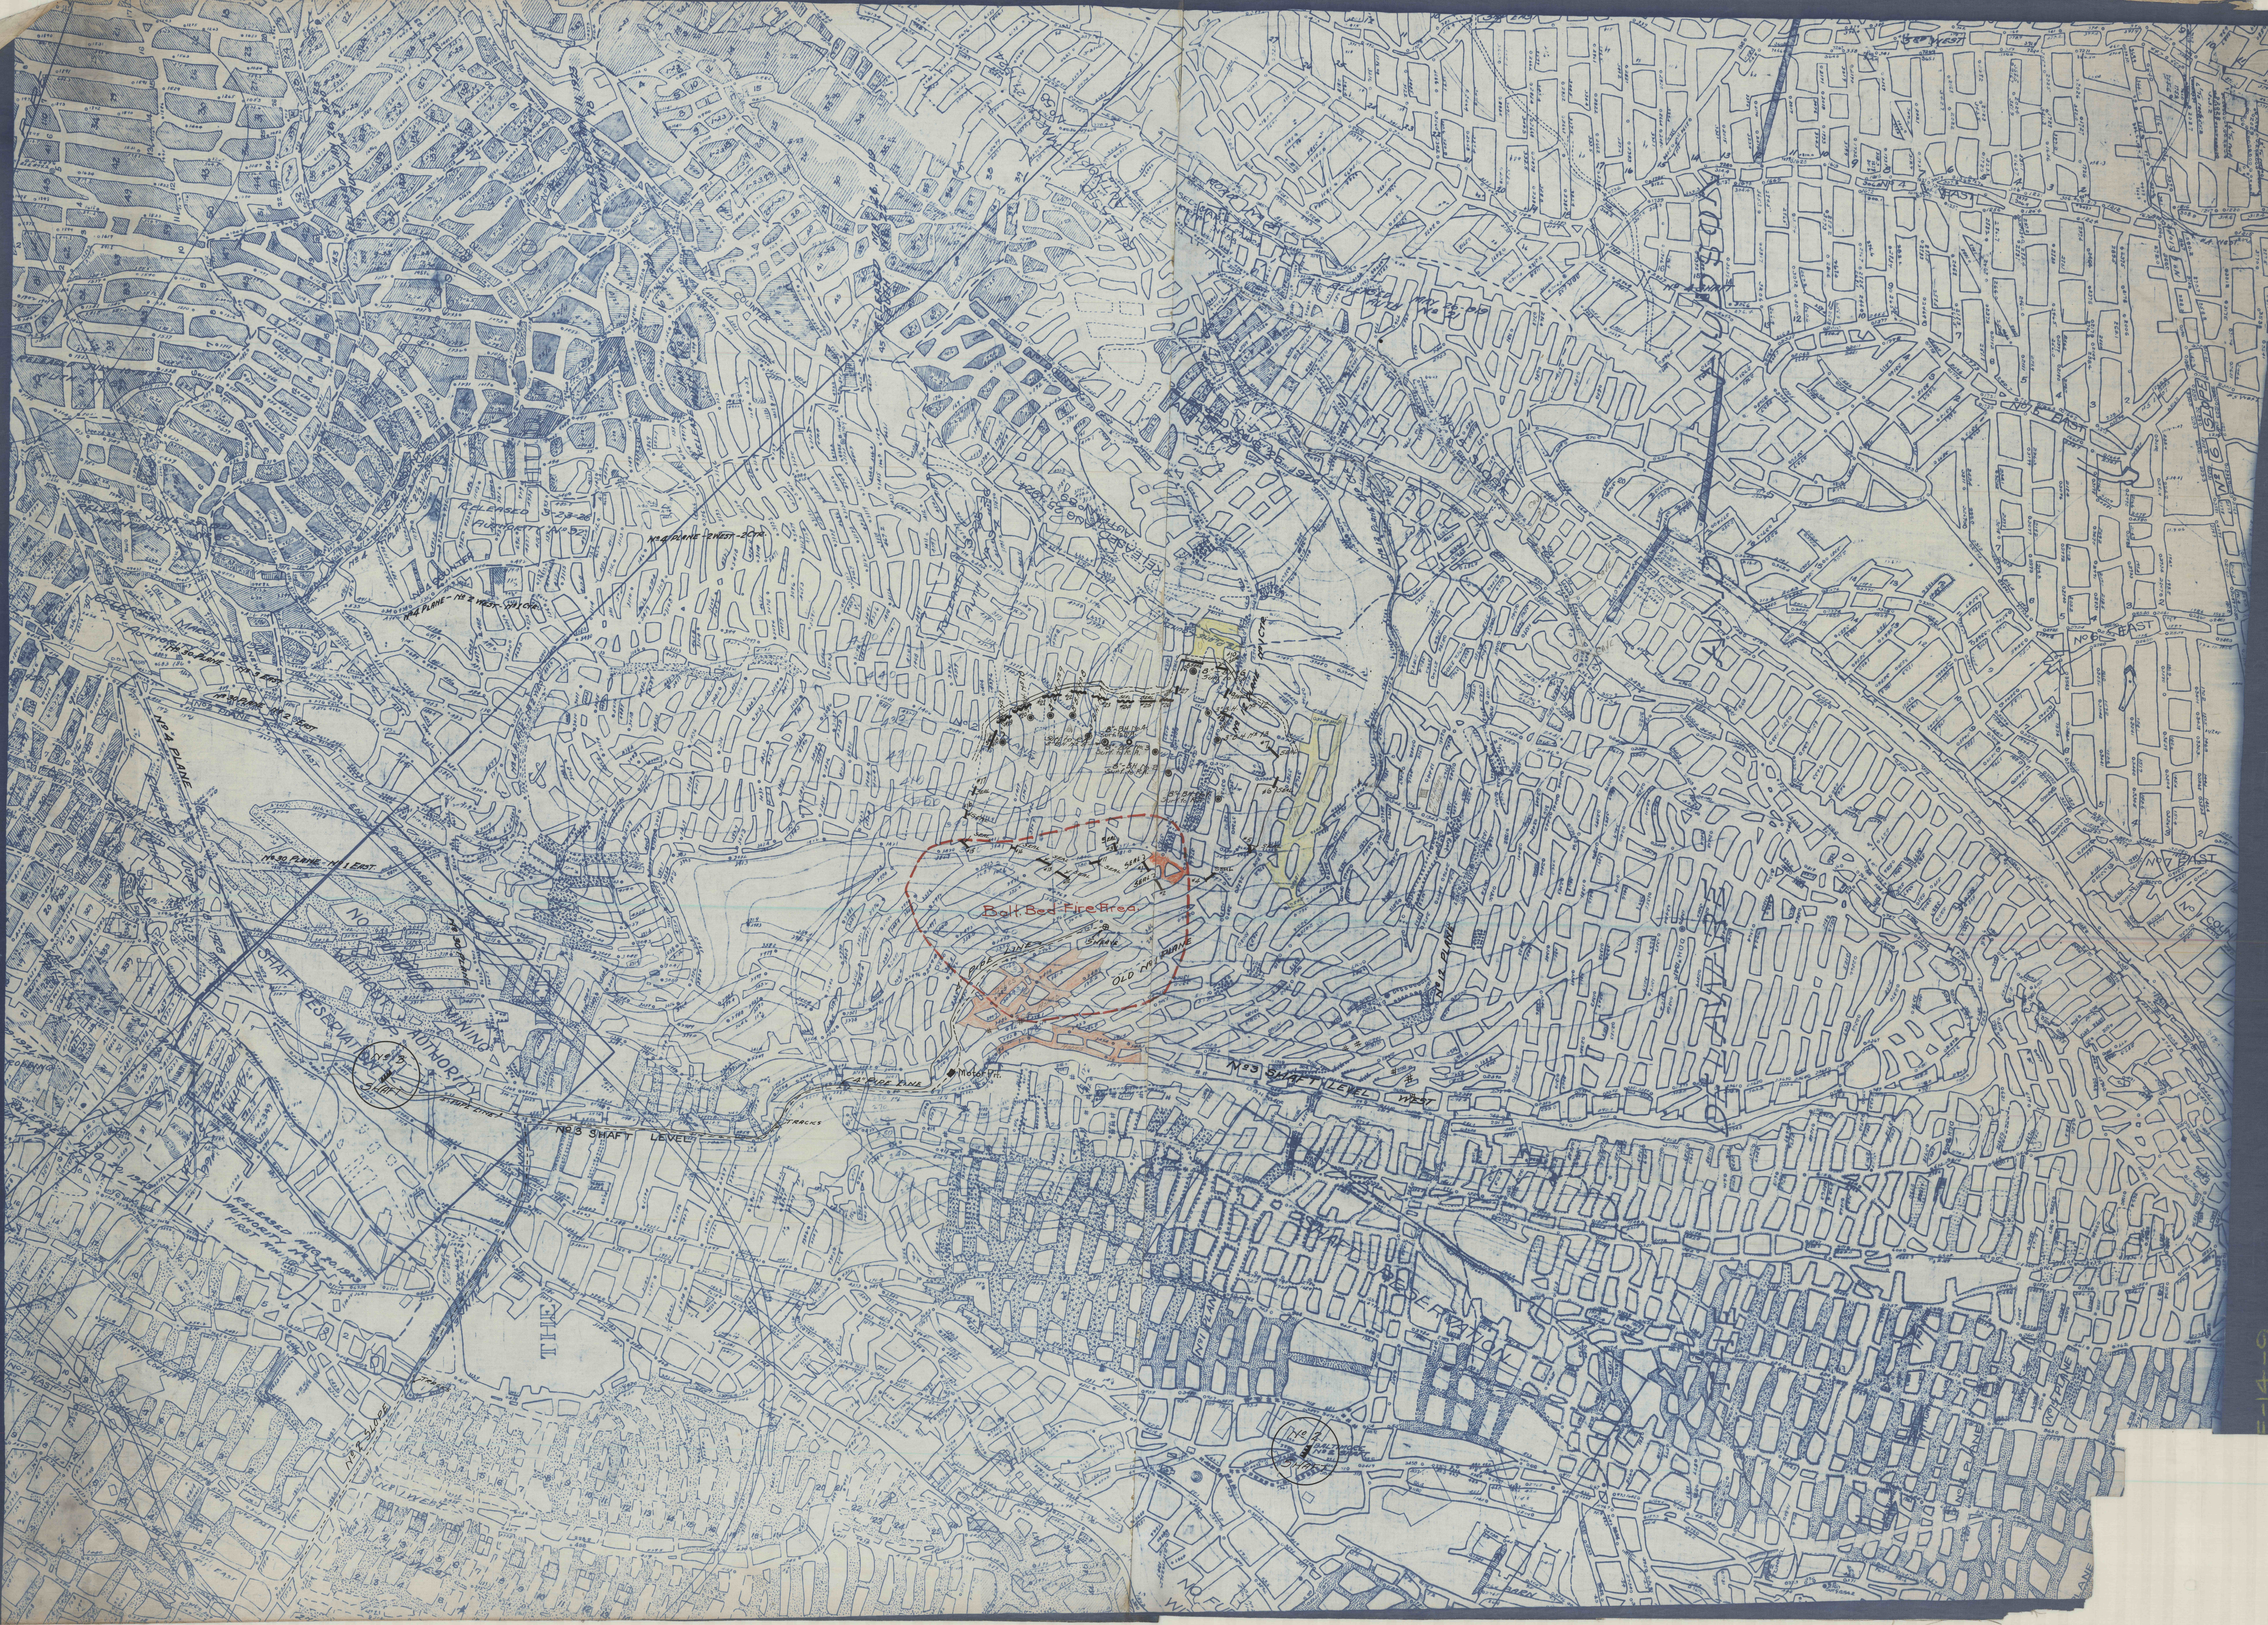

14-9