


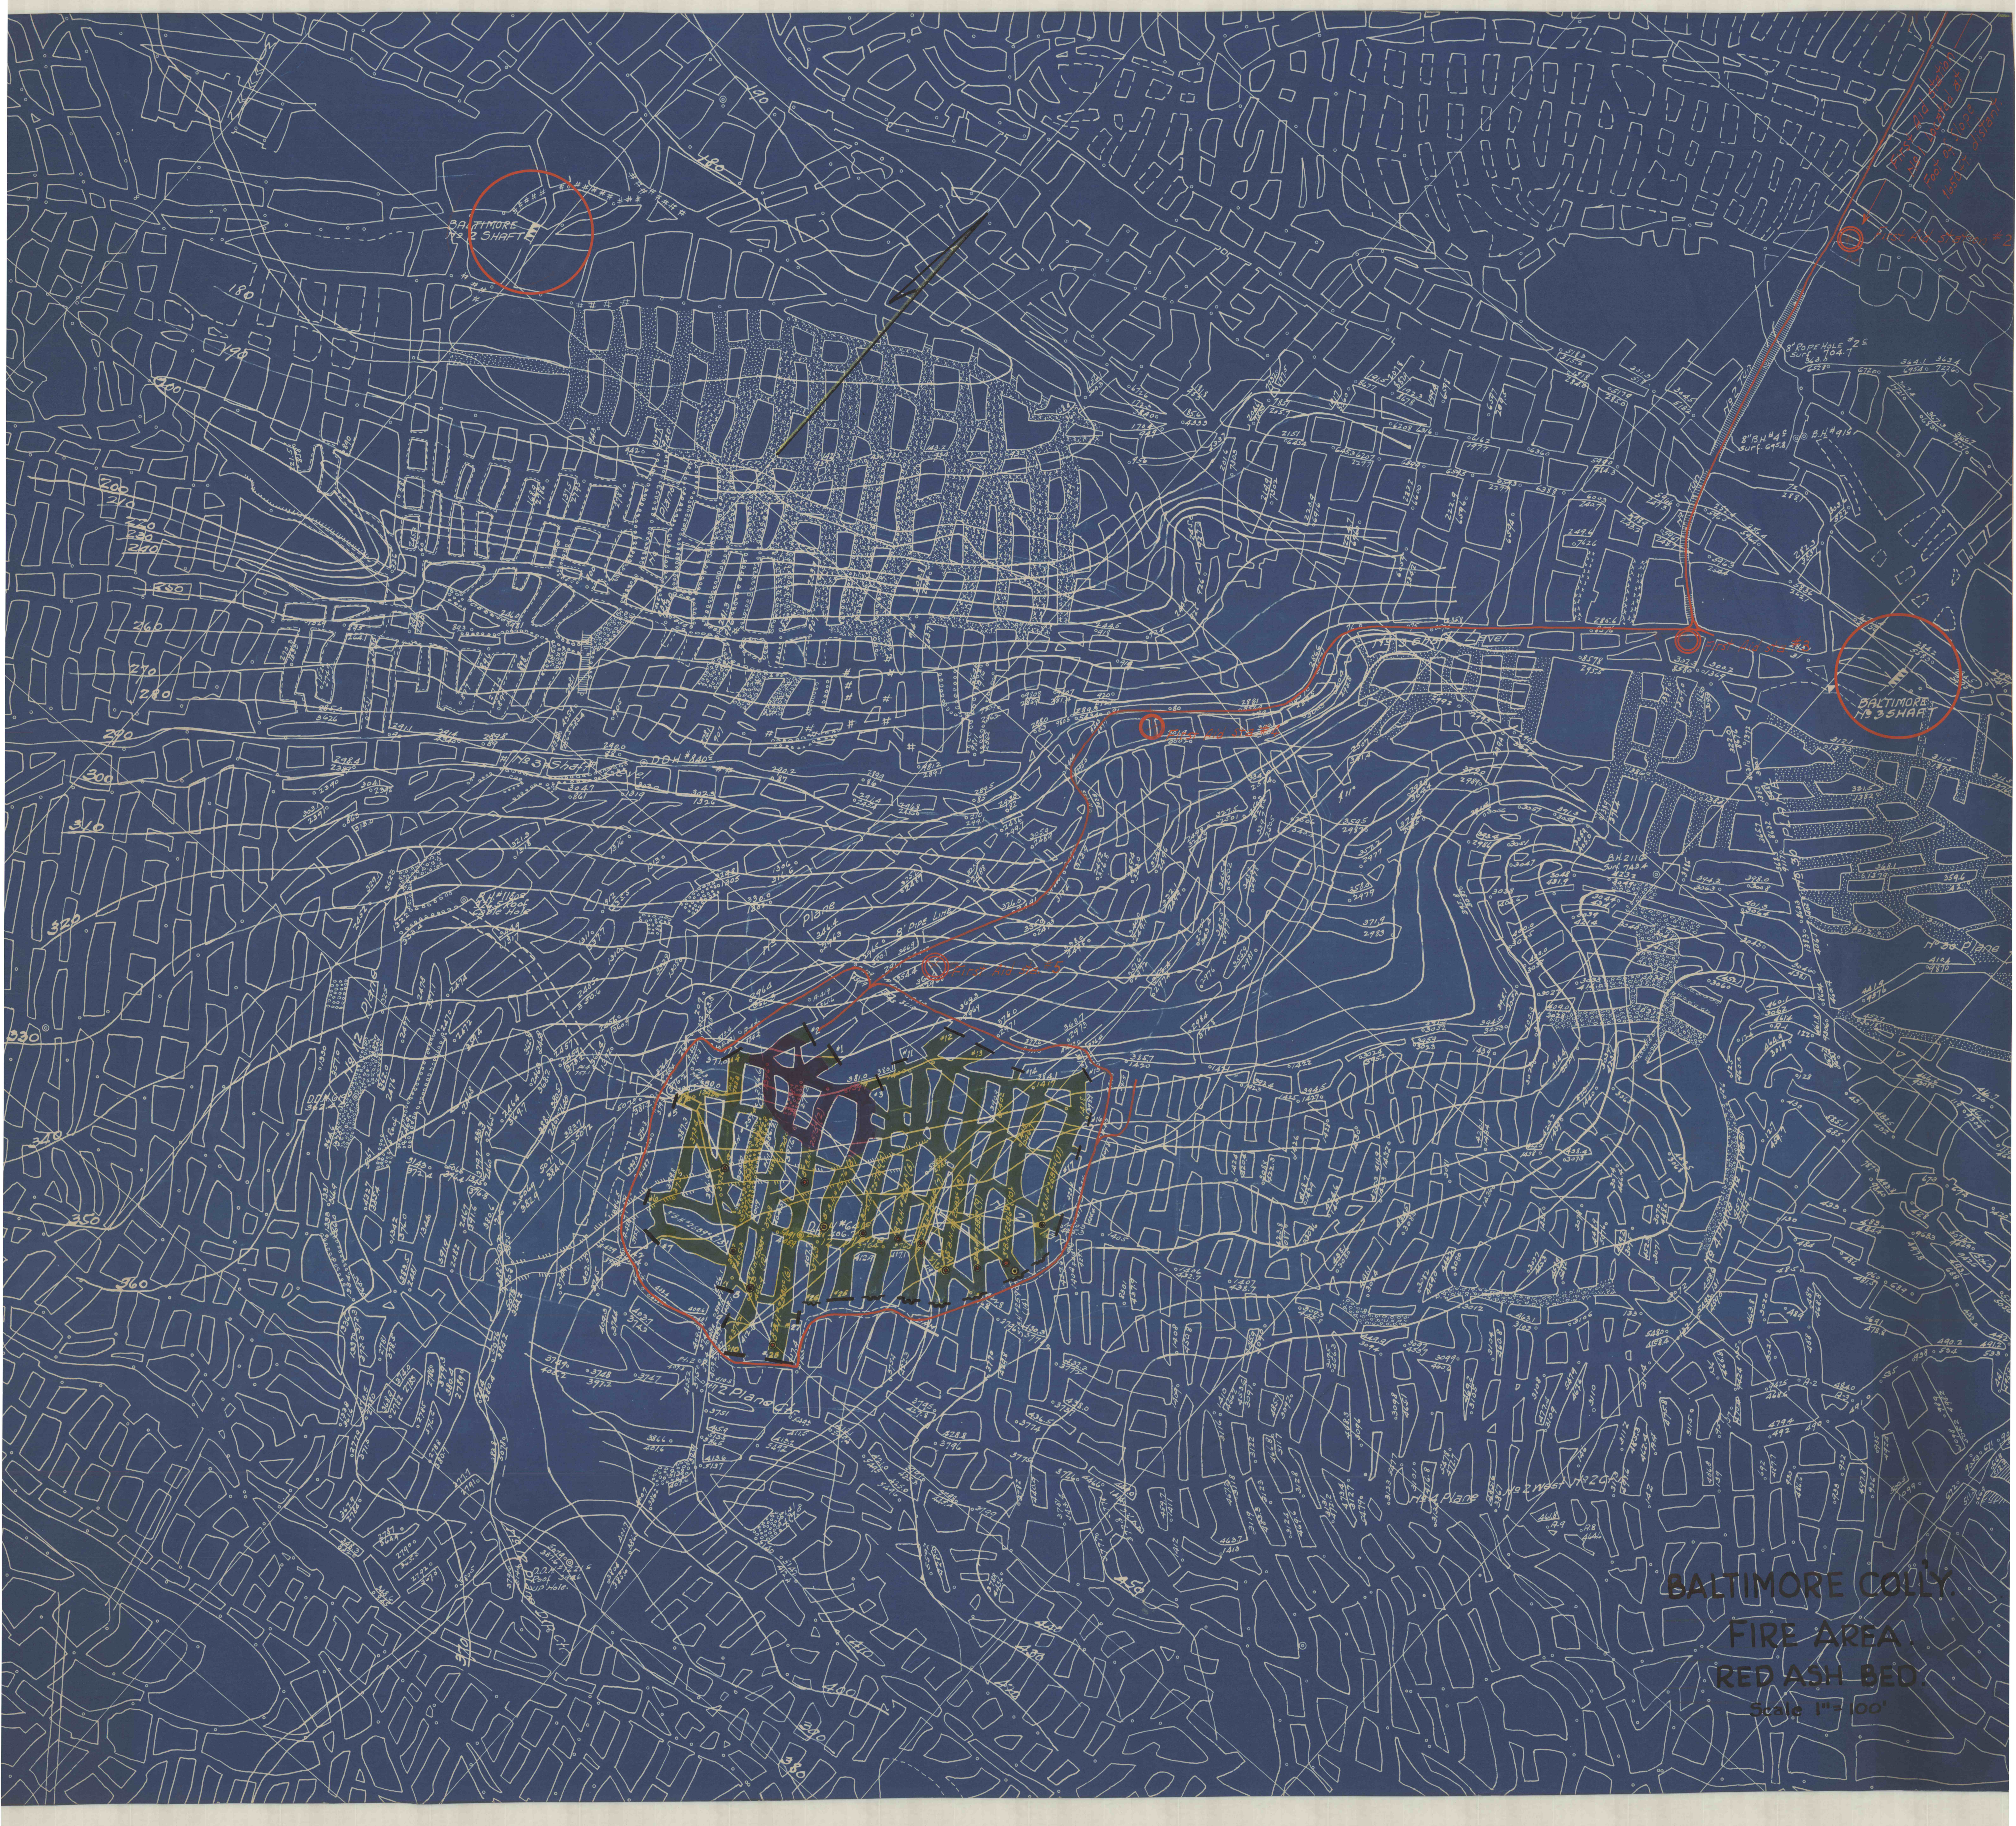

BALTIMORE COLLY
FIRE AREA.
RED ASH BED.
Scale 1"=100'