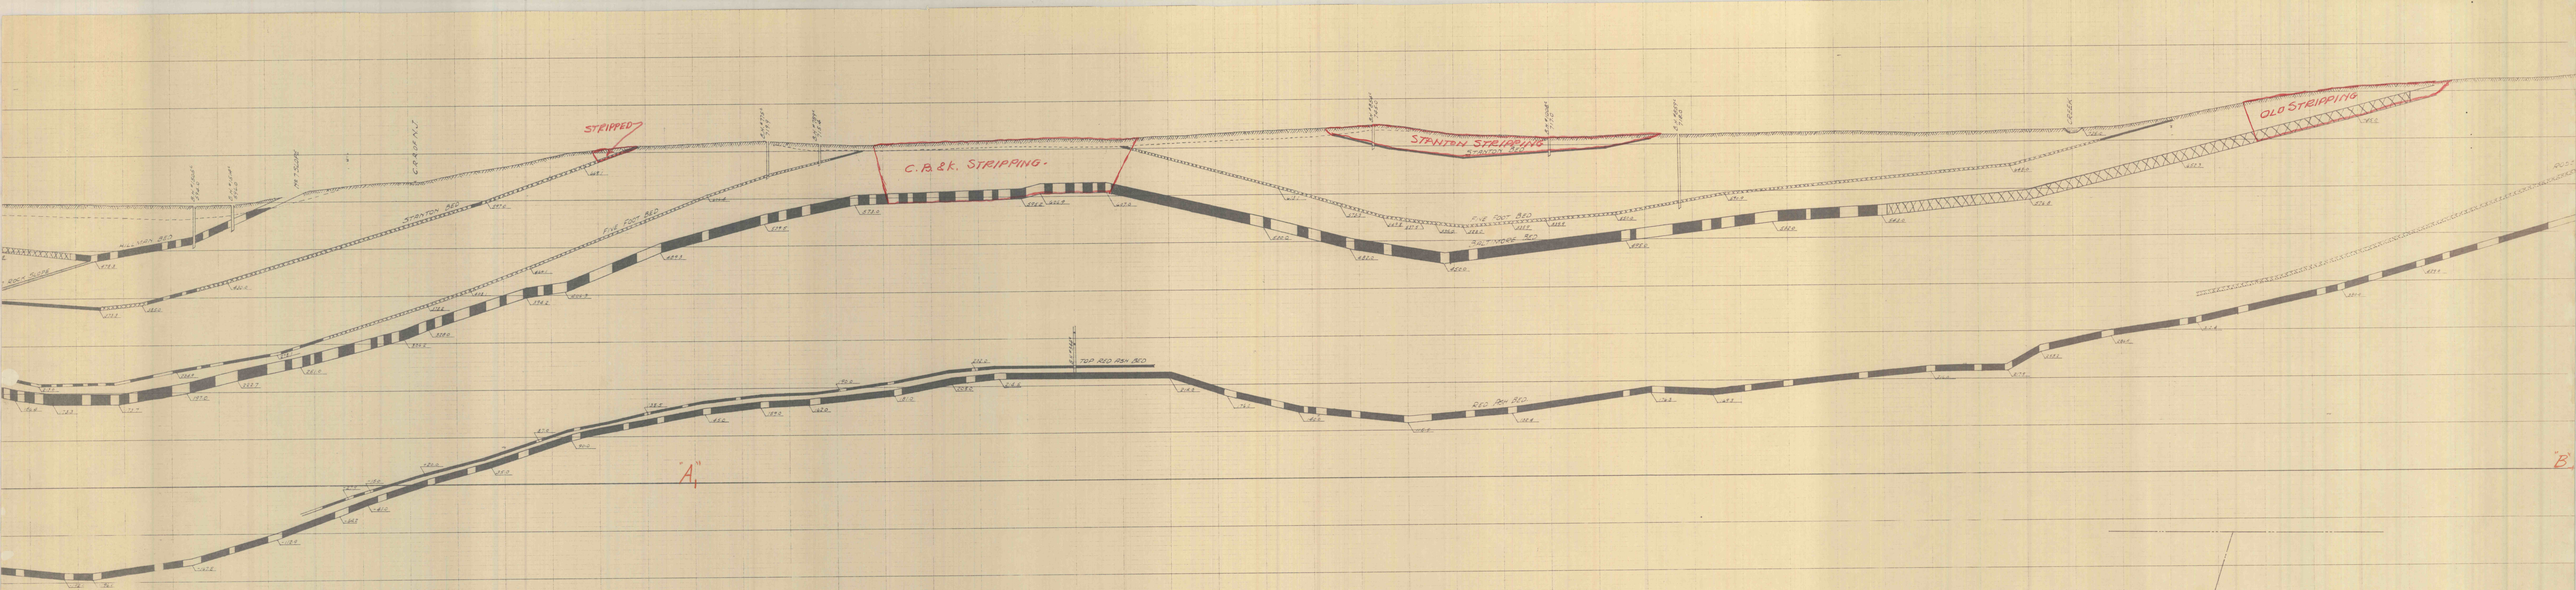

THE HUDSON COAL CO.
BALTIMORE COLLIERY
CROSS SECTION
THRU COAL MEASURES

SCALE 1 INCH = 100 FT
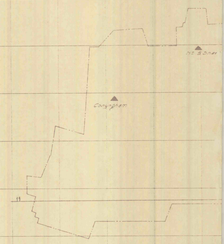
MINING ENGINEER'S OFFICE ——— MARCH 1930