


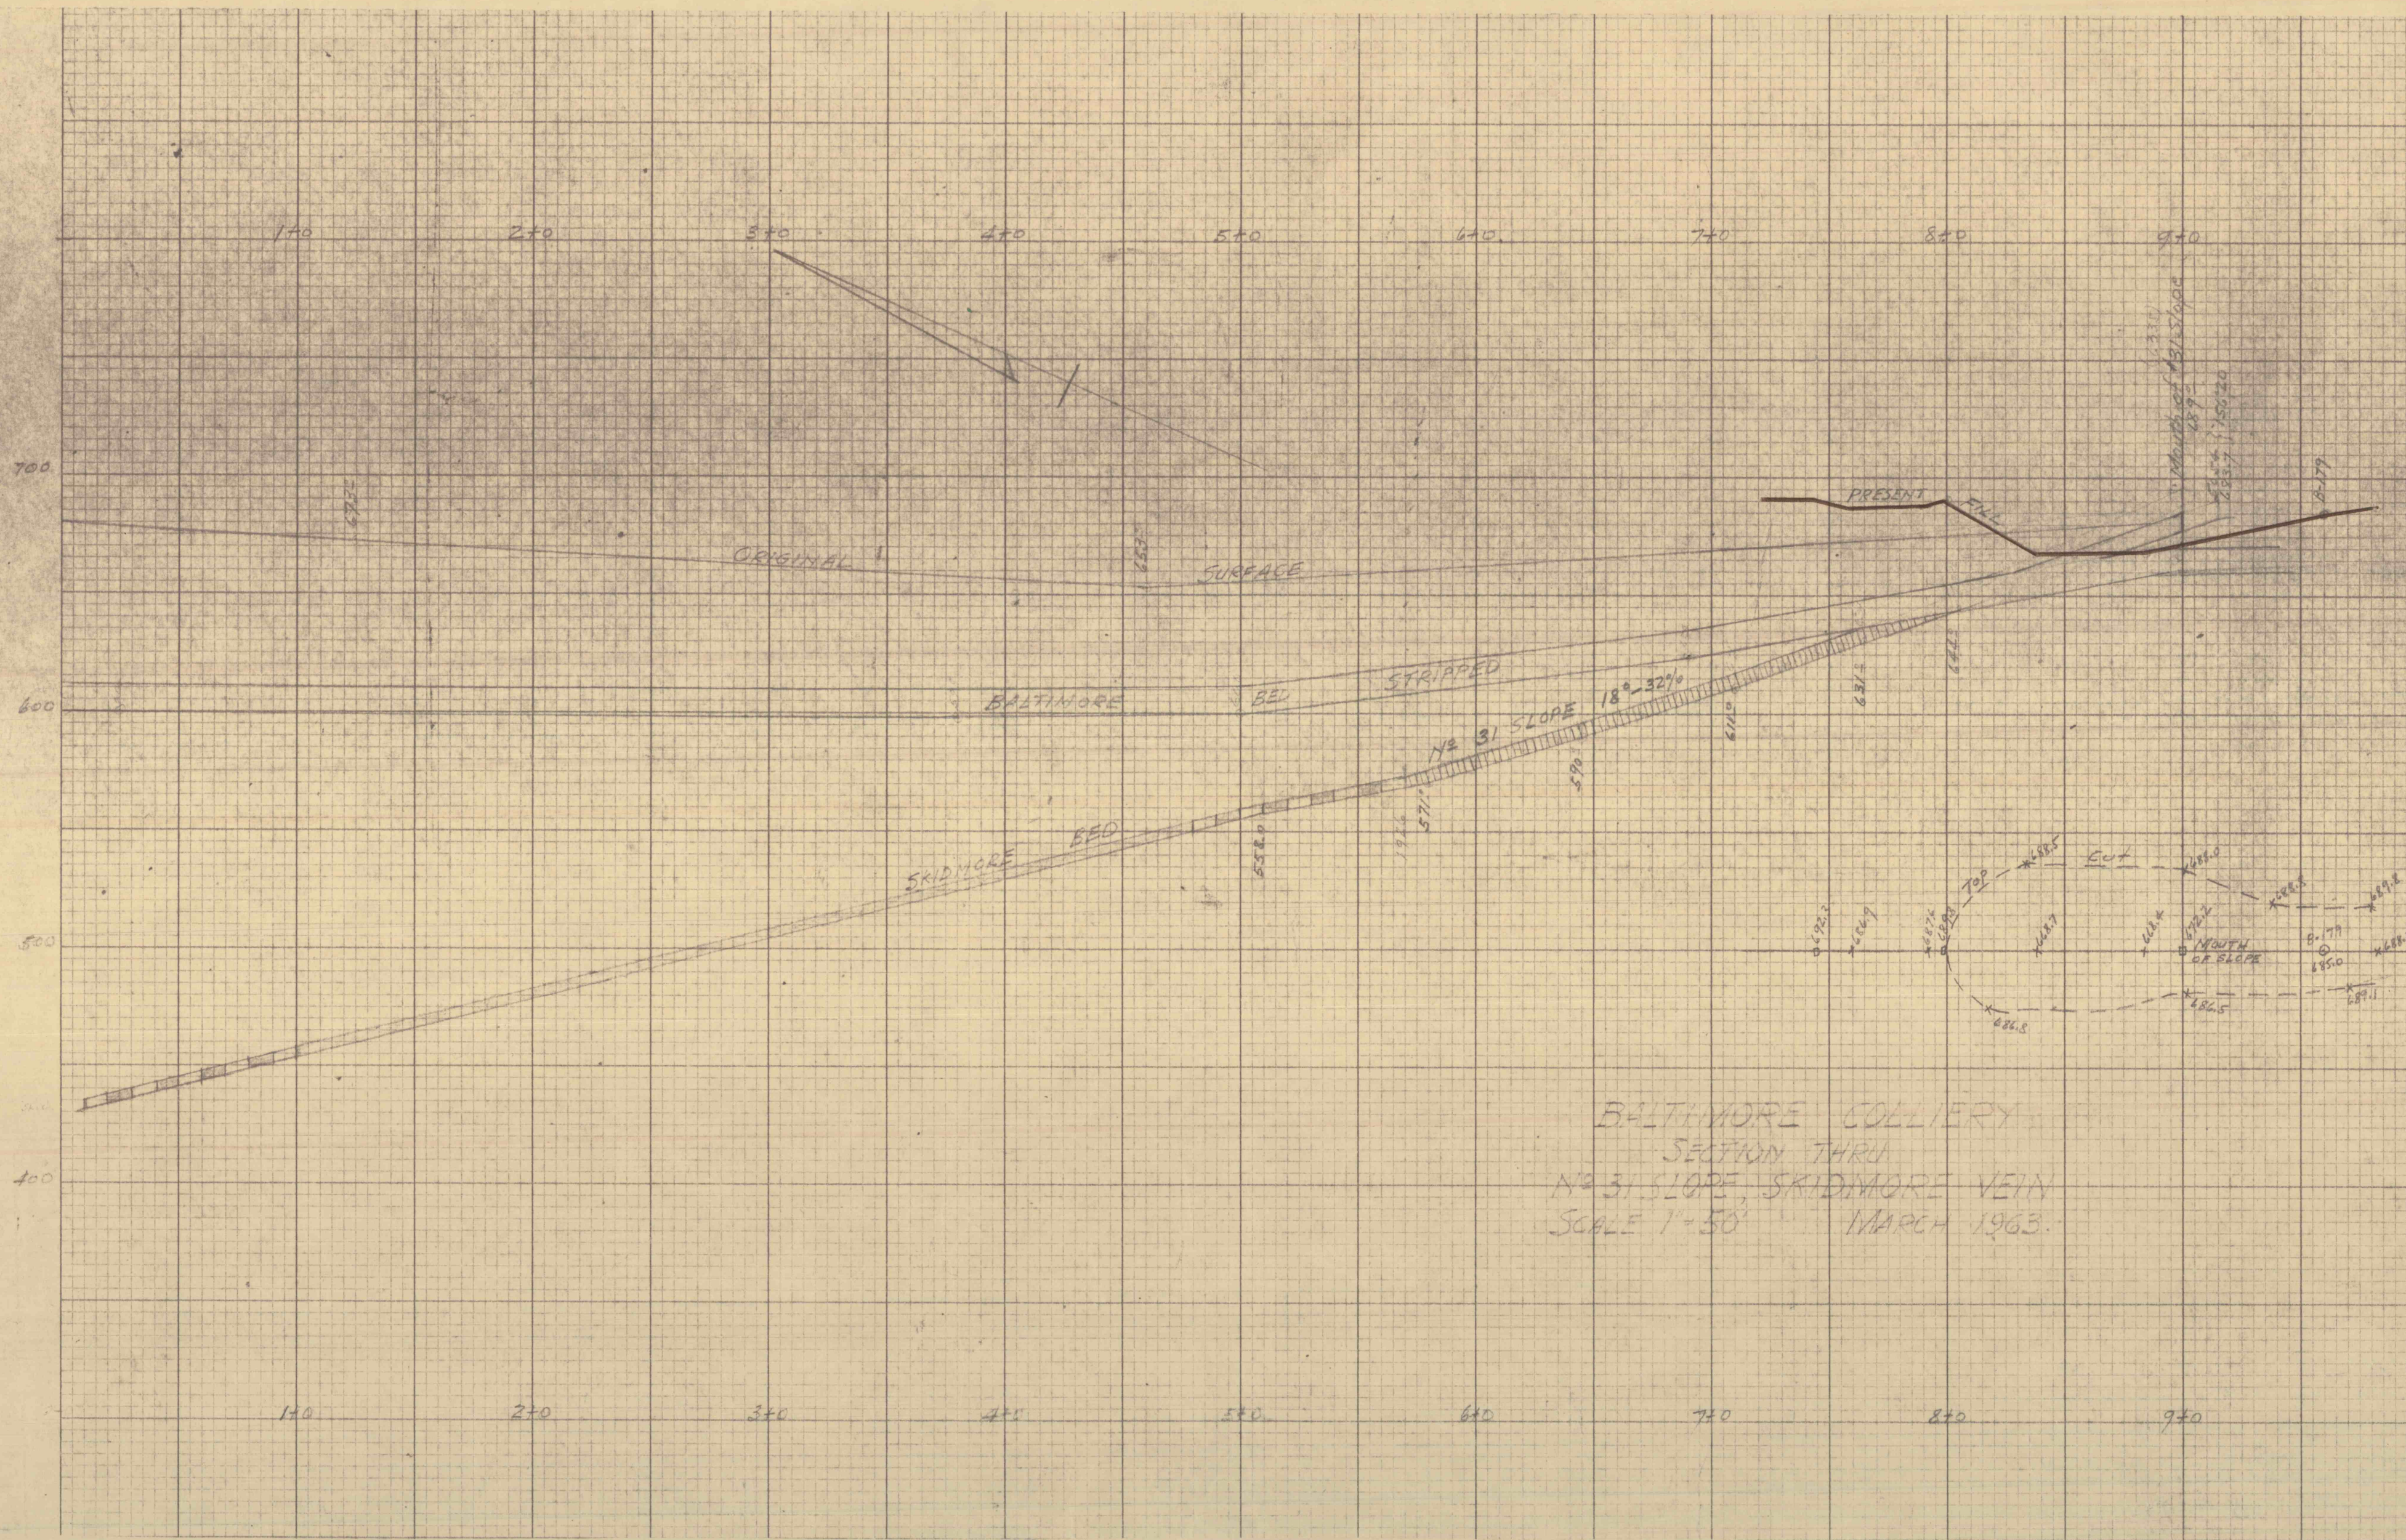

BALTIMORE COLLIERY
SECTION THRU
NO. 31 SLOPE, SKIDMORE VEIN
SCALE 1"=50' MARCH 1963.