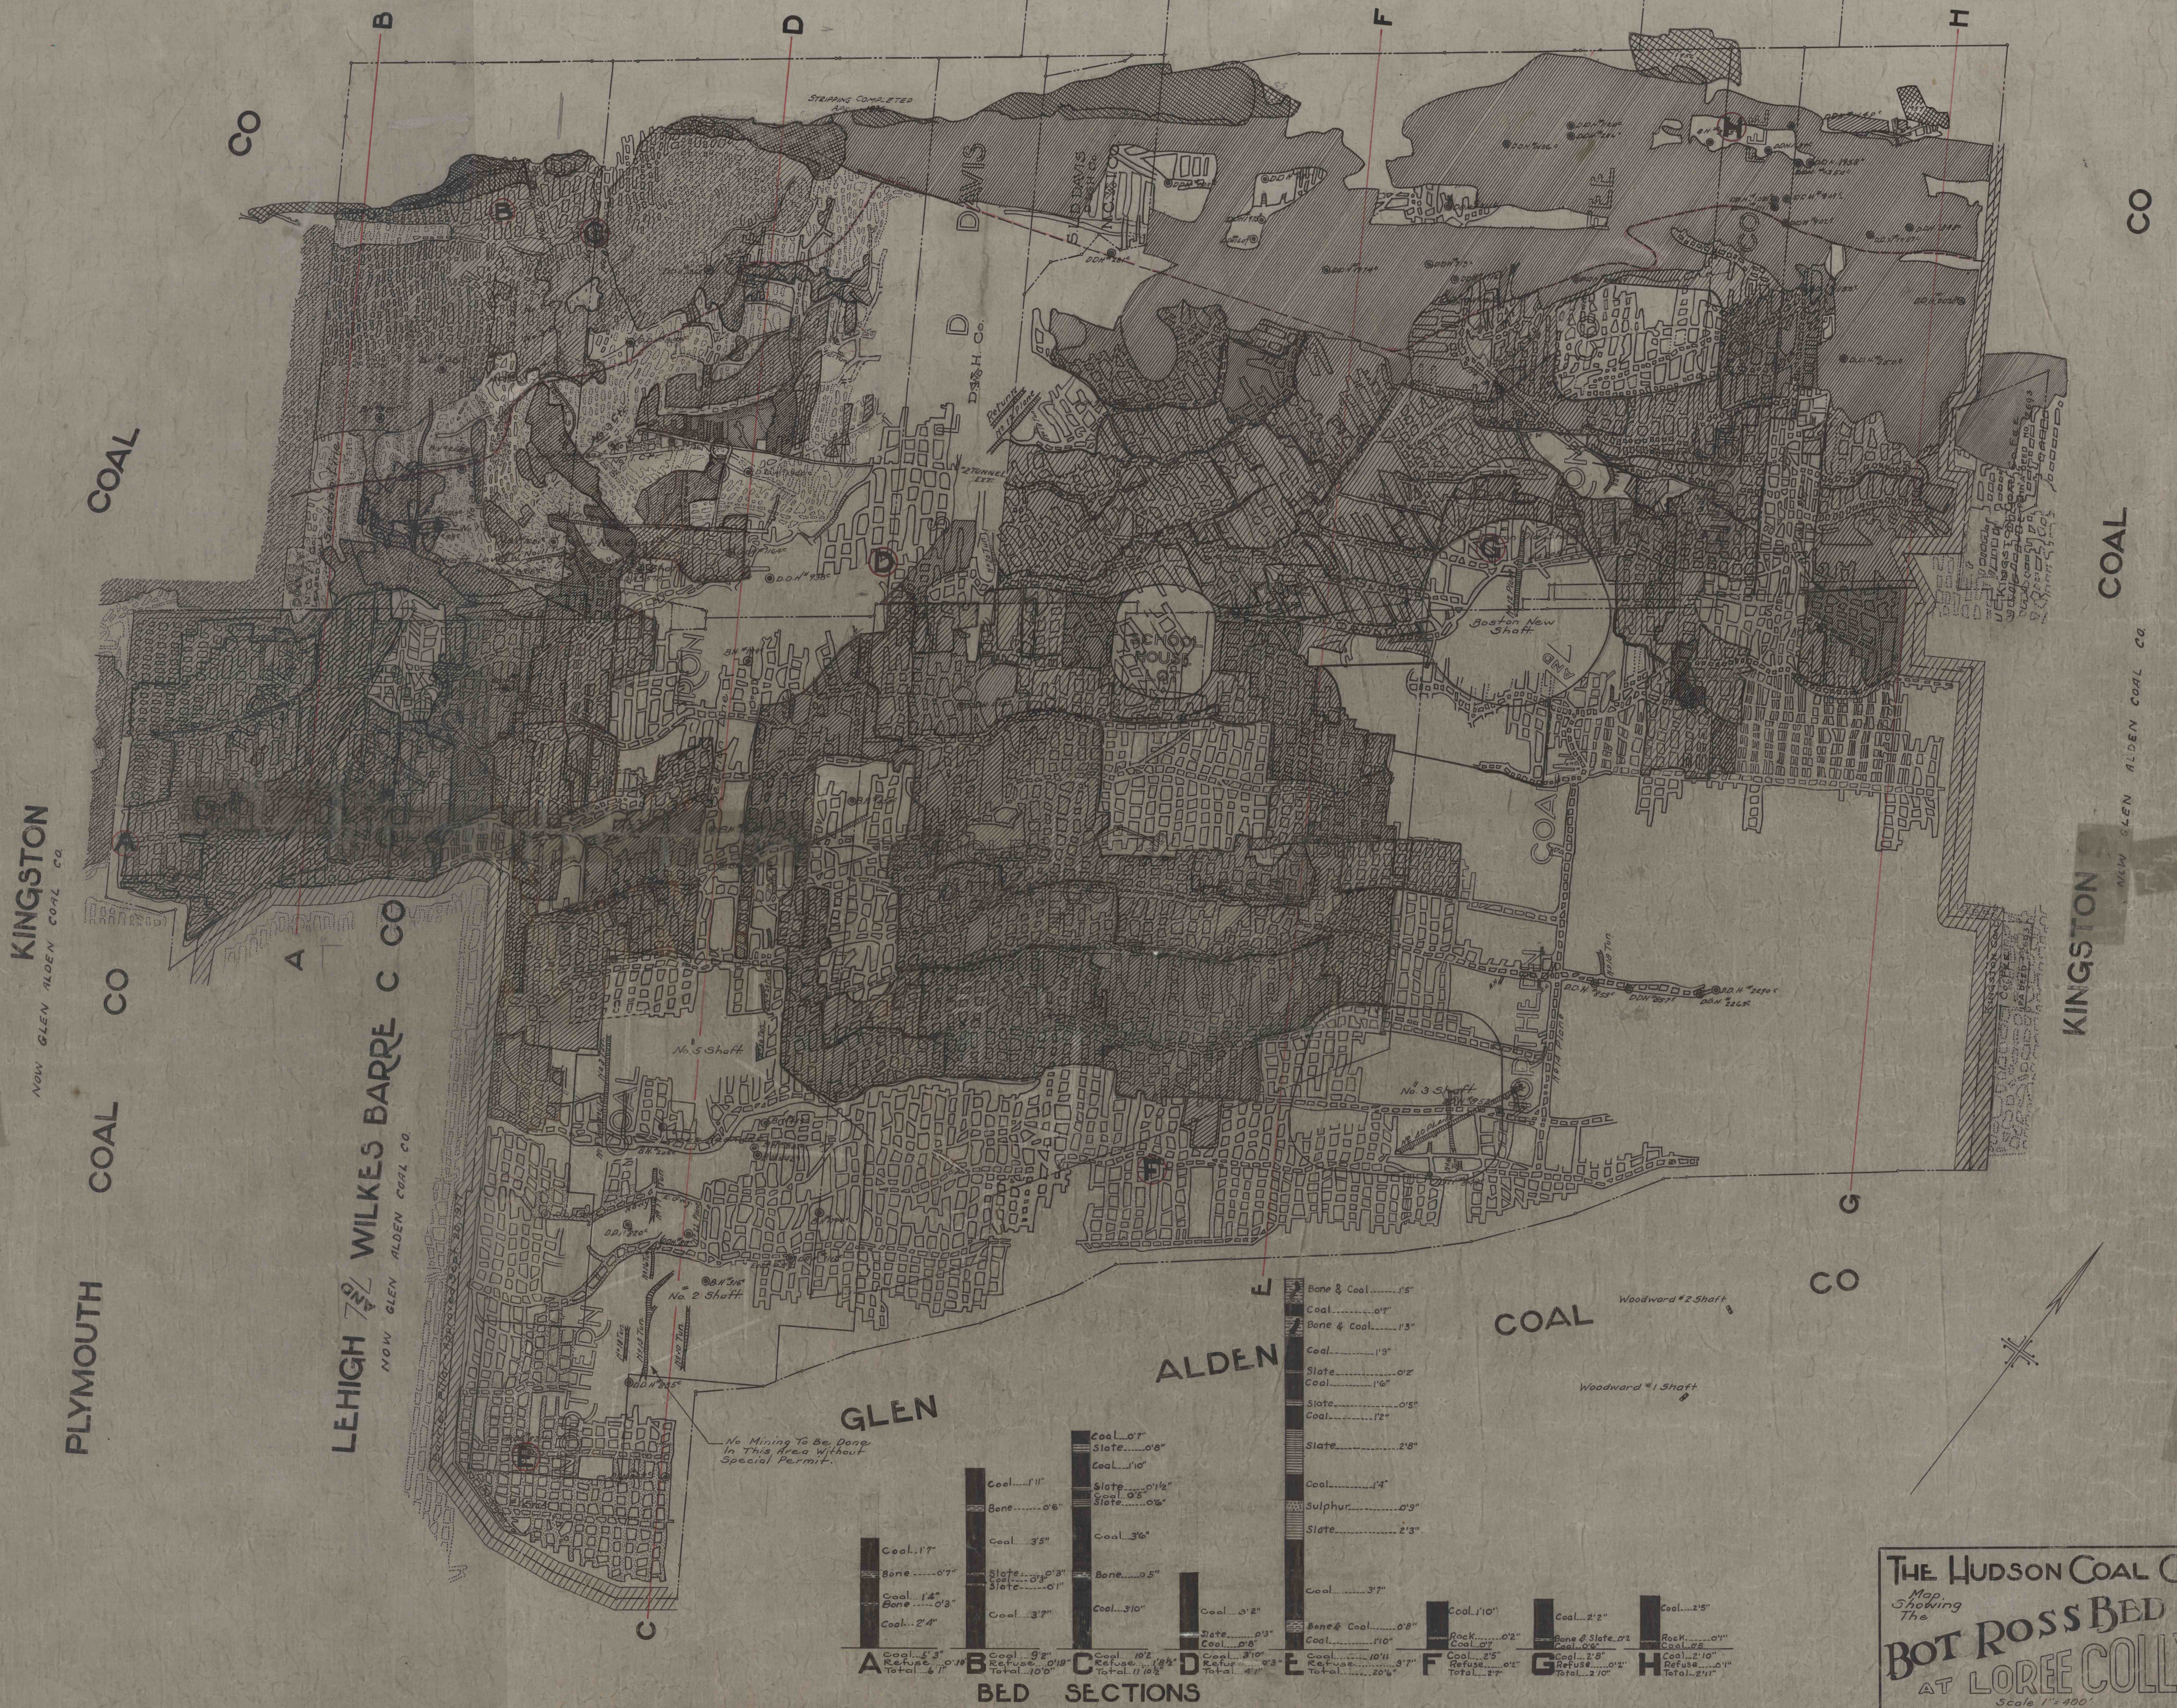


[illegible][illegible]

Done
 hour


Coal...0'7"
 Slate...0'8"
 Coal...1'0"
 Coal...1'1"
 Bone...0'6"
 Coal...3'5"
 Slate...0'3"
 Slate...0'1"
 Coal...3'7"
 Coal...3'10"
 Coal...3'2"
 Slate...0'13"
 Coal...0'8"
 Coal...3'7"
 Bone & Coal...0'8"
 Coal...1'10"
 Rock...0'2"
 Coal...0'7"
 Bone & Slate...0'2"
 Coal...0'2"
 Coal...2'2"
 Bone...0'4"
 Coal...0'6"
 Coal...2'10"
 Coal...2'10"
 Retain...0'11"
 Total...2'11"

A B C D E F G H

BED SECTIONS

THE HUDSON COAL CO

*Map
Showing
The*

BOT ROSS BED

AT LOREE COLLY

Scale 1" = 400'

*Office Of The
Forecast Dept.*

April 2, 1927