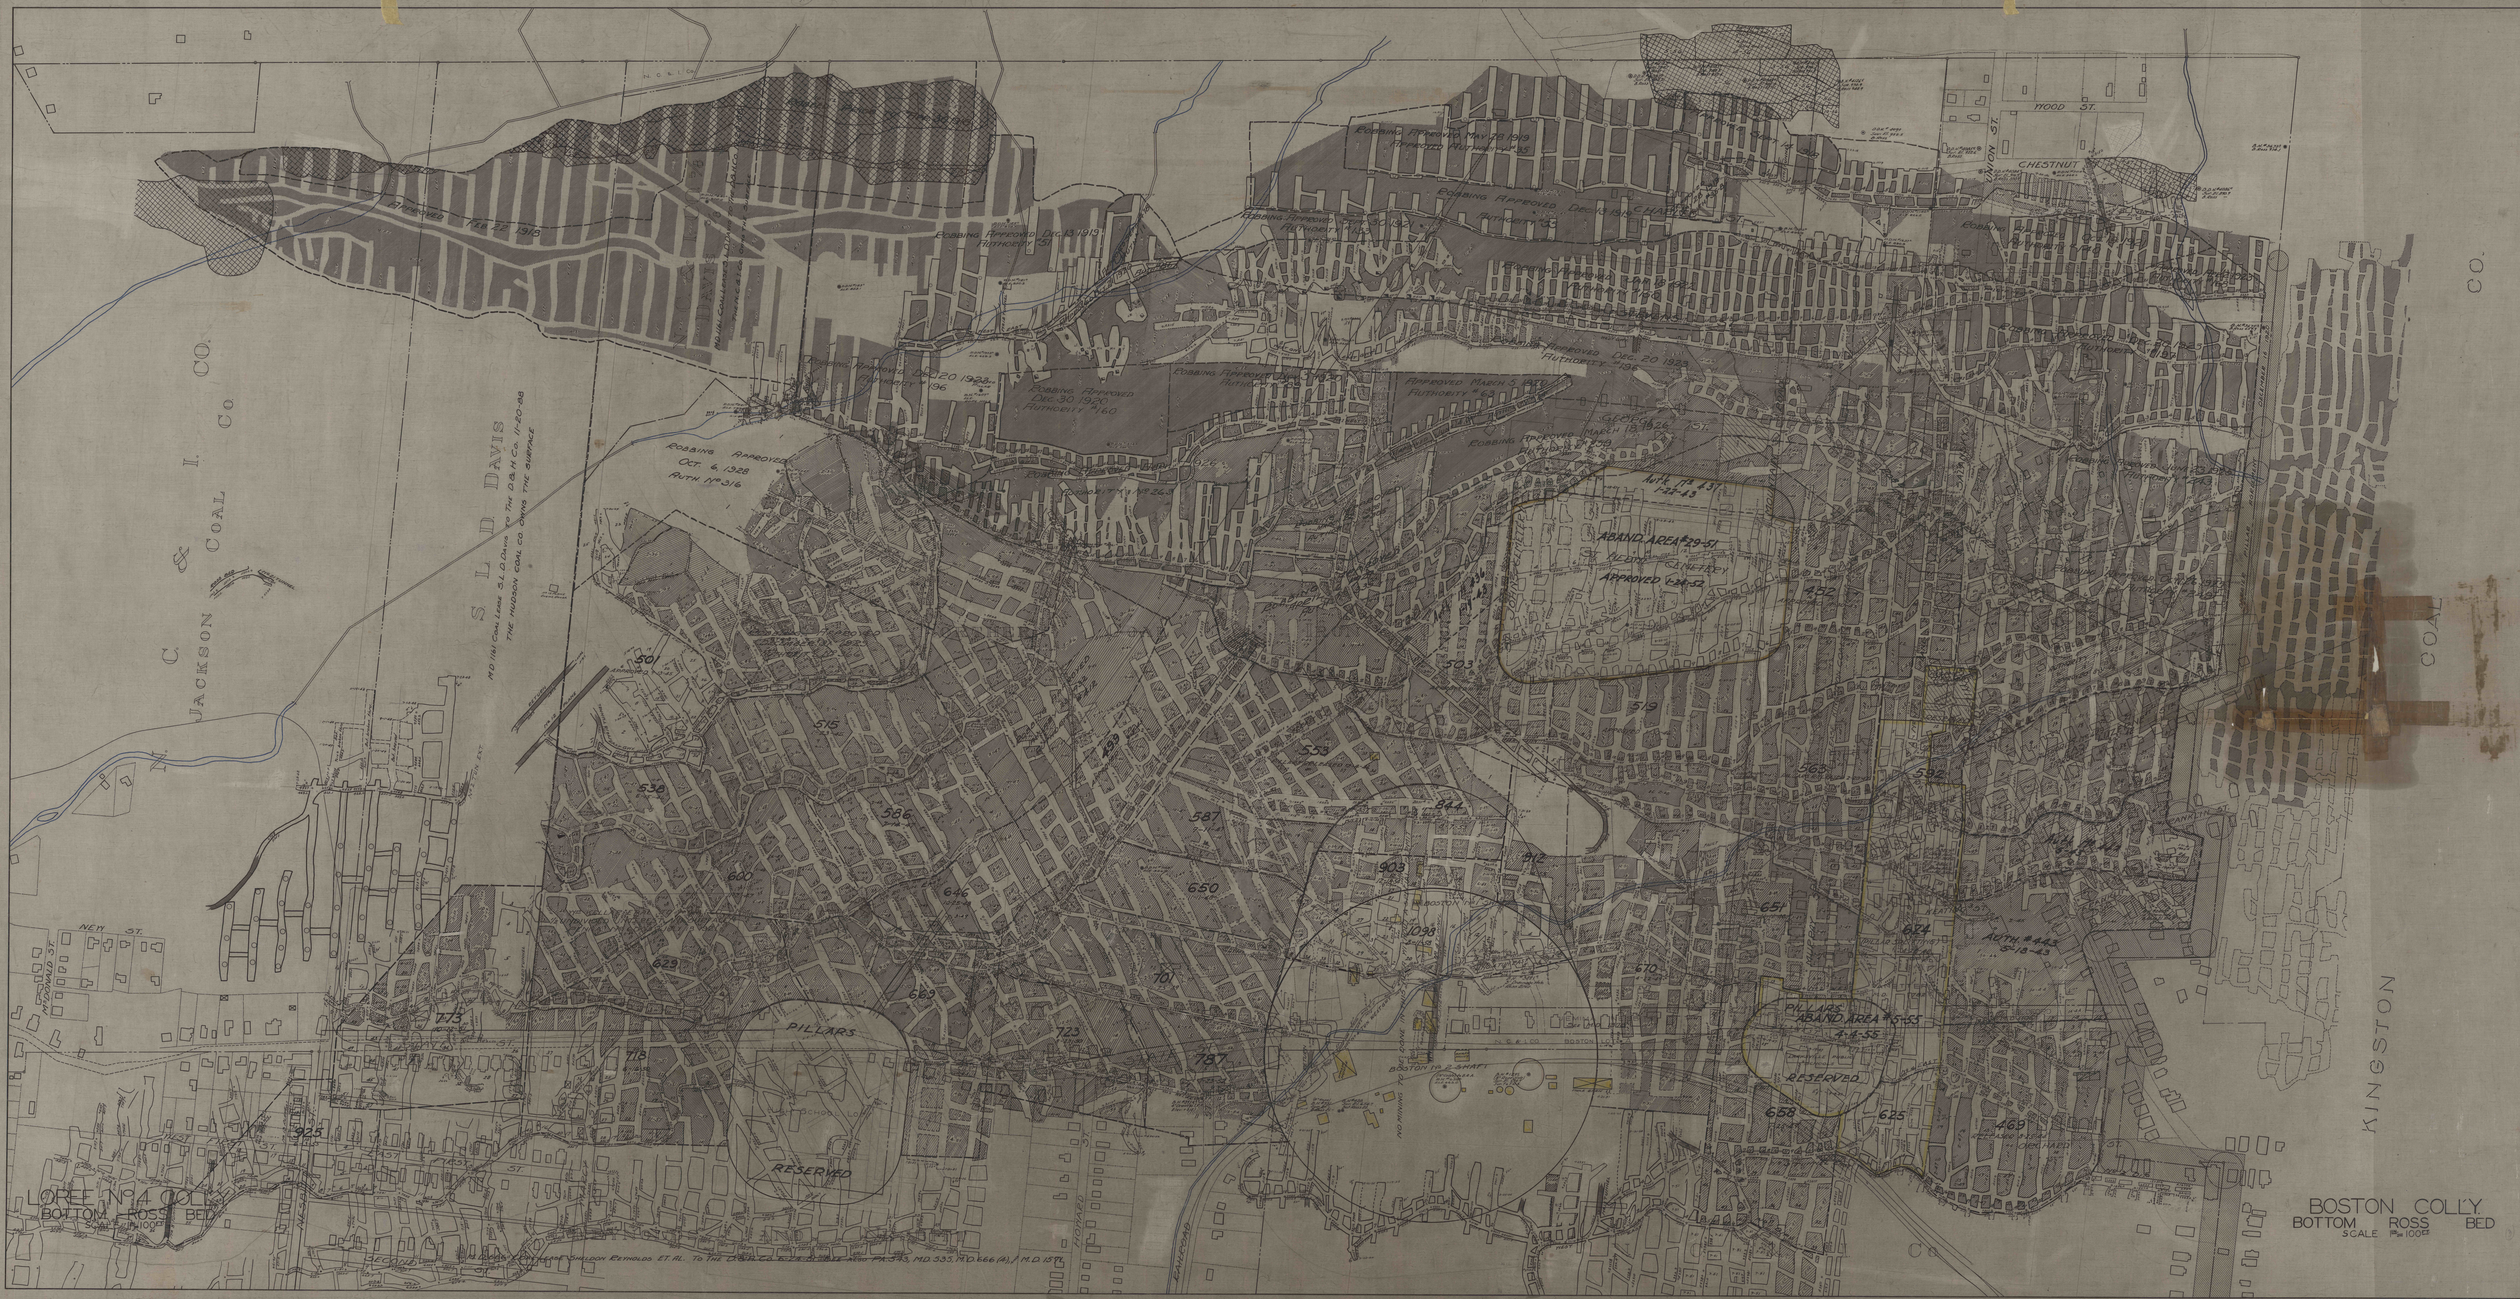

LOREE NO. 4 COLLY.
BOTTOM ROSS BED
SCALE 1"=100'
BOSTON COLLY.
BOTTOM ROSS BED
SCALE 1"=100'
KINGSTON COAL CO.
J. C. JACKSON COAL & I. CO.
S. L. D. DAVIS
THE HUDSON COAL CO. OWNS THE SURFACE
MOYER COAL LAND CO. TO THE D & H CO. 1-20-38
Robbins Approved Oct. 6, 1928 Auth. No. 316
Robbins Approved Dec. 20 1928 Authority 196
Robbins Approved Dec. 30, 1940 Authority 460
Robbins Approved Dec. 13 1919 Authority 151
Robbins Approved Dec. 20 1928 Authority 196
Approved March 5 1917 Authority
Robbins Approved Dec. 13 1919 Authority 151
Robbins Approved Dec. 20 1928 Authority 196
Robbins Approved Dec. 30, 1940 Authority 460
Robbins Approved Dec. 13 1919 Authority 151
Robbins Approved Dec. 20 1928 Authority 196
Approved March 5 1917 Authority
Robbins Approved Dec. 20 1928 Authority 196
Robbins Approved Dec. 13 1919 Authority 151