


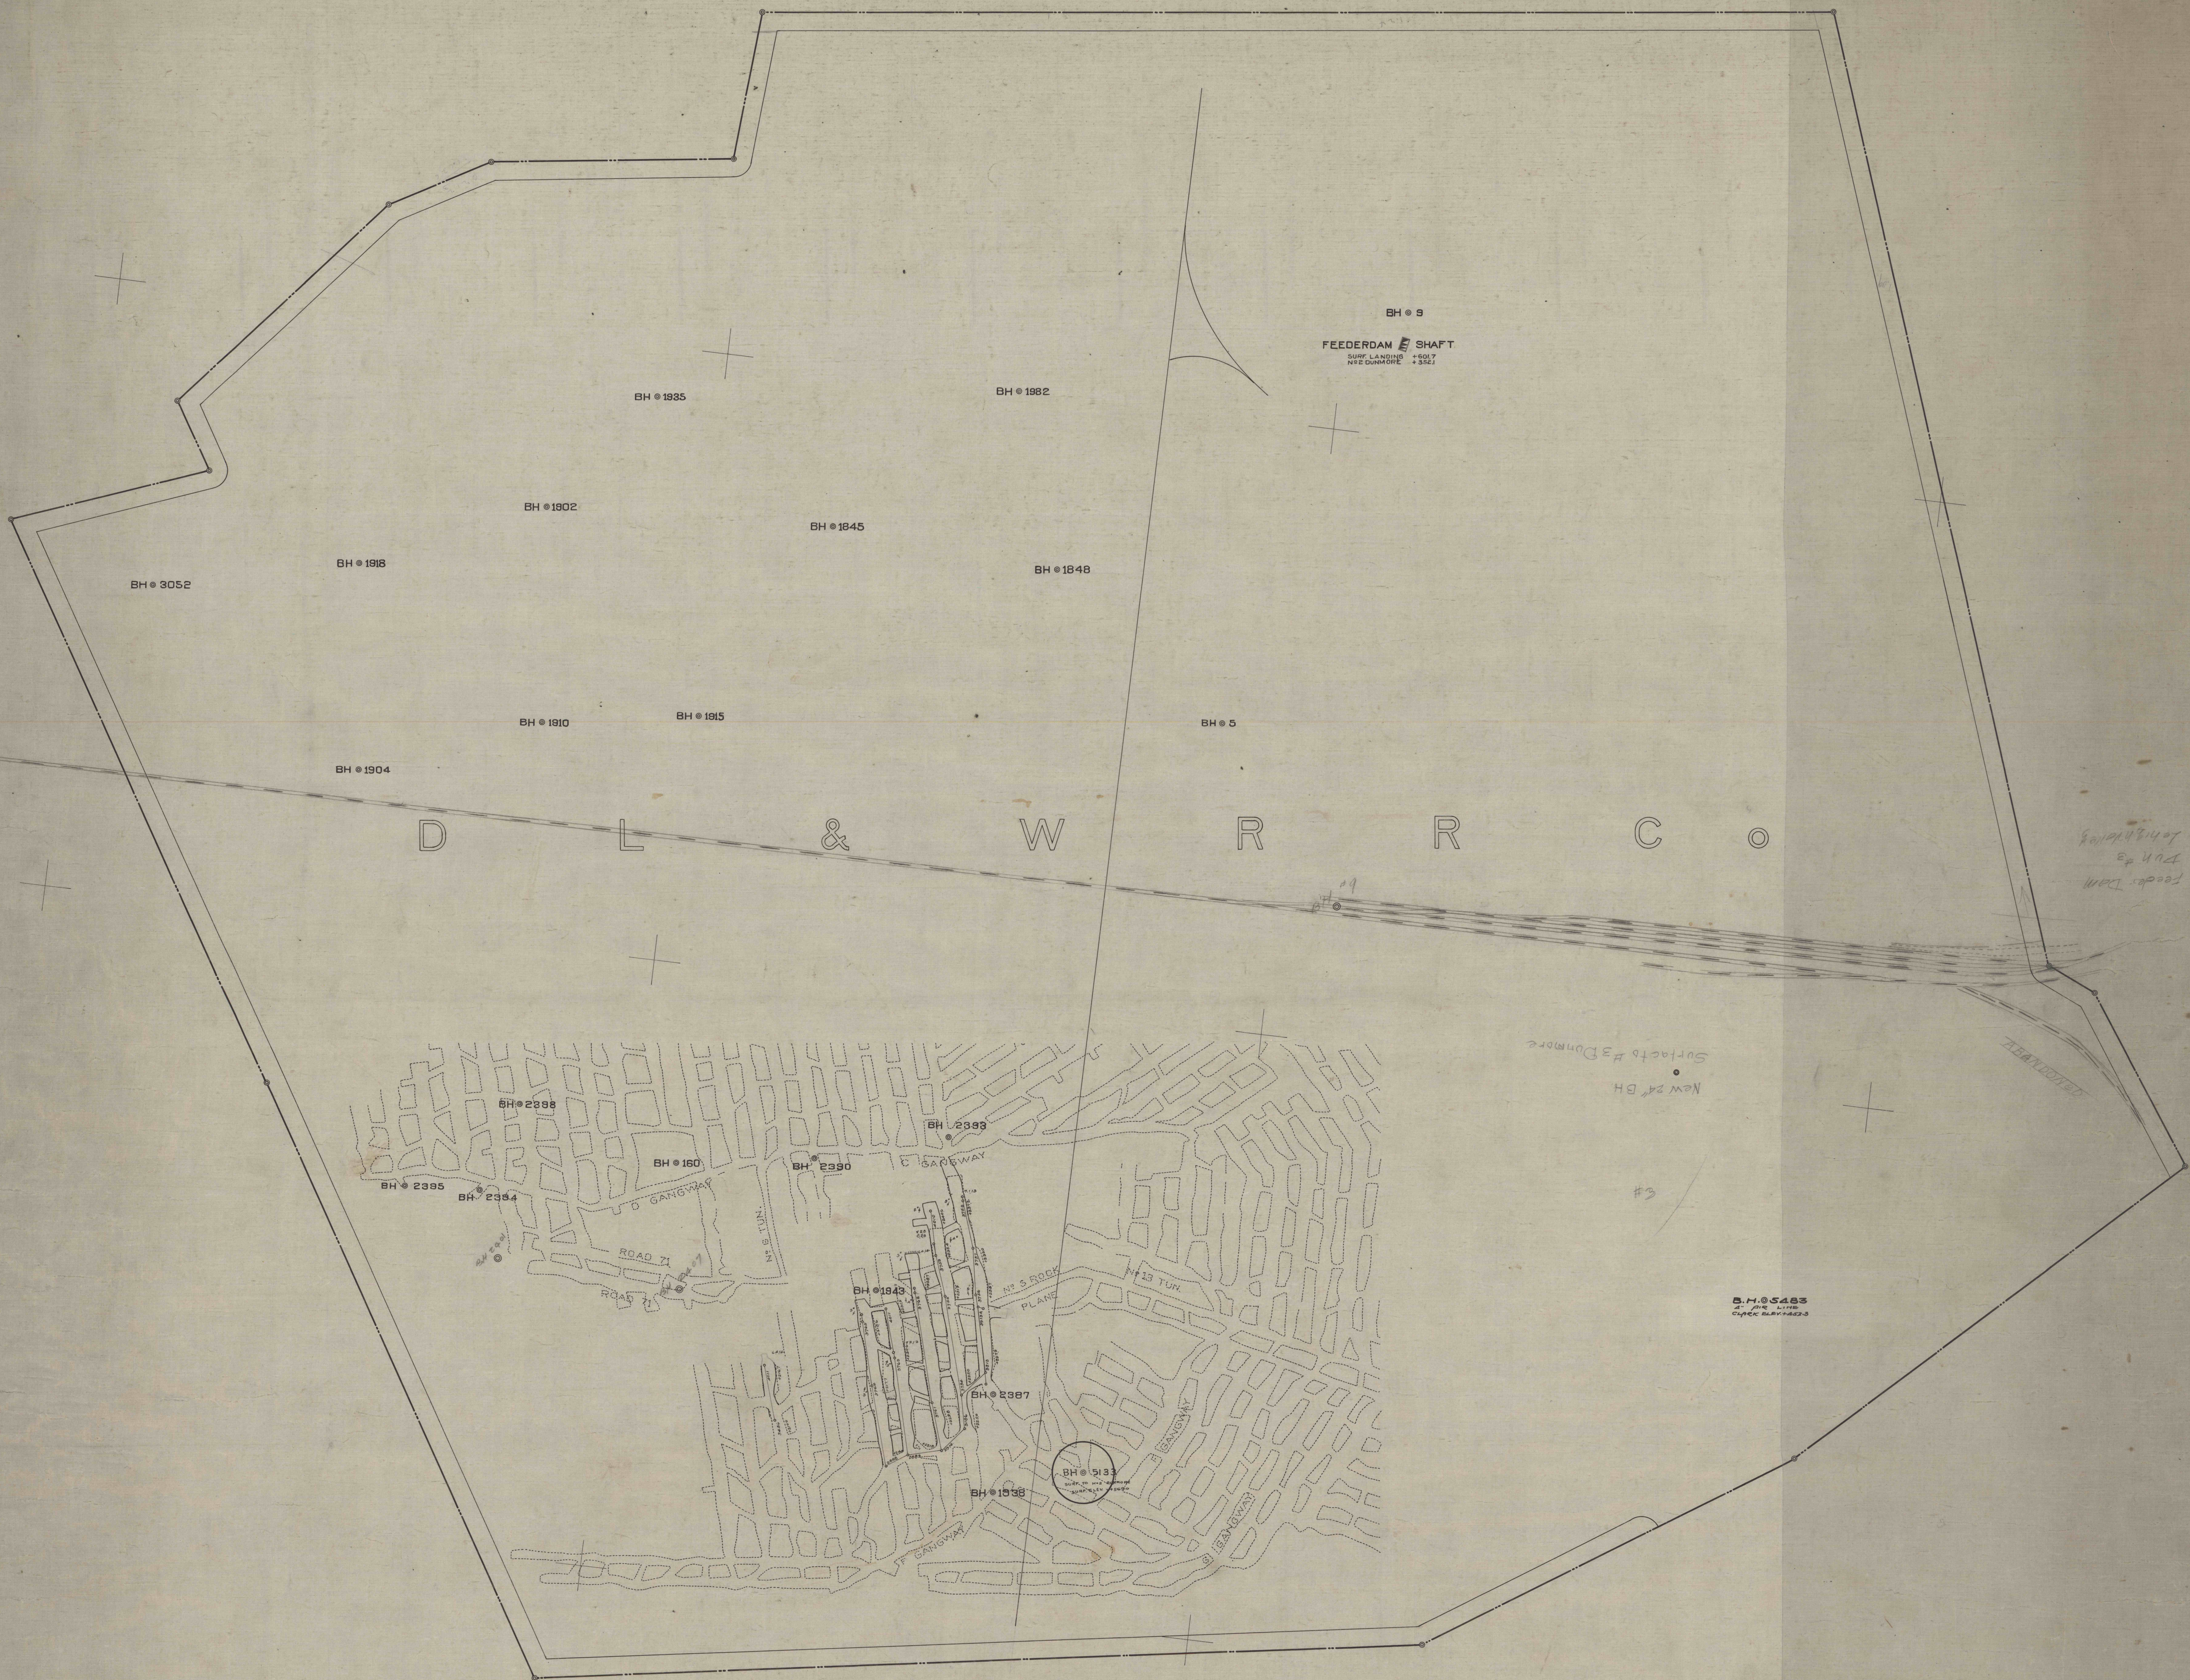

MAP
OF
HALLSTEAD COLLIERY

No 3 DUNMORE VEIN. ———
TOP SPLIT
No 3 DUNMORE VEIN. —

SCALE 1"=100'