


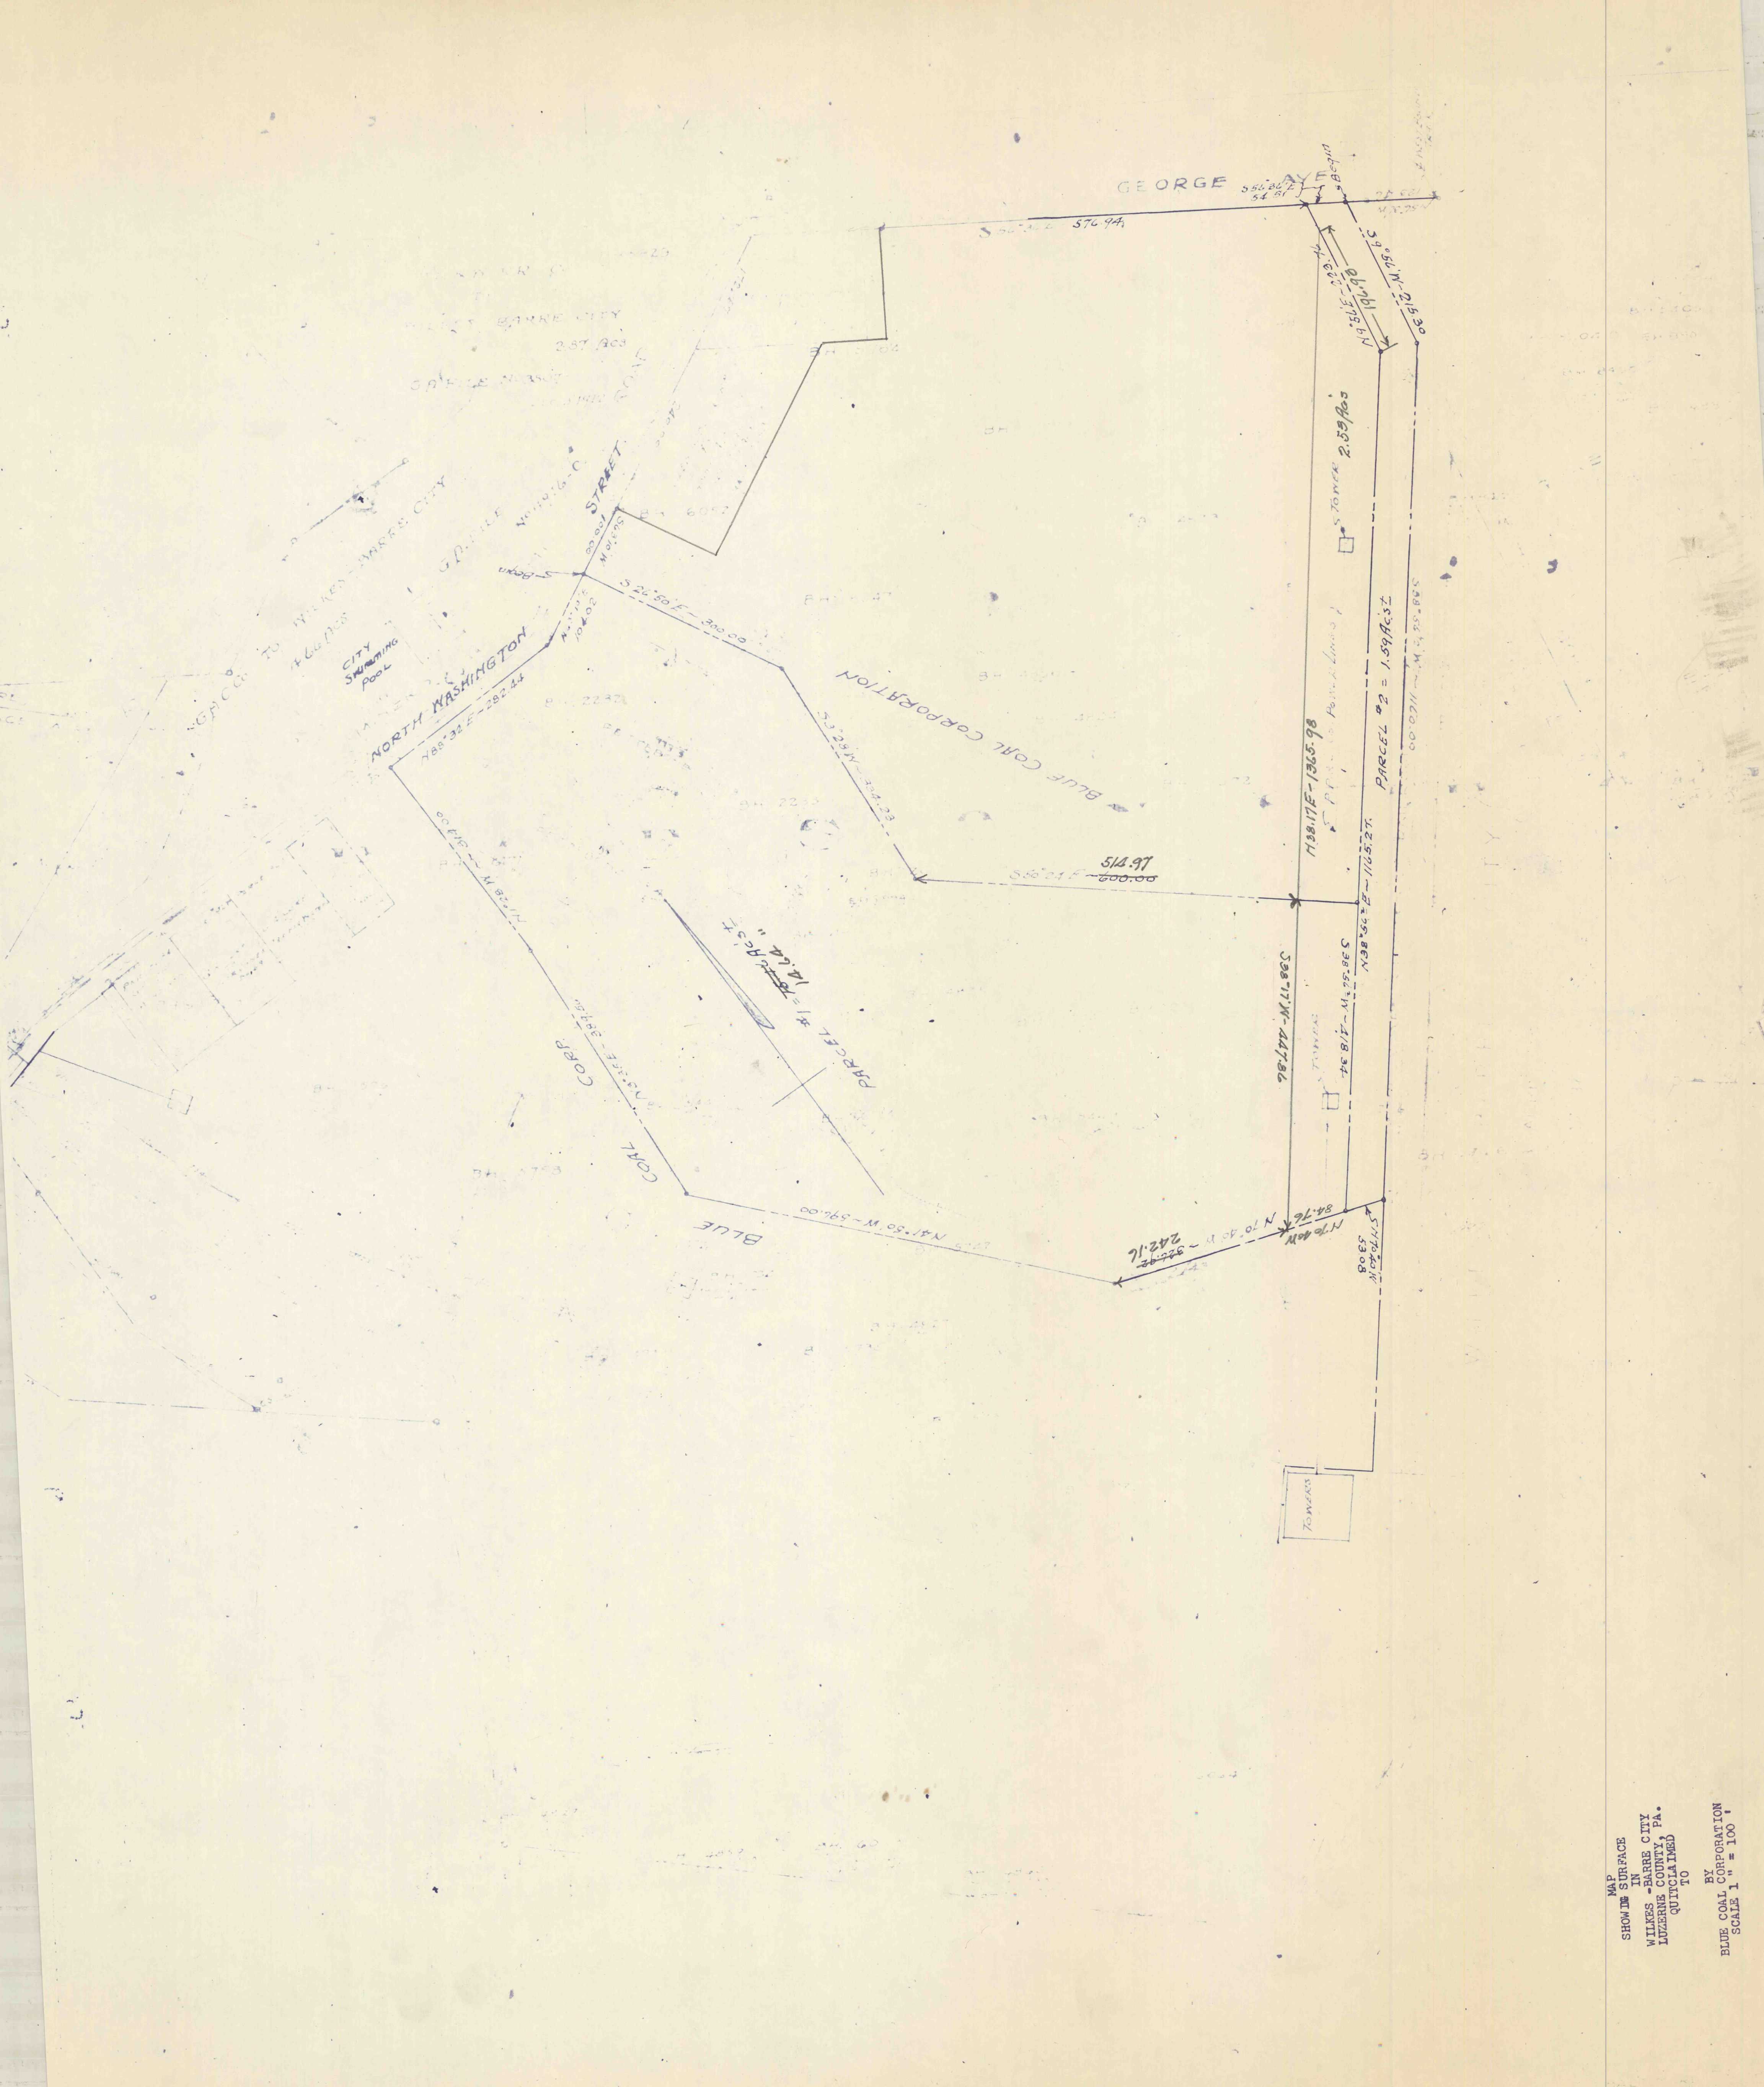

MAP
SHOWING SURFACE
IN
WILKES-BARRE CITY
QUITCLAIMED
TO
BY
BLUE COAL CORPORATION
SCALE 1" = 100'