


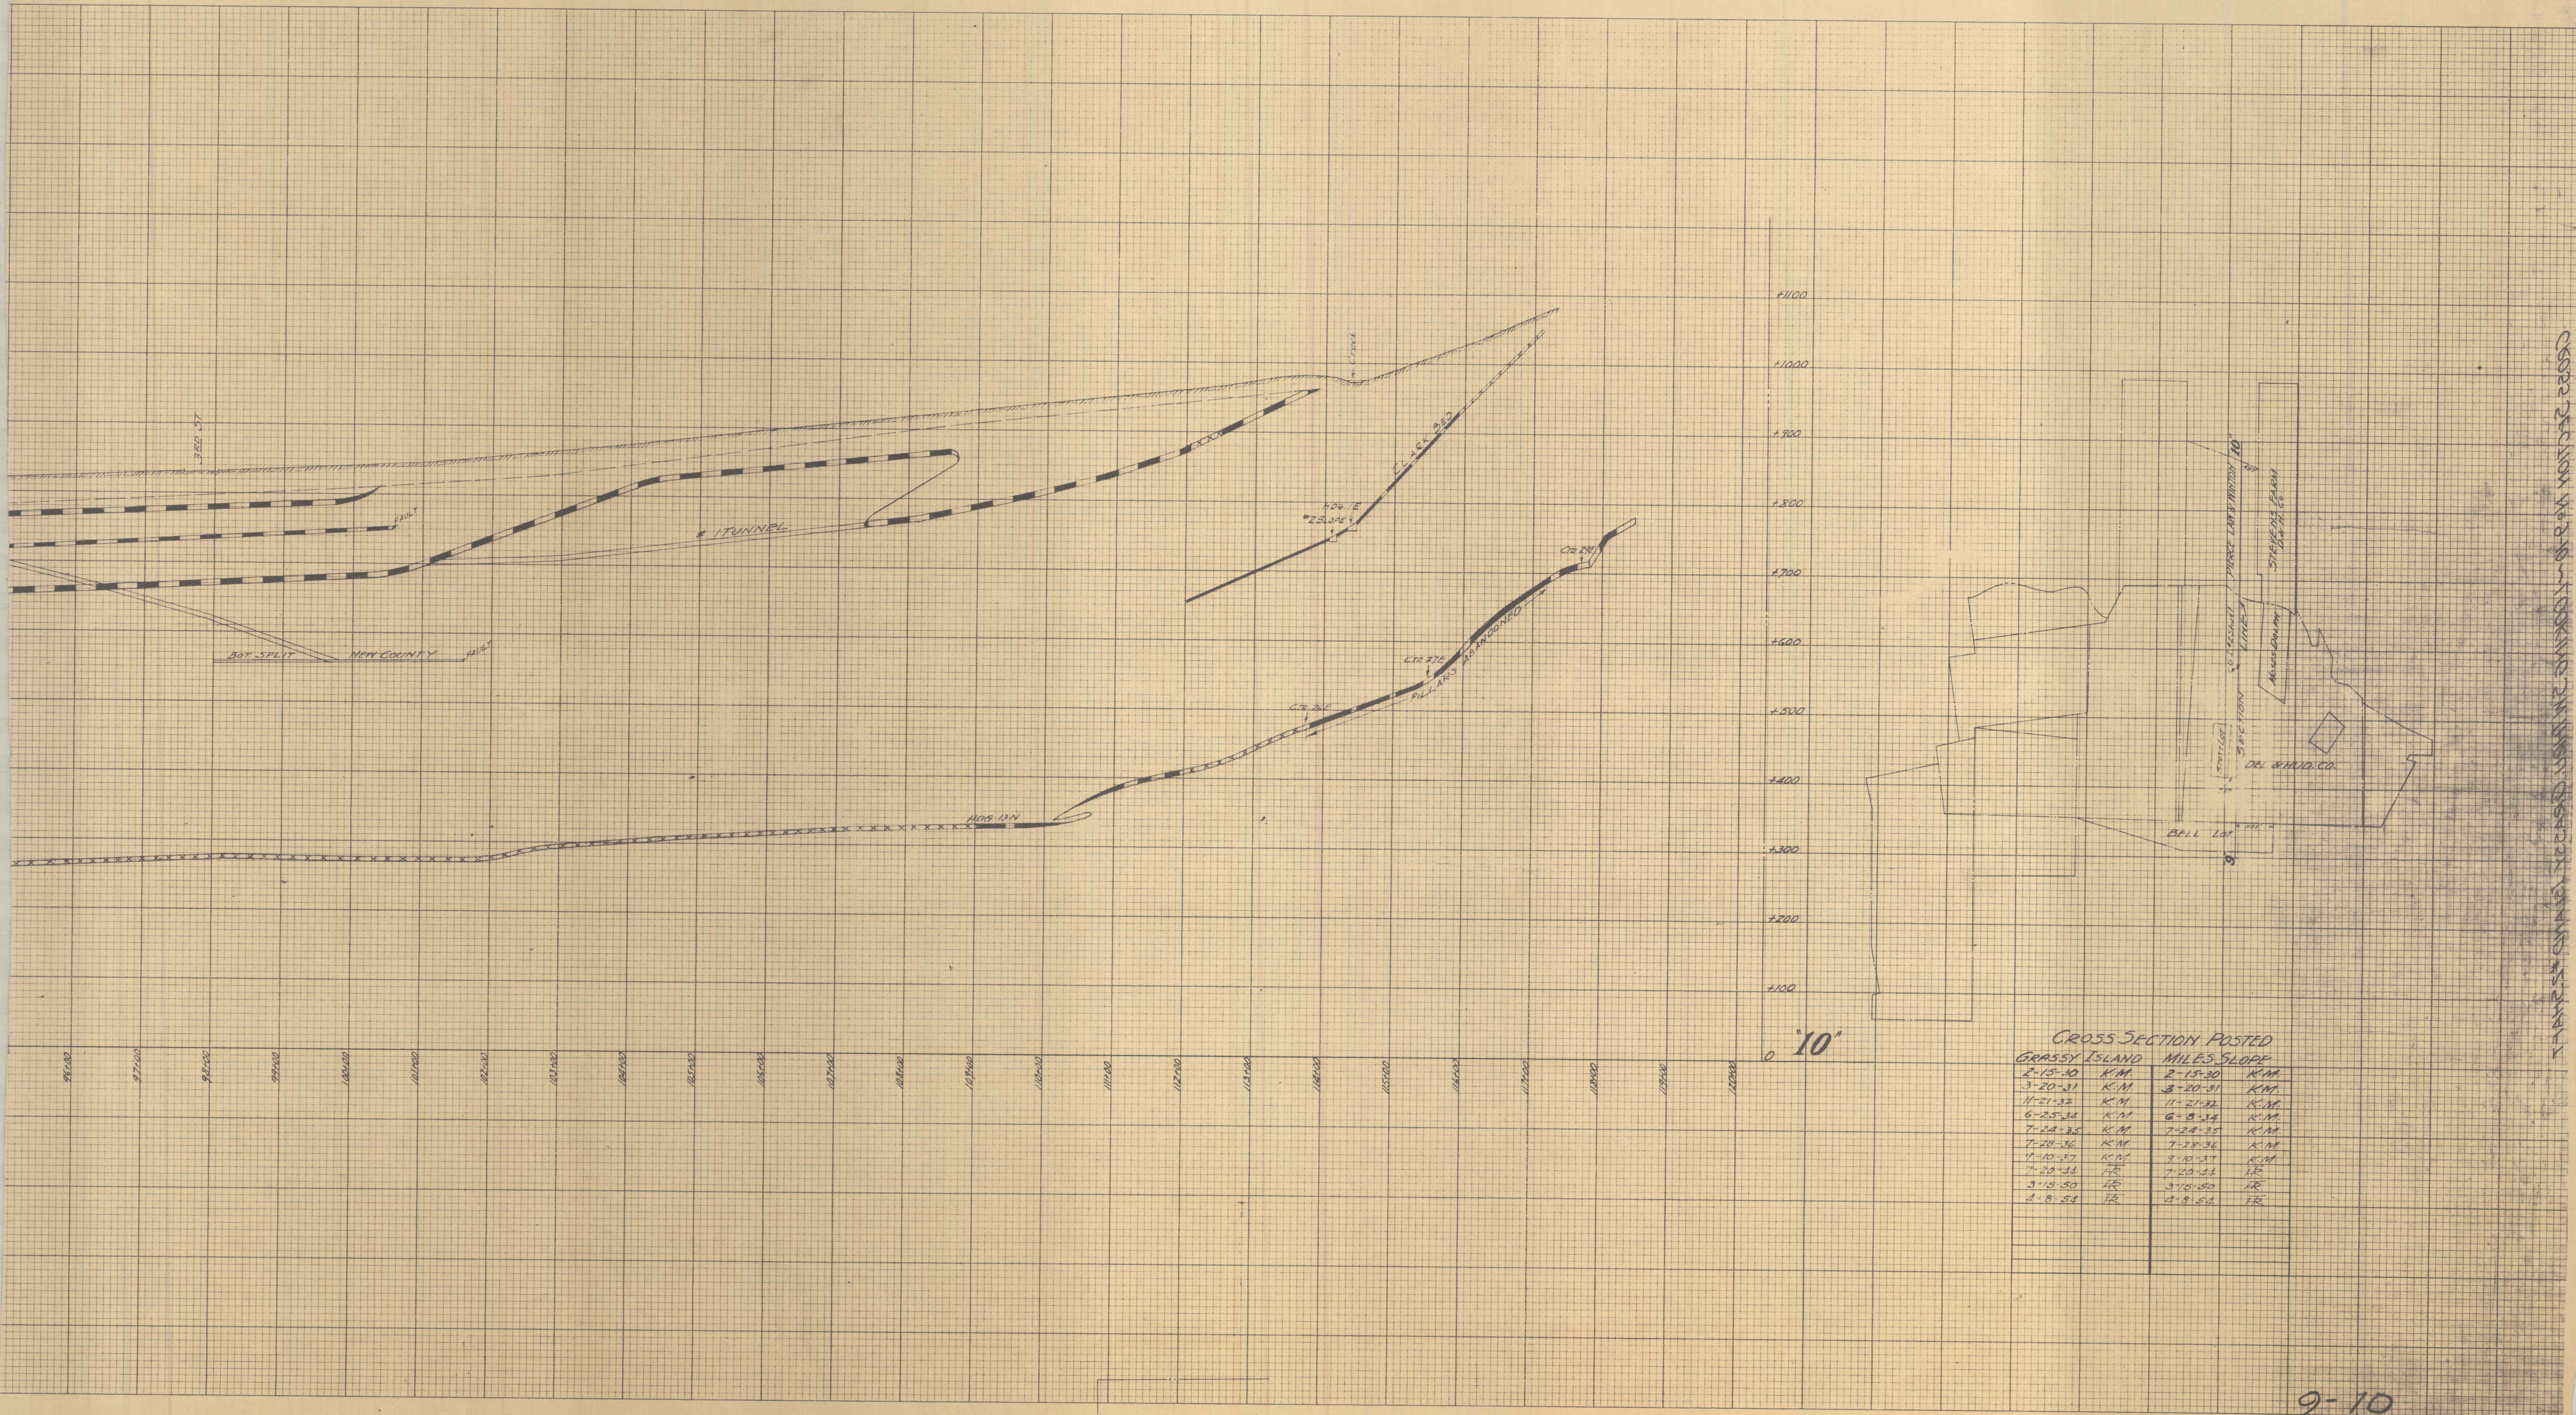

CROSS-SECTION POSTED
GRASSY ISLAND MILES SLOPE

2-15-30	K.M.	2-15-30	K.M.
3-20-31	K.M.	3-20-31	K.M.
11-21-32	K.M.	11-21-32	K.M.
6-25-34	K.M.	6-25-34	K.M.
7-24-35	K.M.	7-24-35	K.M.
7-28-36	K.M.	7-28-36	K.M.
9-10-37	K.M.	9-10-37	K.M.
7-20-38	K.M.	7-20-38	K.M.
3-15-50	K.M.	3-15-50	K.M.
2-8-54	K.M.	2-8-54	K.M.

CROSS-SECTION NO. 210 - 1000' SLOPE - 100' HORIZ. DIST. - 10' VERT. DIST.