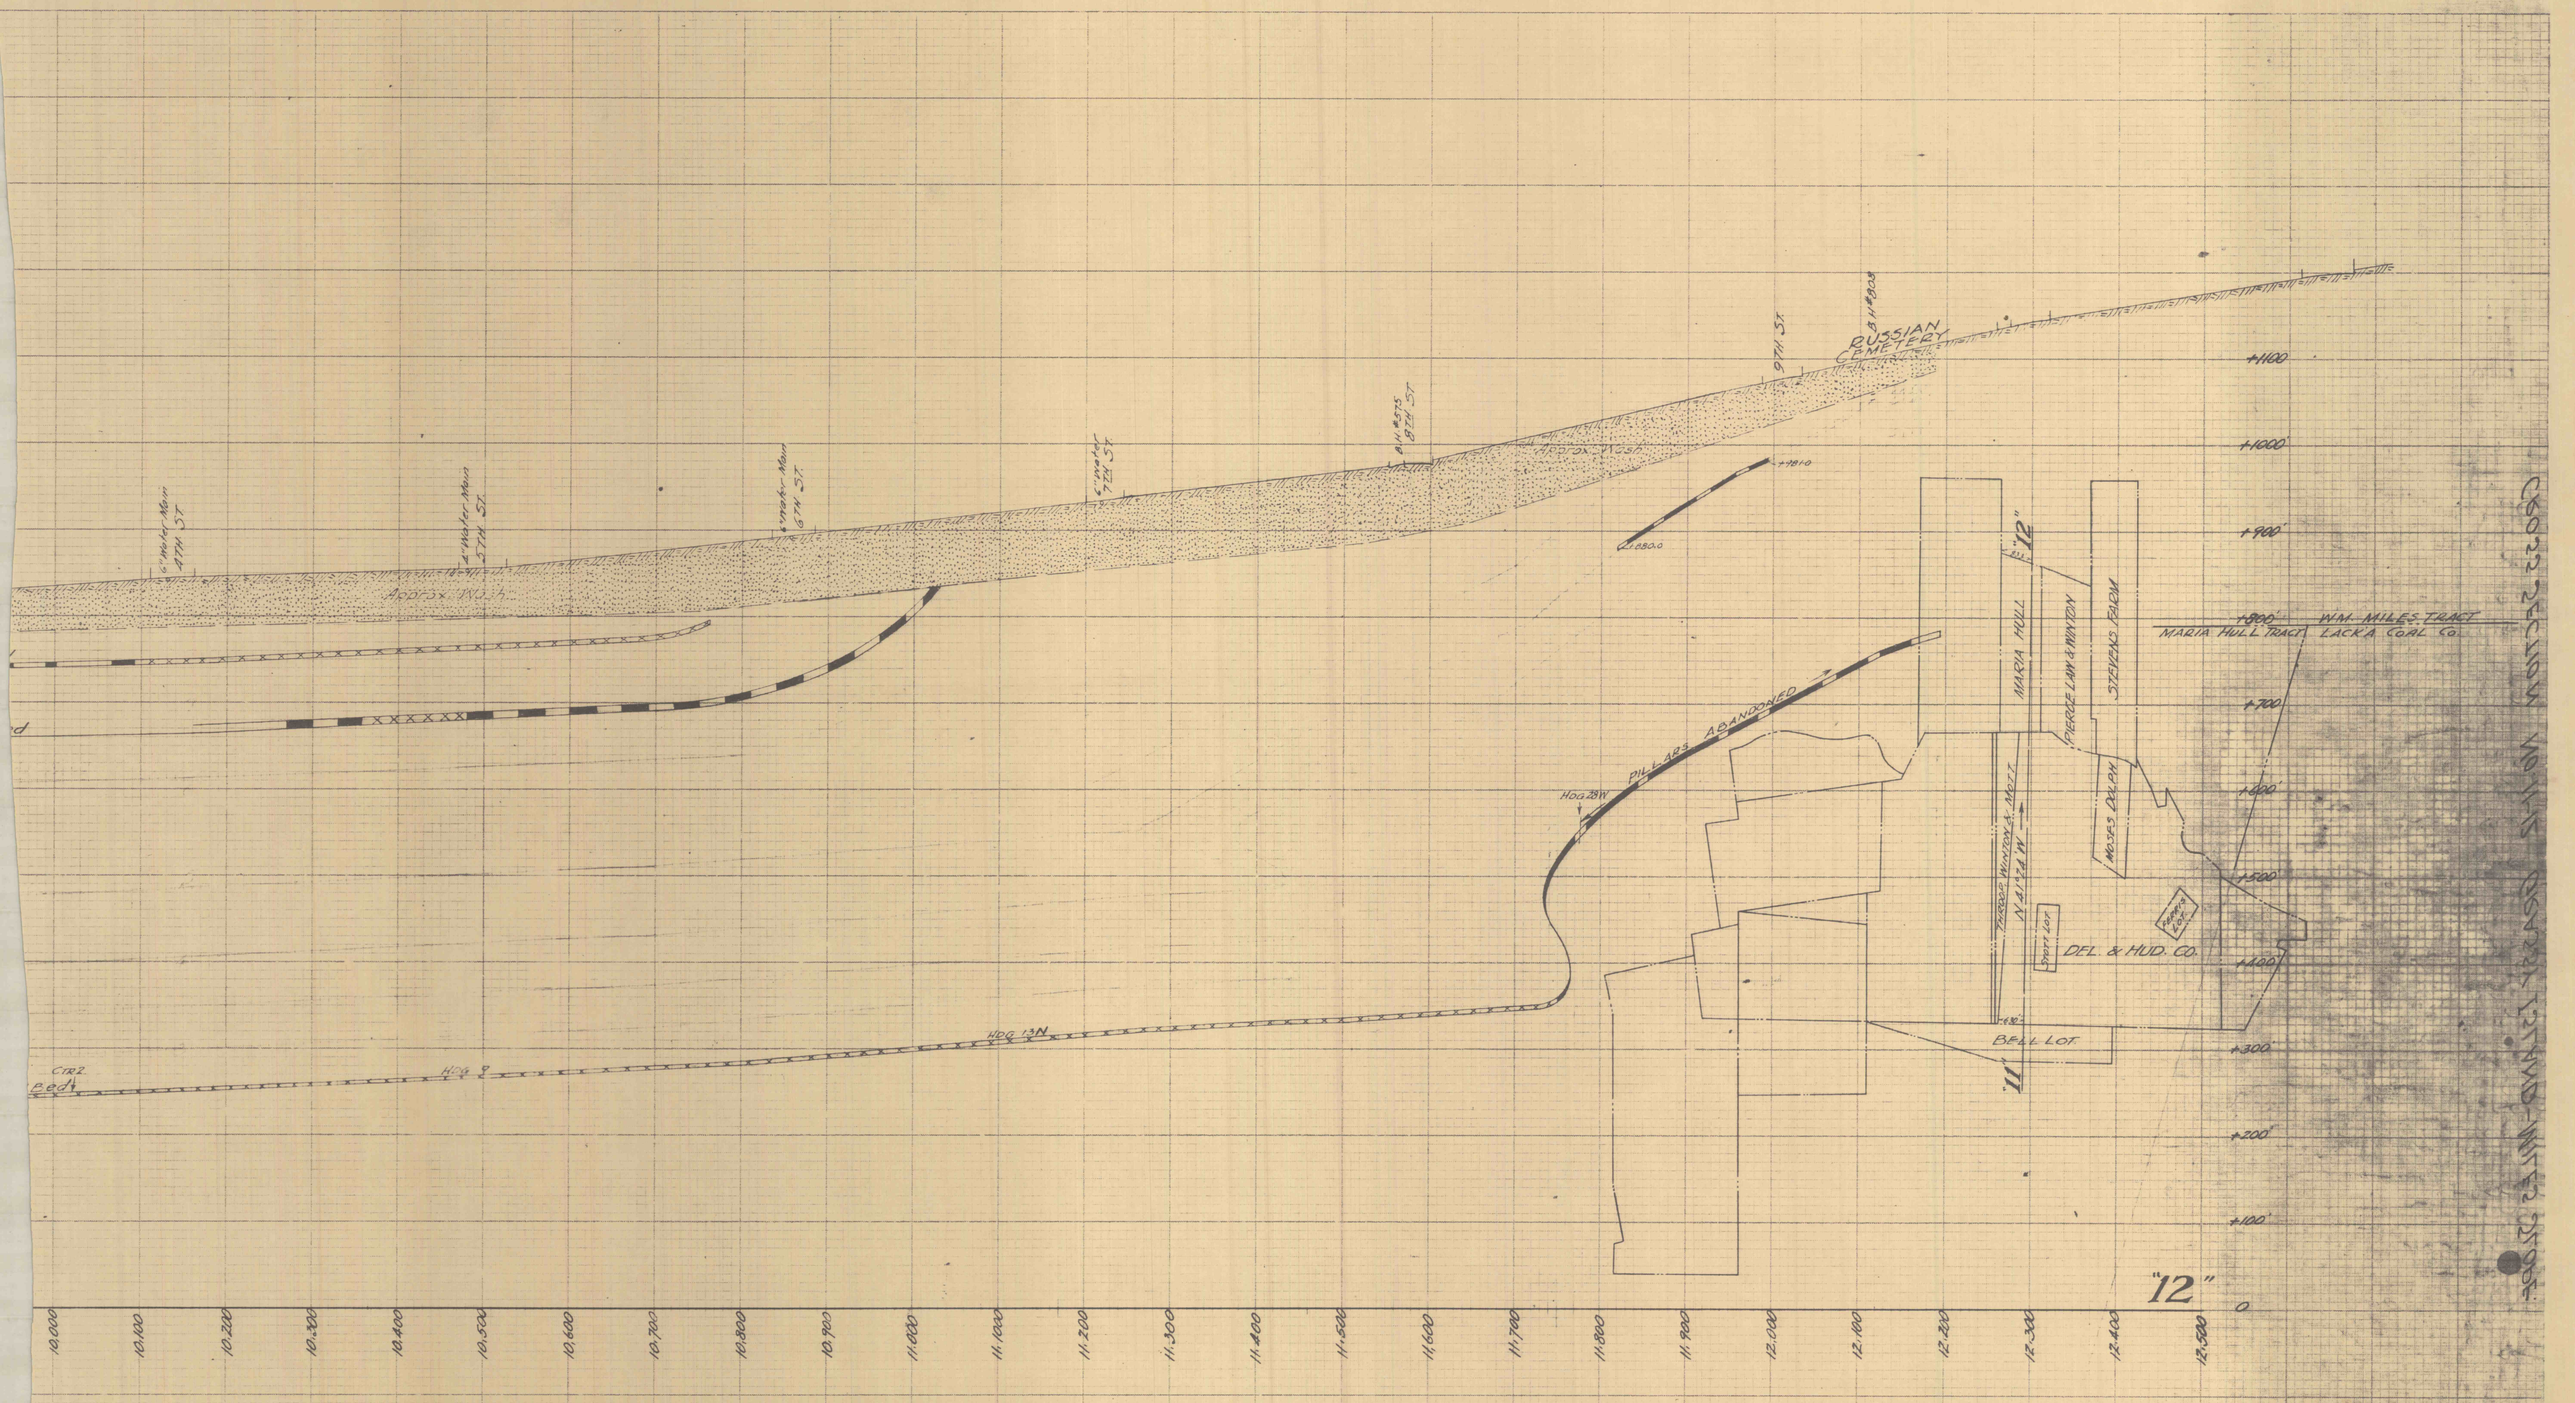

POSTED	BY	POSTED	BY
7-10-30	K.M.		
3-20-31	K.M.		
11-21-32	K.M.		
6-25-34	K.M.		
7-25-35	K.M.		
7-27-36	R.S.-K.M.		
9-10-37	K.M.		
7-24-44	H.R.		
8-4-50	H.R.		
4-9-54	H.R.		

11-12