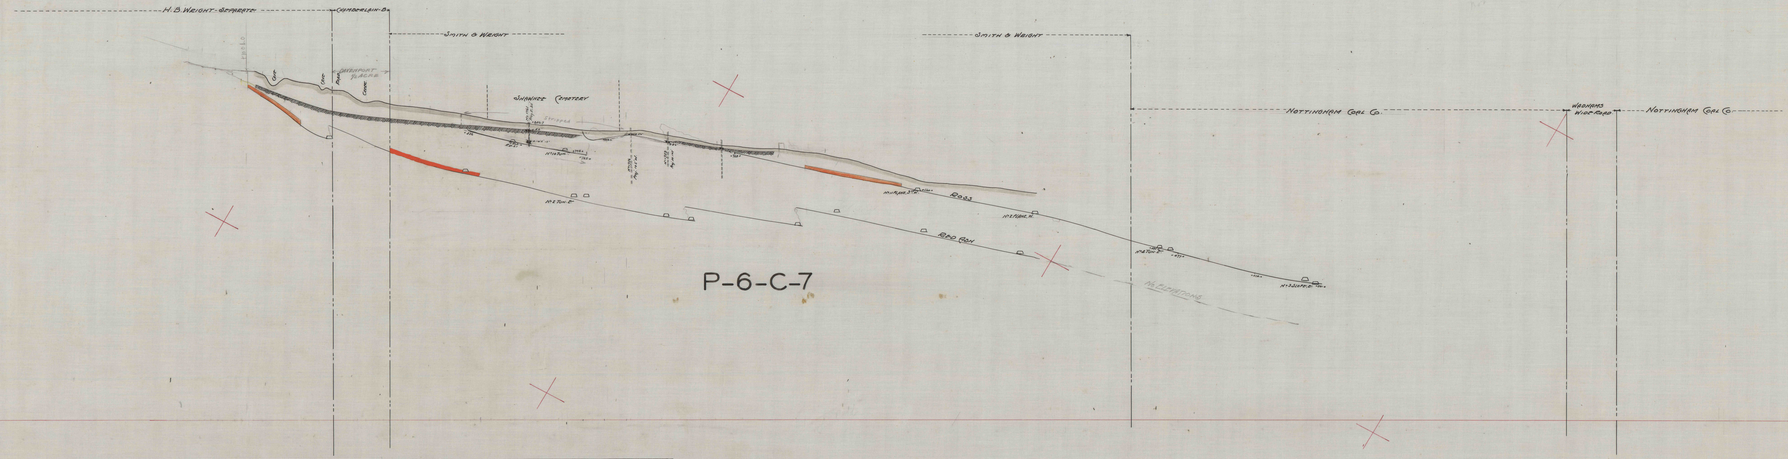

P-6-C-7

Print	Dates Proved																	
Base	1-11-33 P	31-3-33	1-11-33	1-11-33	3-11-33	1-11-33	3-11-33	/	1-11-33	21-3-33	4.3.33	/	21-11-33	21-11-33	21-11-33	24-11-33	24-11-33	
Pencil	14-11-33 P	"	"	"	/	"	"	8-12-33	"	27-11-33	"	"	21-11-33	21-11-33	"	"	"	

In Service June 1934 P.C.