


400' Bottom Station 1610

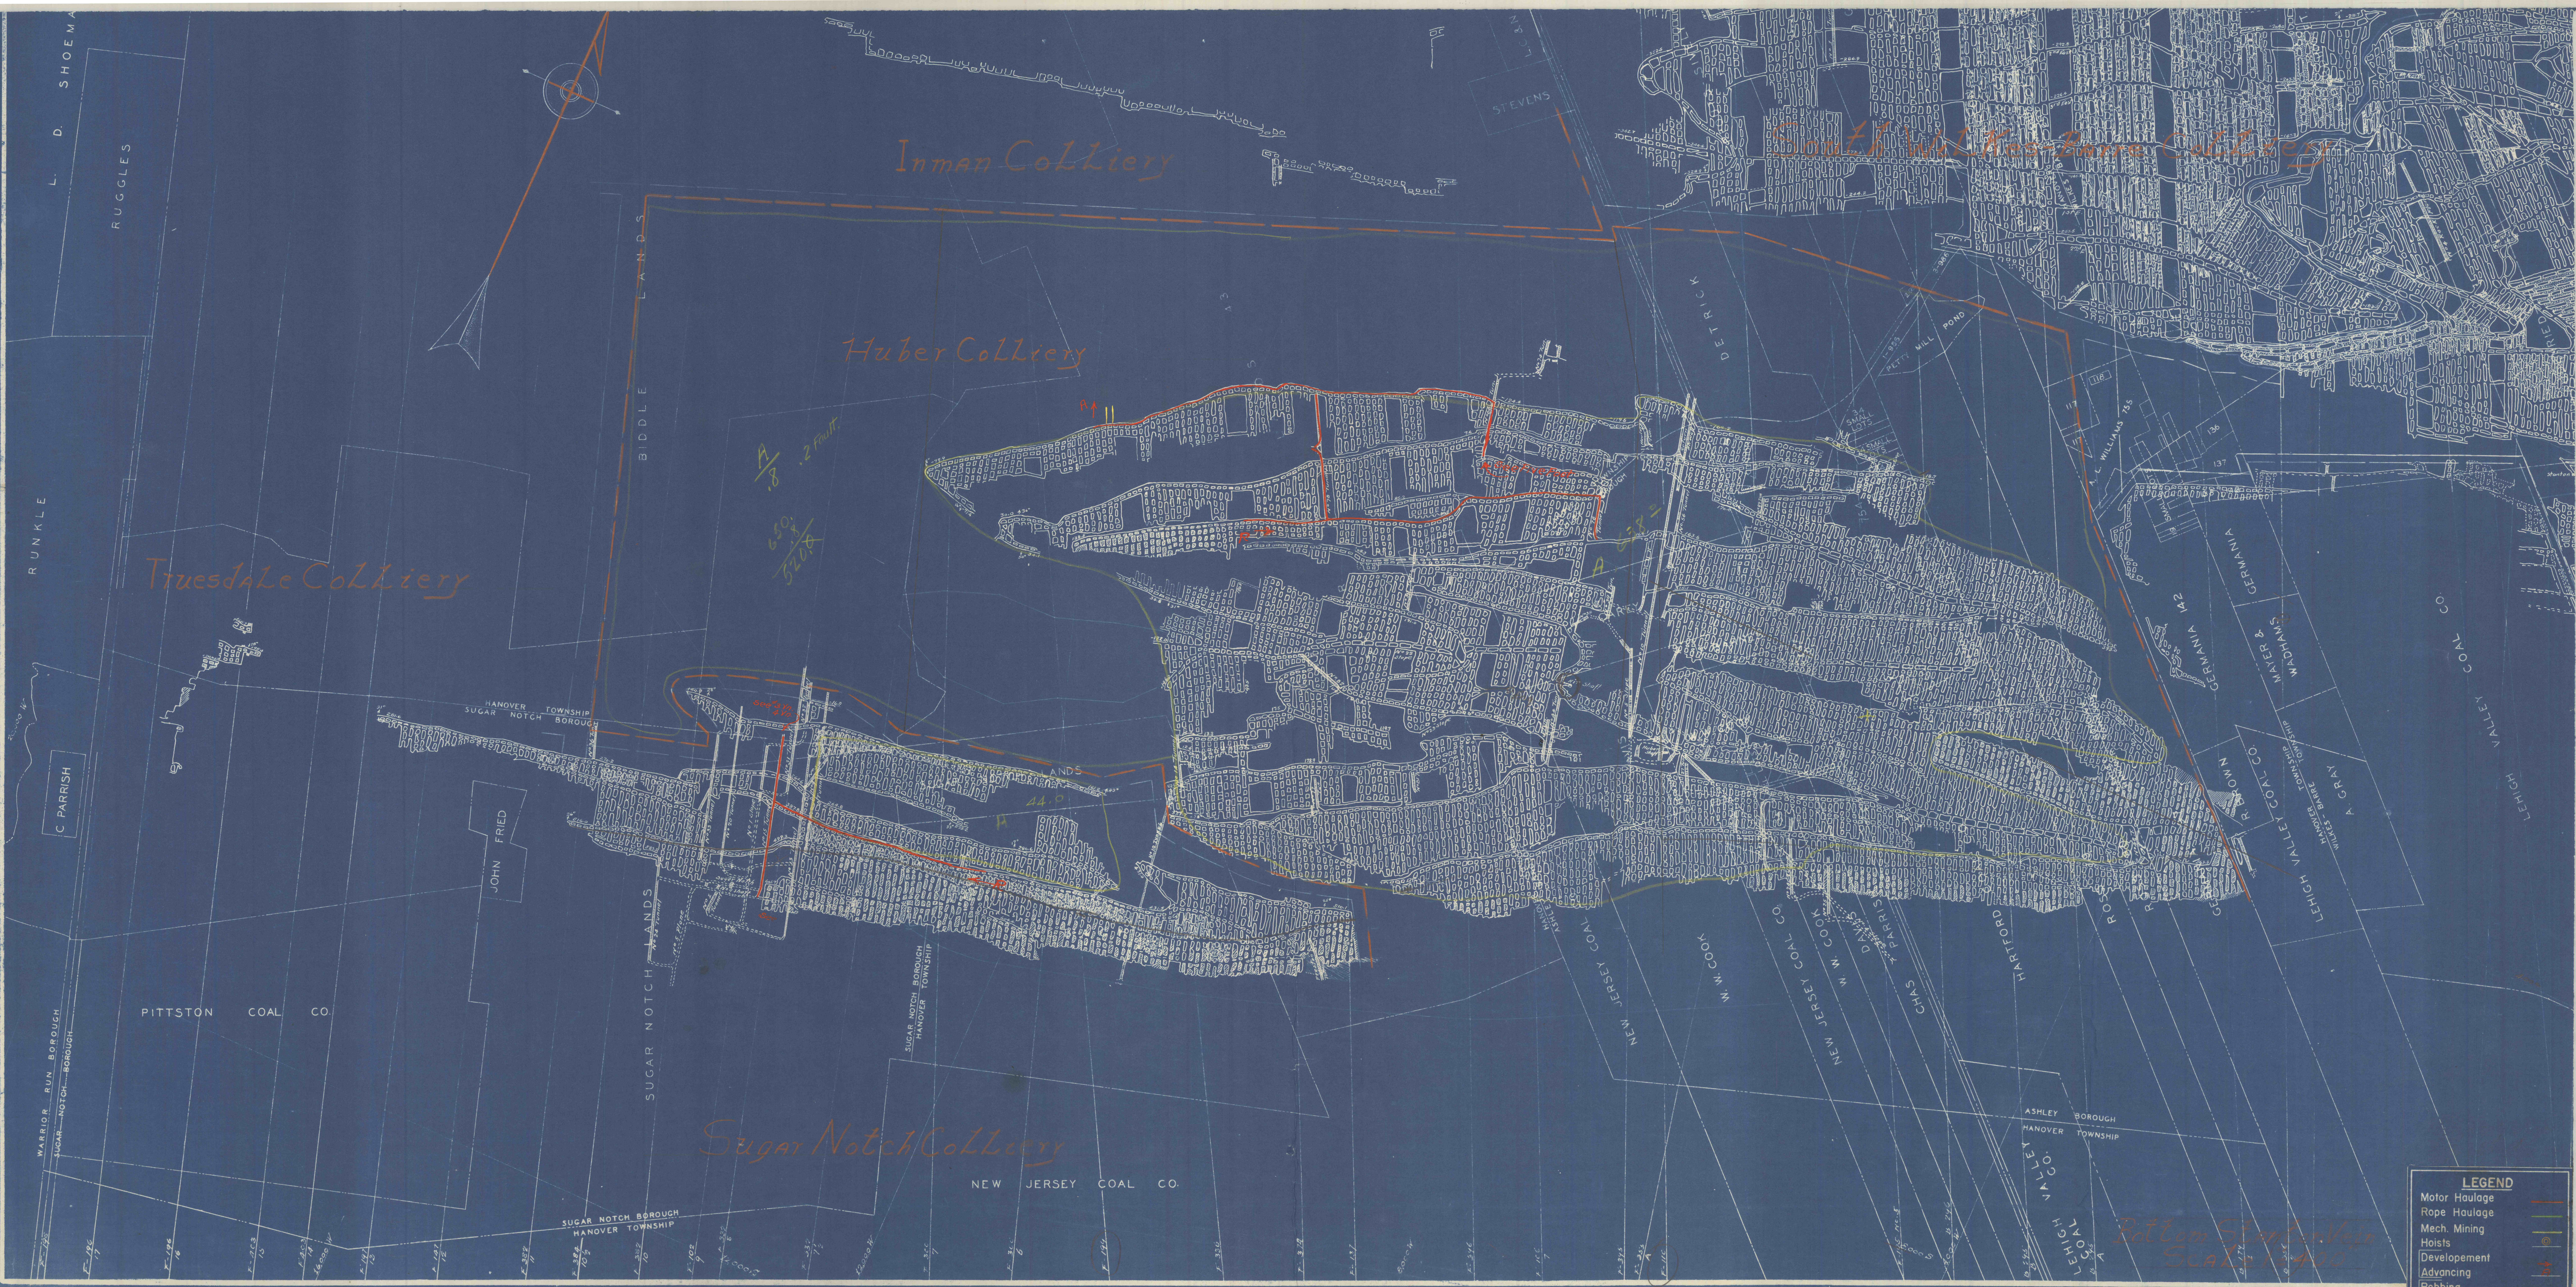

LEGEND

- Motor Haulage
- Rope Haulage
- Mech. Mining
- Hoists
- Development
- Advancing
- Robbing
- Retreating

Bottom Station 1610
Scale 1/400