


60.00

SECTION D-5000

6000 S.

5000 S.

4000 S.

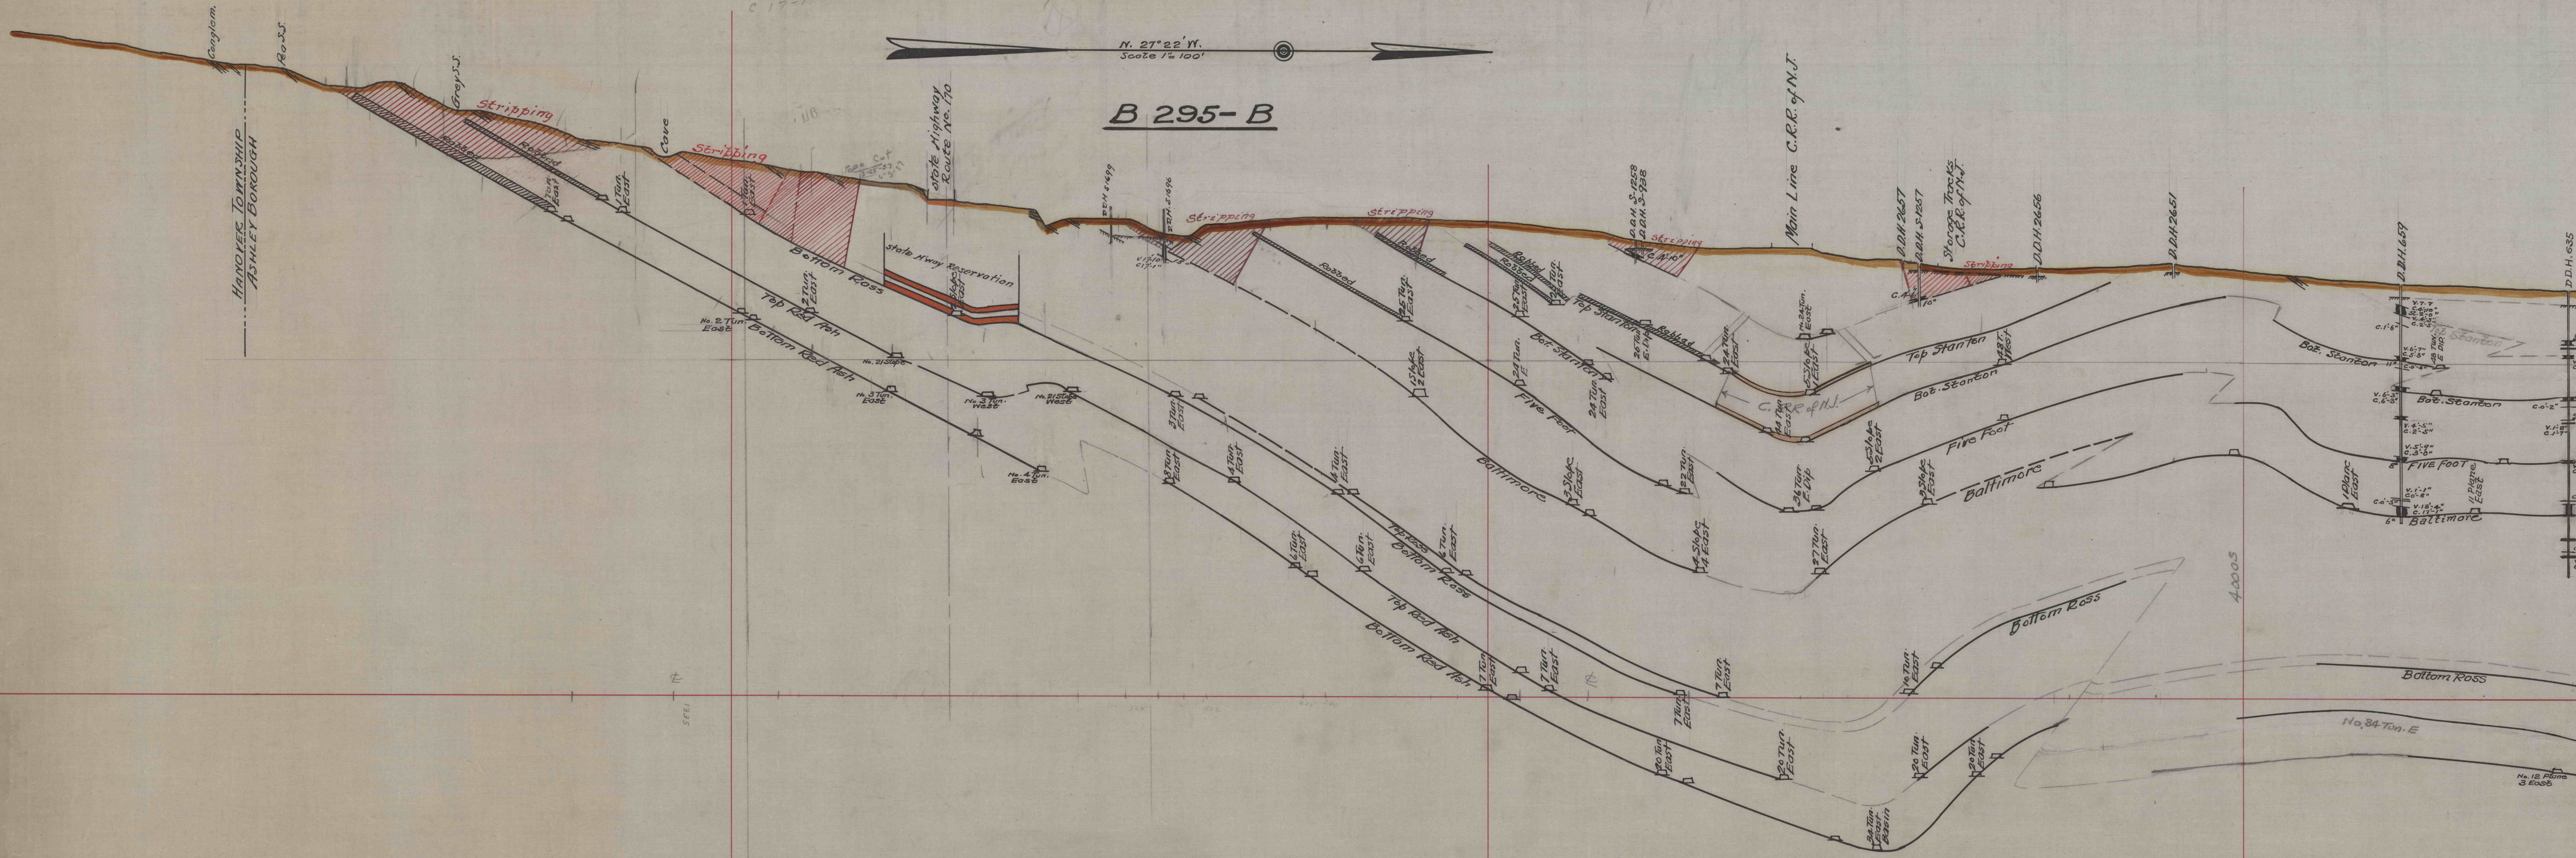

HANOKEE TOWNSHIP
ASHLEY BOROUGH

B 295-B

Main Line C.R.R. of N.J.

Bottom Ross

Bottom Ross

No. 24 Tun. E

No. 12 Flina
3 6000