


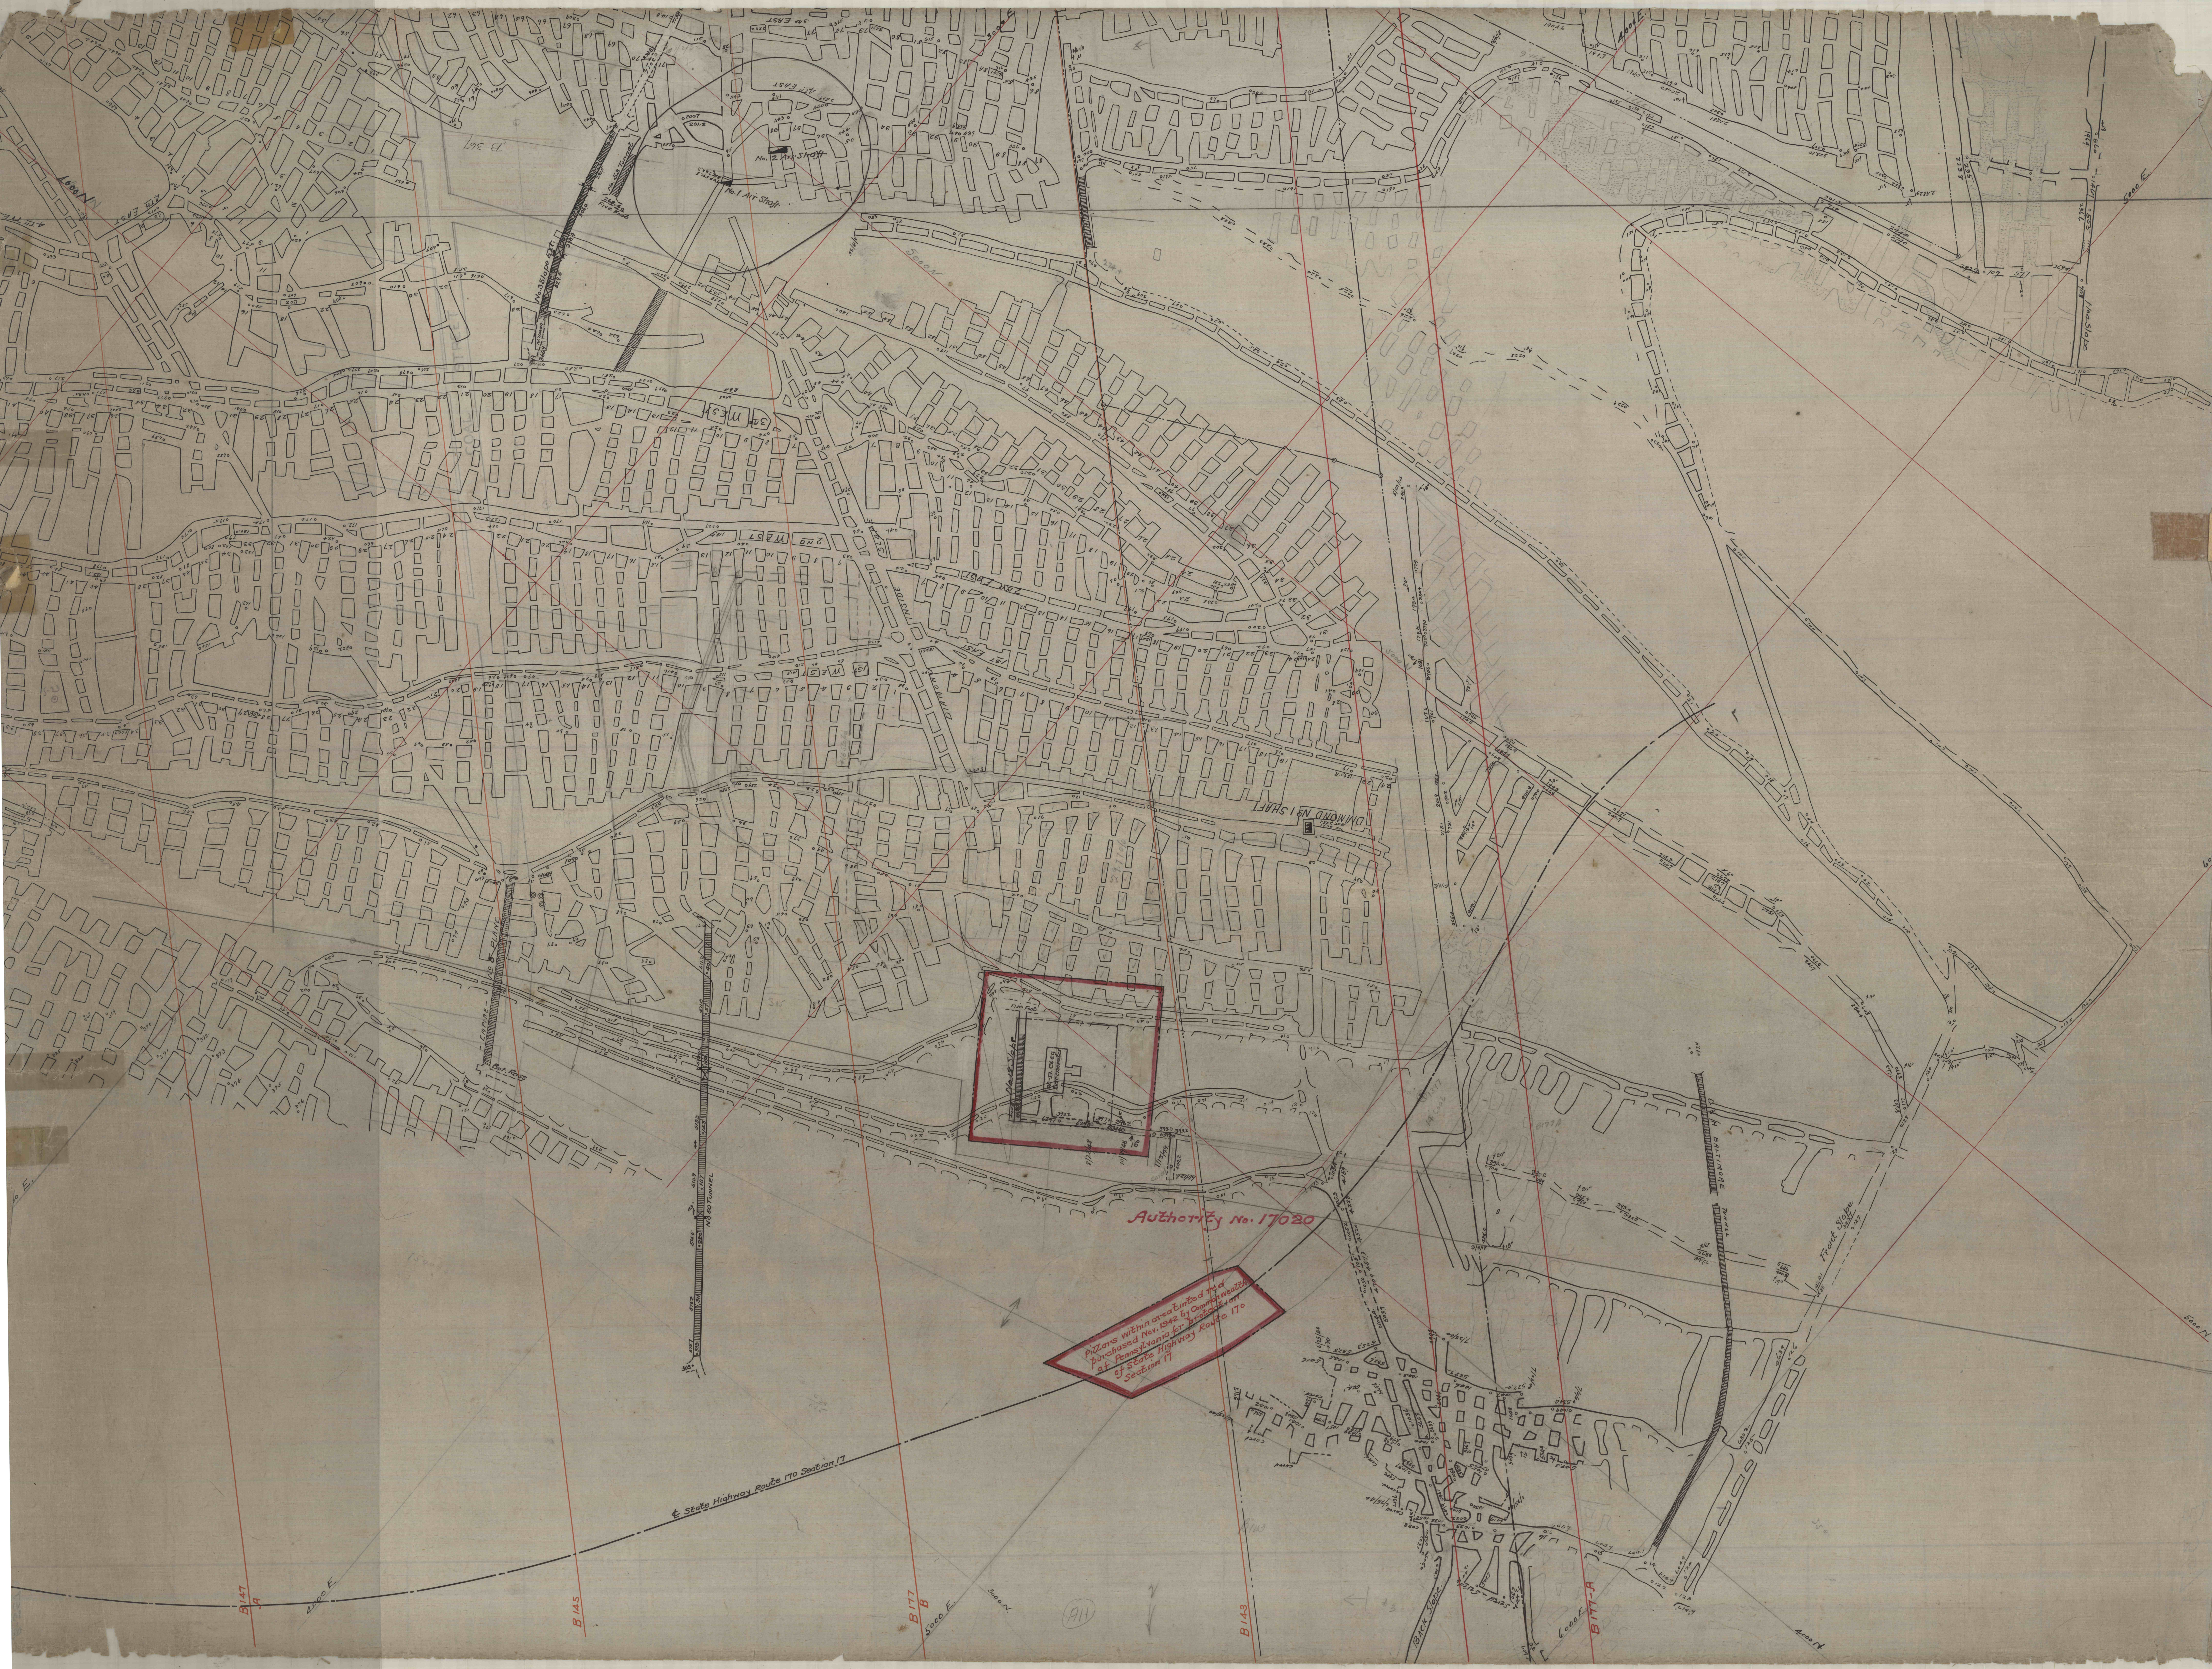

Lots within unincorporated area
purchased Nov. 1942 by Commonwealth
of Pennsylvania for project on
State Highway Route 170
Section 17

Authority No. 17020

State Highway Route 170 Section 17

B 147

B 145

B 143

B 141