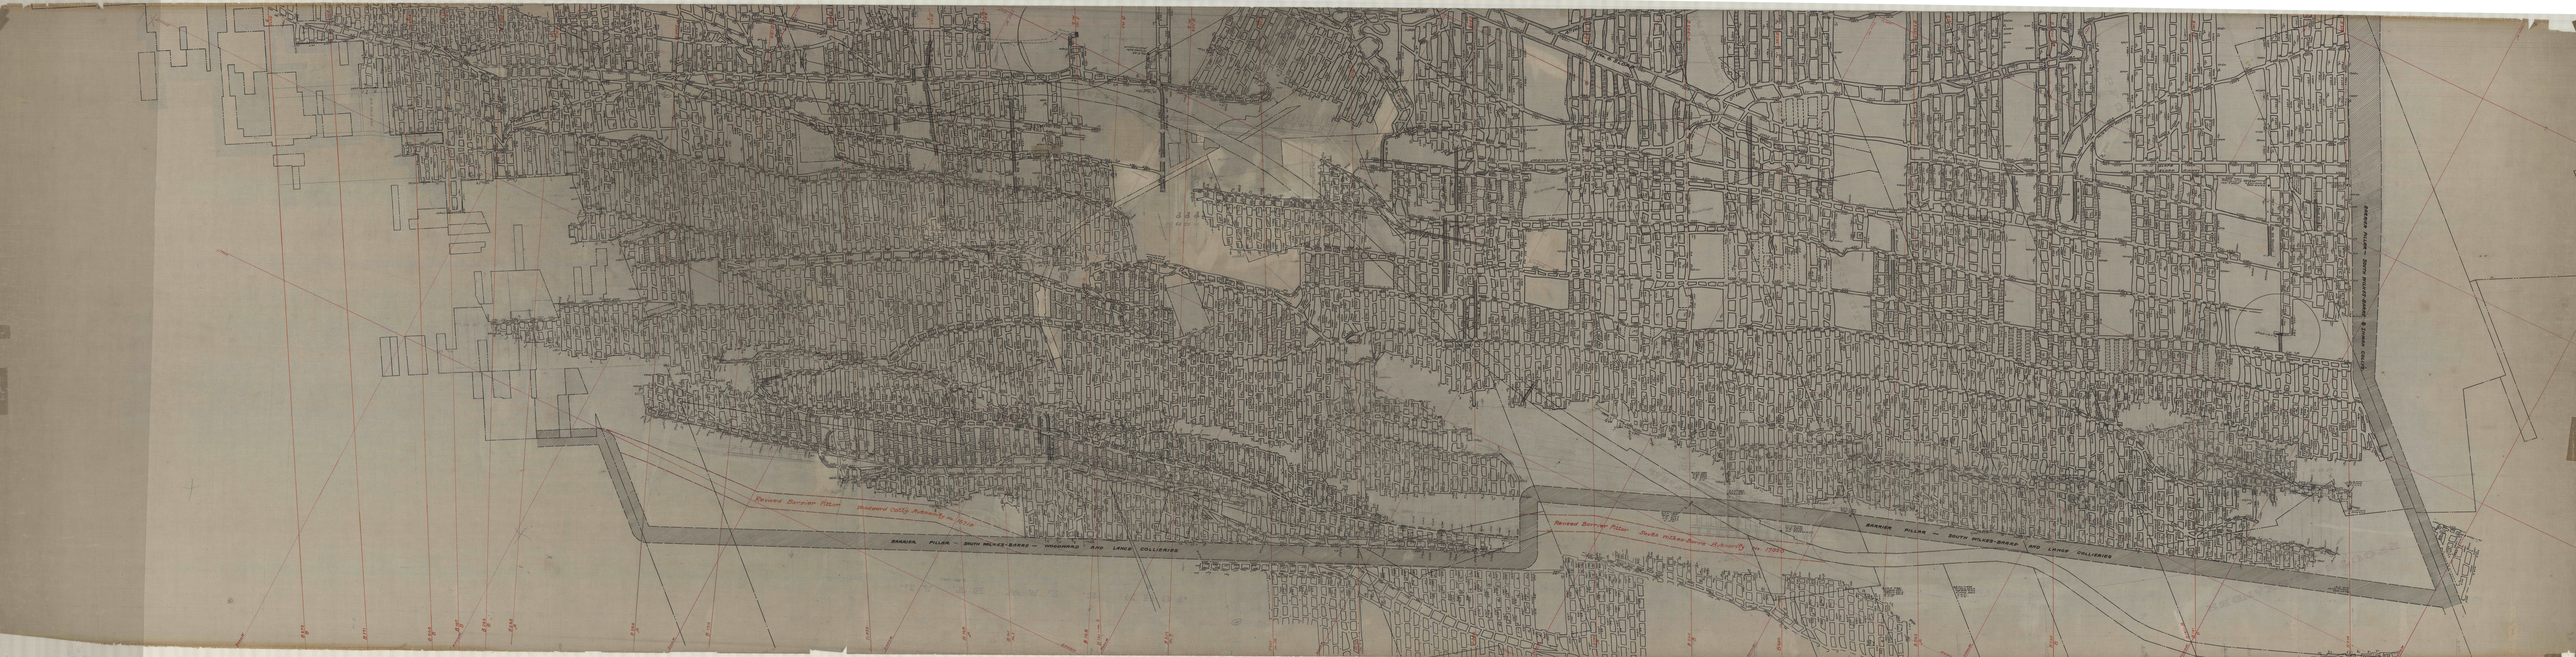

Revised Barrier Pillar
Revised Barrier Pillar
