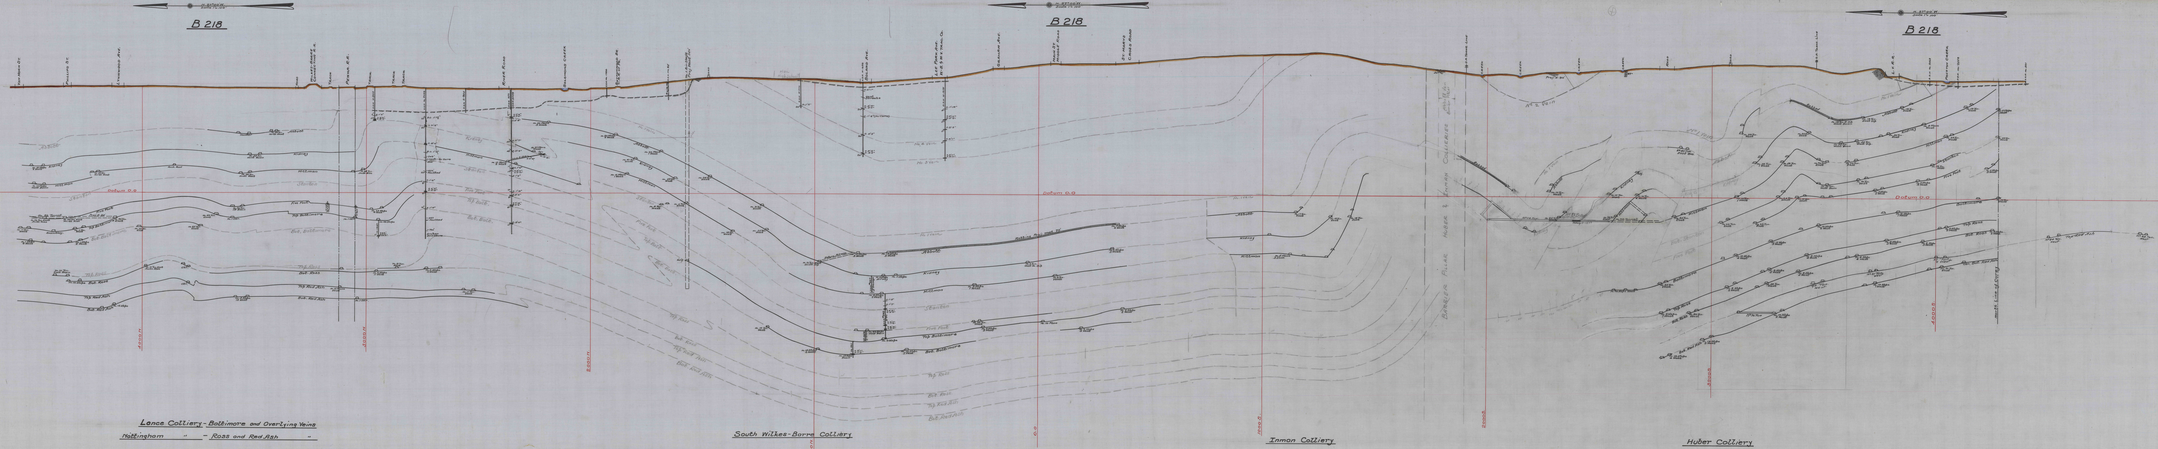

B 218
B 218
B 218
Lance Colliery - Baltimore and Overlying Veins
Nottingham " " Ross and Red Ash "
South Wilkes-Barre Colliery
Inman Colliery
Huber Colliery