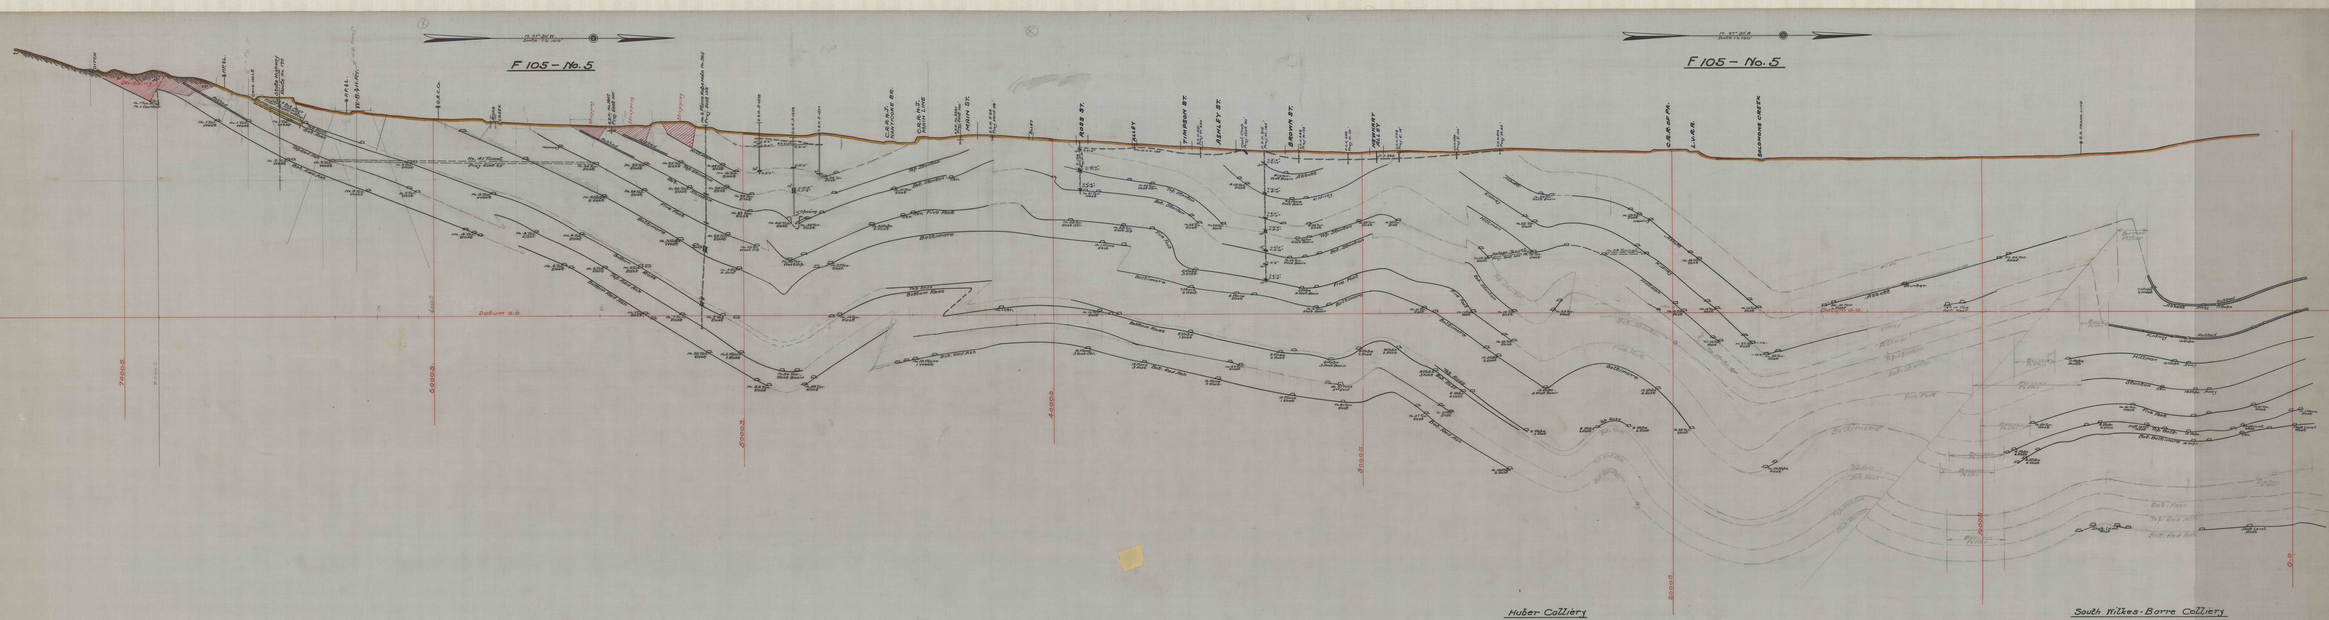
F 105 - No. 5
F 105 - No. 5
Datum 0-0
Huber Colliery
South Wilkes-Barre Colliery