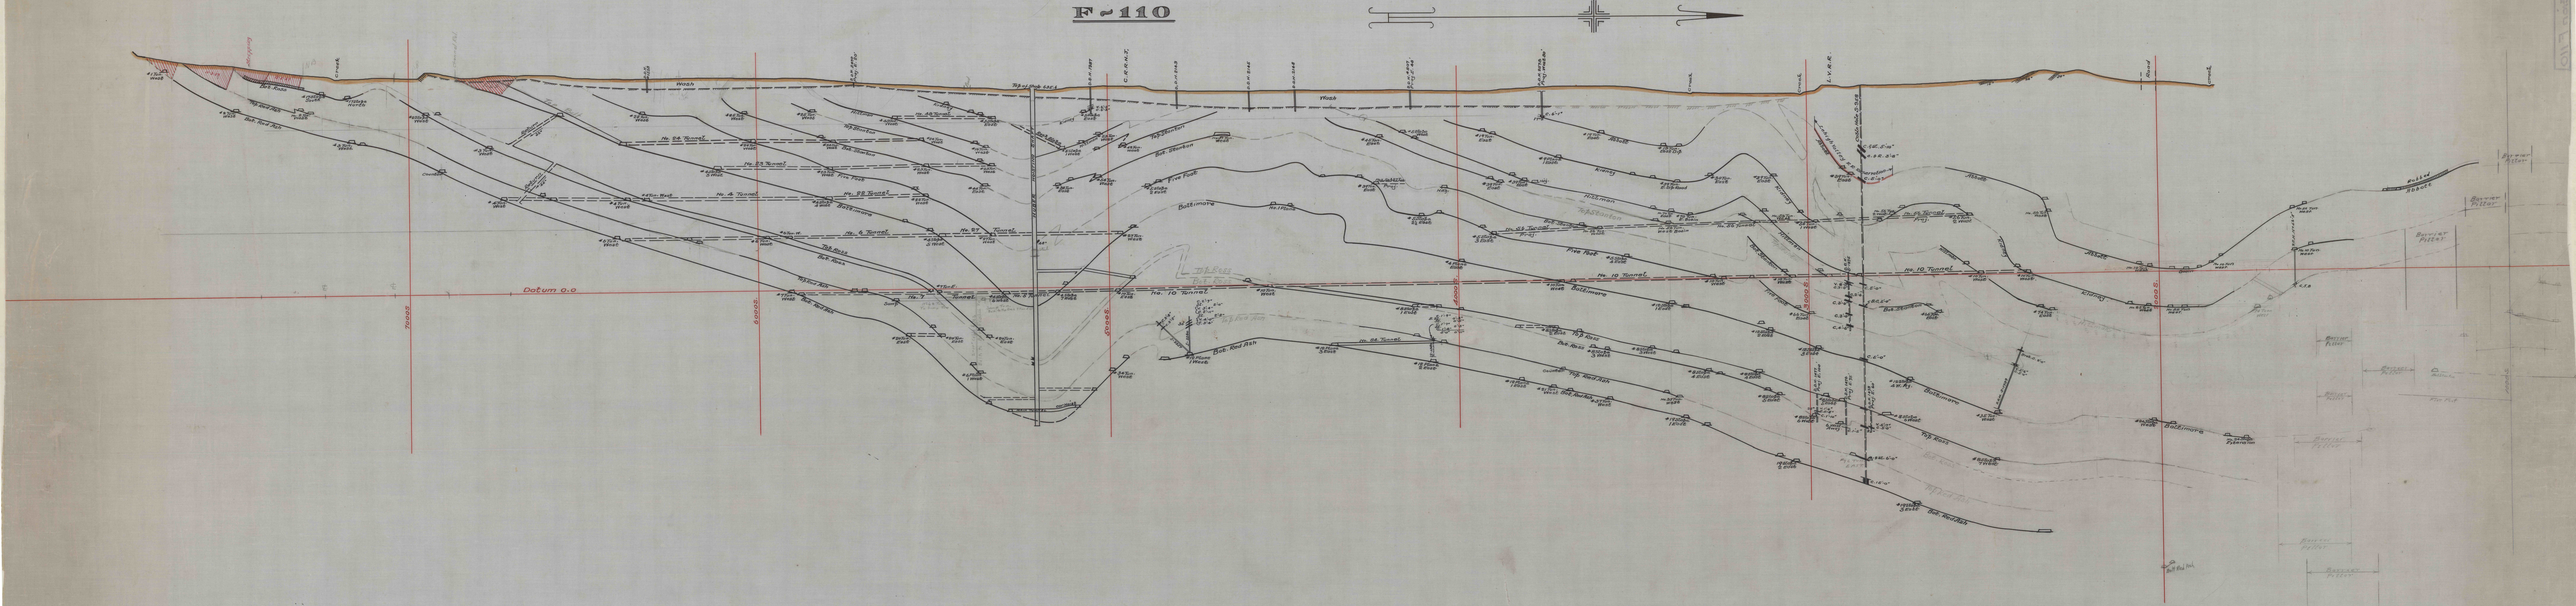

F-110

Stripping
11-3-29
Creek
Channel Rel.
Wash
Top of Shaft 635.6
C.R.R.N.J.
L.V.R.R.
Creek
Road
Creek
D.D.H. #1558
D.D.H. 2470 Proj. E. 20'
D.D.H. 1987
D.D.H. 2143
D.D.H. 2145
D.D.H. 2148
D.D.H. #807 Proj. E. 48
D.D.H. 2573 Proj. West 80'
C. 6'-1"
17°
15°
26°
39°
HUBER HOISTING SHAFT
Rock Slope
48°
Lehigh Valley R.R. Reservation
Cable Hole S-958
C. & St. 5'-10"
C. & R. 3'-8"
C. 5'-0"
#1 Tun. West
Bot. Ross
#17 Slope South
#17 Slope North
Top Red Ash
#2 Tun. West
No. 2 Tun. West
Bot. Red Ash
#3 Tun. West
#2 Slope West
#3 Tun. West
Top Balt.
Return 32°
Return 48°
Counter
#4 Tun. West
#4 Tun. West
No. 4 Tunnel
#6 Tun. West
#6 Tun. W.
No. 6 Tunnel
#6 Tun. West
Top Ross
Bot. Ross
Top Red Ash
#7 Tun. West
Bot. Red Ash
Sump
#7 Tun. E.
No. 7 Tunnel
No. 5 Tunnel
#20 Tun. East
#20 Tun. East
#20 Tun. East
#6 Plane 1 West
Main Tunnel
Con. Hoist
#34 Tun. West
#25 Tun. West
#25 Tun. West
#25 Tun. West
Hillman
#49 Tun. West
No. 49 Tunnel
#5 Slope East
Kidney
Top Stanton
No. 24 Tunnel
#24 Tun. West
#24 Tun. West
Bot. Stanton
#16 Tun. West
No. 23 Tunnel
#4 Slope 3 West
#23 Tun. West
Five Foot
#23 Tun. West
#44 Tun. East
No. 22 Tunnel
#4 Slope 4 West
#22 Tun. West
Baltimore
No. 27 Tunnel
#4 Slope 5 West
#27 Tun. West
#27 Tun. West
#4 Slope 6 West
#4 Slope 7 West
#10 Tun. East
No. 10 Tunnel
#5 Slope 1 West
#53 Tun. West
#42 Tun. West
#38 Tun. East
#54 Tun. West
#5 Slope 2 East
No. 51 Tun. West
No. 1 Plane
Top Ross
Bot. Ross
Top Red Ash
Bot. Red Ash
#12 Plane 1 West
S-2257
S-2260
#12 Plane 3 East
No. 84 Tunnel
#12 Plane 2 East
#10 Tun. West
#45 Tun. East
#5 Slope West
#39 Tun. East
No. 53 & 51 Tun. Proj.
#5 Slope 2½ East
Hdg.
#4 Plane East
#8 Slope 1 East
#8 Slope 2 East
#8 Slope 3 West
#8 Slope 3 West
Counter
#12 Plane 1 East
#21 Tun. West
#37 Tun. West
No. 37 Tun. West
#19 Slope 1 East
#19 Tun. East
Abbott
#19 Tun. East Dip
#9 Plane 1 East
#39 Tun. East
#39 Tun. East
#39 Tun. E. Dip Road
#30 Tun. East
#39 Tun. East
#5 Slope 3 East
No. 56 Tunnel
No. 56 Tun. West
No. 70 Tun. East
#70 Tun. E. Basin
No. 56 Tun. West Basin
#5 Slope 4 East
#10 Tun. West
#12 Slope 1 East
#12 Slope 2 East
#12 Slope 3 East
#8 Slope 4 East
#8 Slope 4 East
#8 Slope 4 East
#8 Slope 5 East
#8 Slope 6 West
#8 Slope 6 West
#8 Slope 7 West
#12 Slope 4 W. Ay.
#35 Tun. West
#19 Slope 2 East
#19 Slope 3 East
#56 Tun. 1 West
No. 56 Tun. 2 West
No. 56 Tunnel Proj.
#56 Tun. 2 West
No. 56 Tun. West
No. 56 Tun. West
Robbed Abbott
Barrier Pillar
#10 Tun. West
#10 Tun. West
#10 Tun. West
No. 10 Tun. West
Basin
No. 10 Tun. West
No. 10 Tun. West
C. 5.8
D.D.H. S-1876
#66 Tun. East
#66 Tun. East
#74 Tun. East
No. 85 Tun. West
No. 85 Tun. West
74 Tun. West
D.D.H. 1477 Proj. E. 100'
D.D.H. 1476 Proj. E. 75'
D.D.H. 1473 Proj. E. 60'
D.D.H. S-1739
Brok. C. 2'-0"
V. 5'-6" C. 5'-0"
V. 5'-7" C. 5'-0"
C. 5'-0"
C. & St. 6'-0"
C. 15'-0"
#9C Tun. East
#24 Slope West
No. 24 Slope Extension
Bot. Stanton
Bott Red Ash
Datum 0.0
7000 S.
6000 S.
5000 S.
4000 S.
3000 S.
2000 S.
1000 S.