


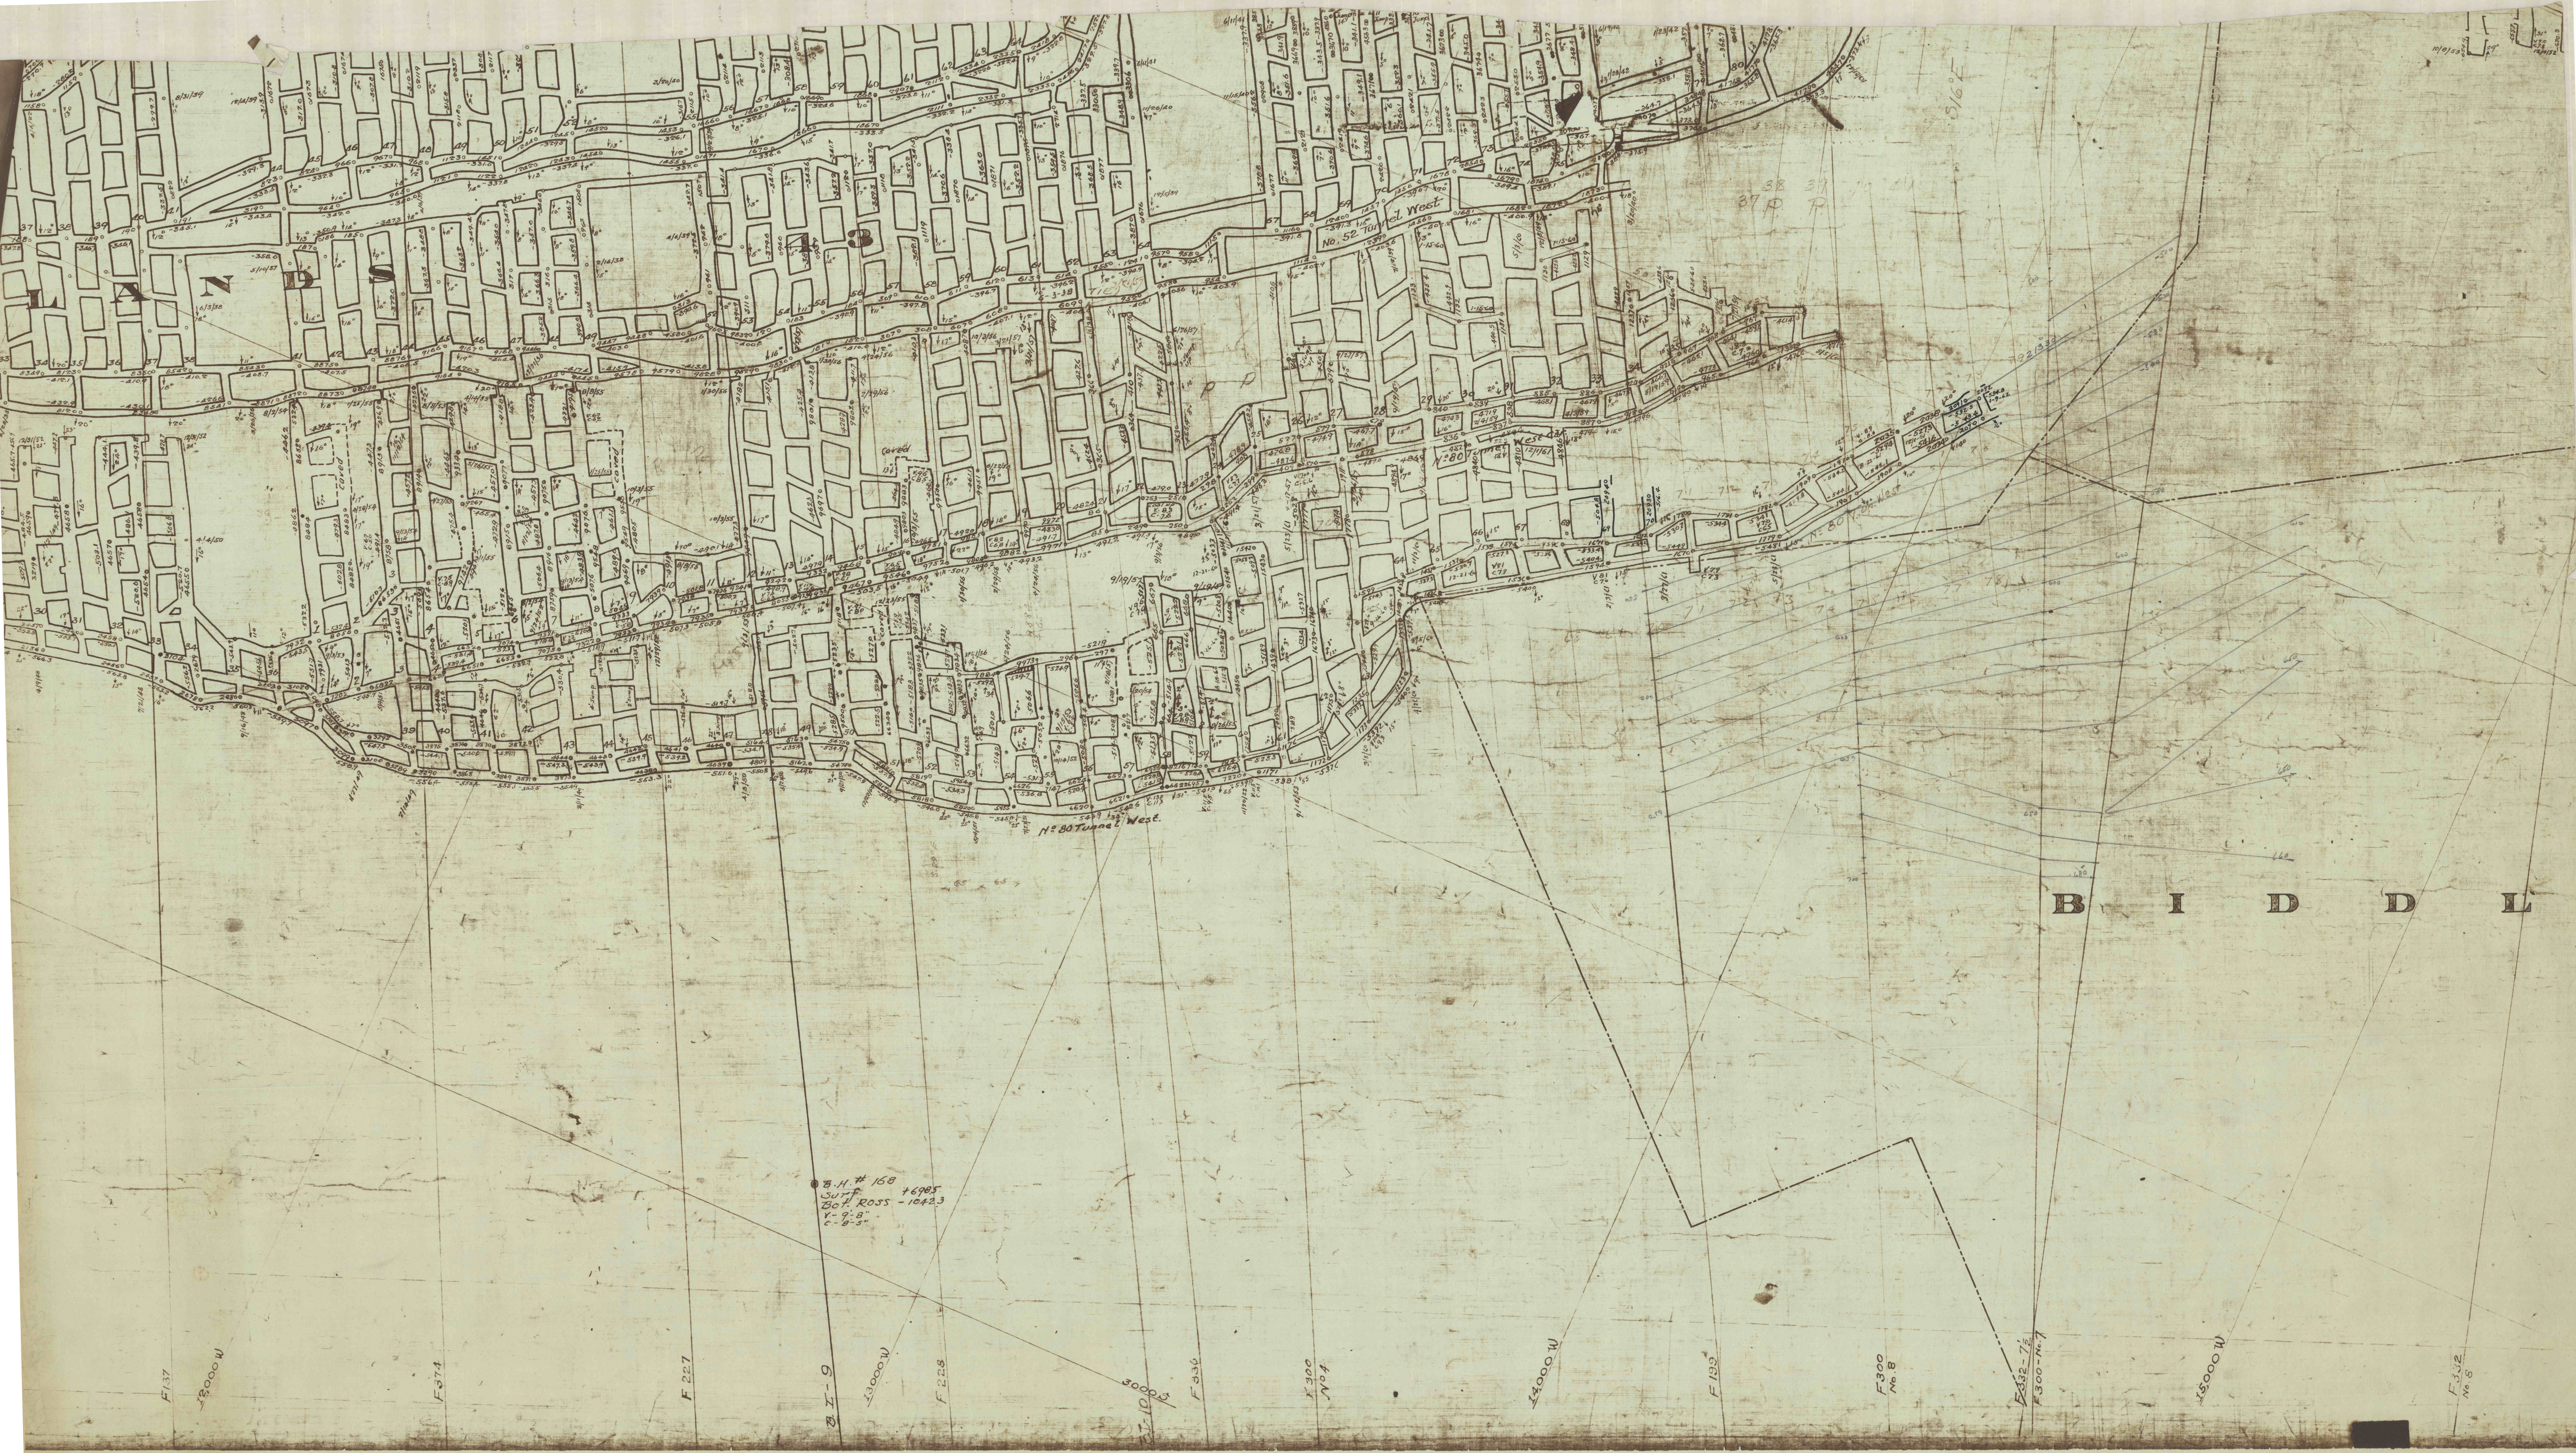

B.H. # 168
100 ft. ROSS - 10423
1-9-8
1-8-5

B I D D L