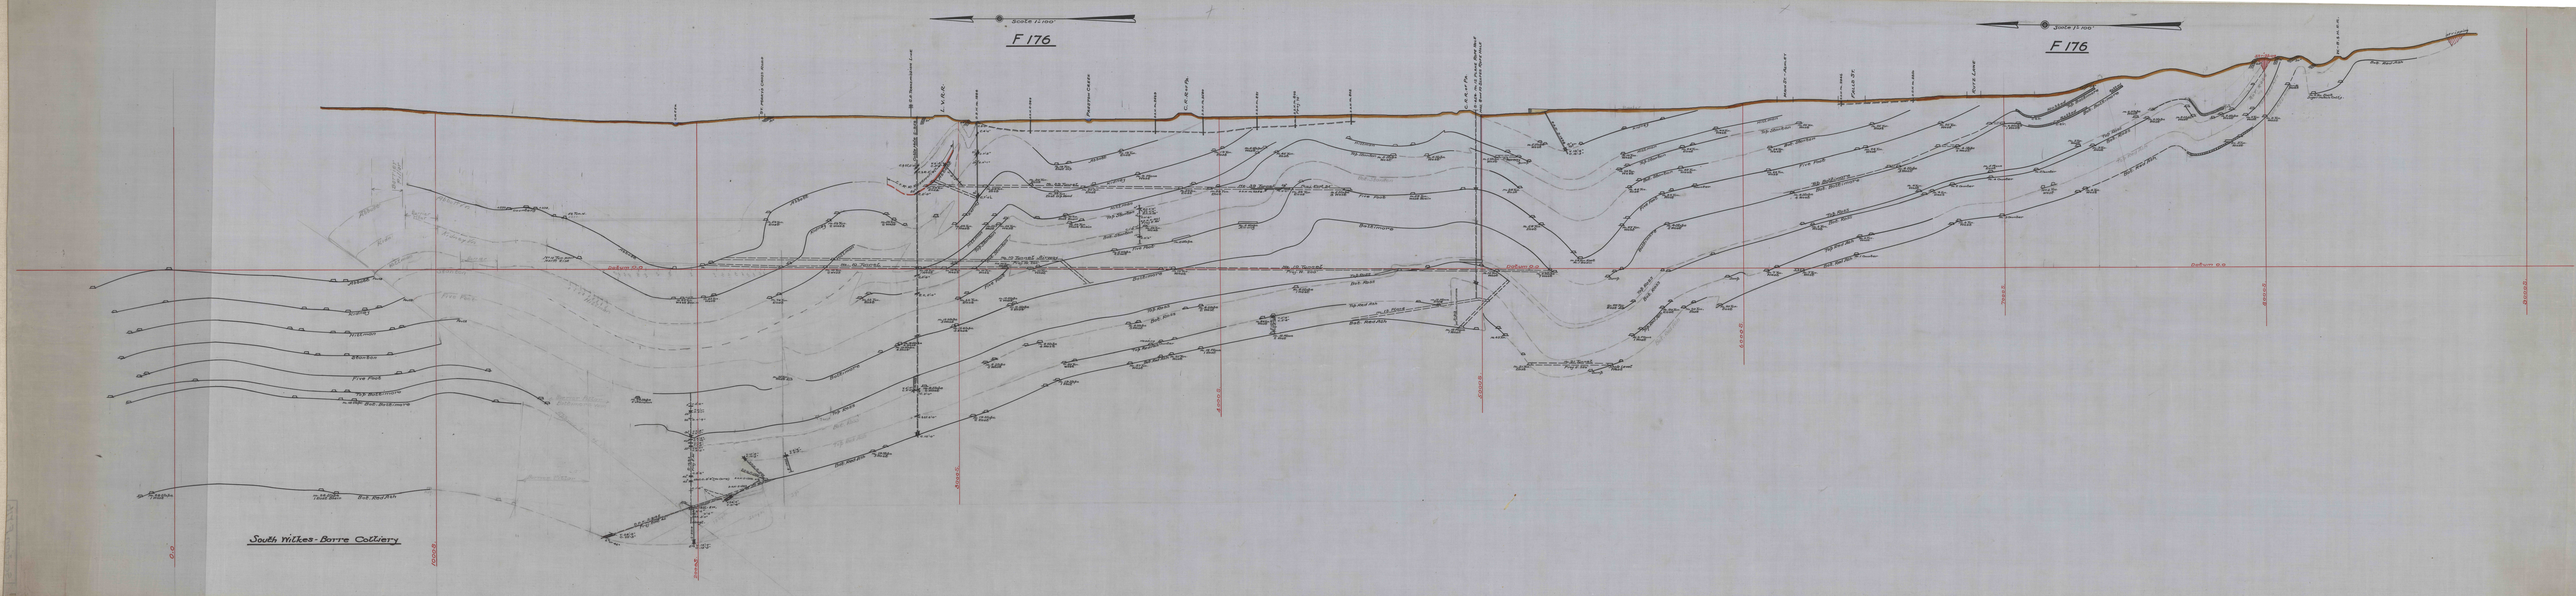
Scale 1"=100'
F 176
Scale 1"=100'
F 176
South Wilkes-Barre Colliery