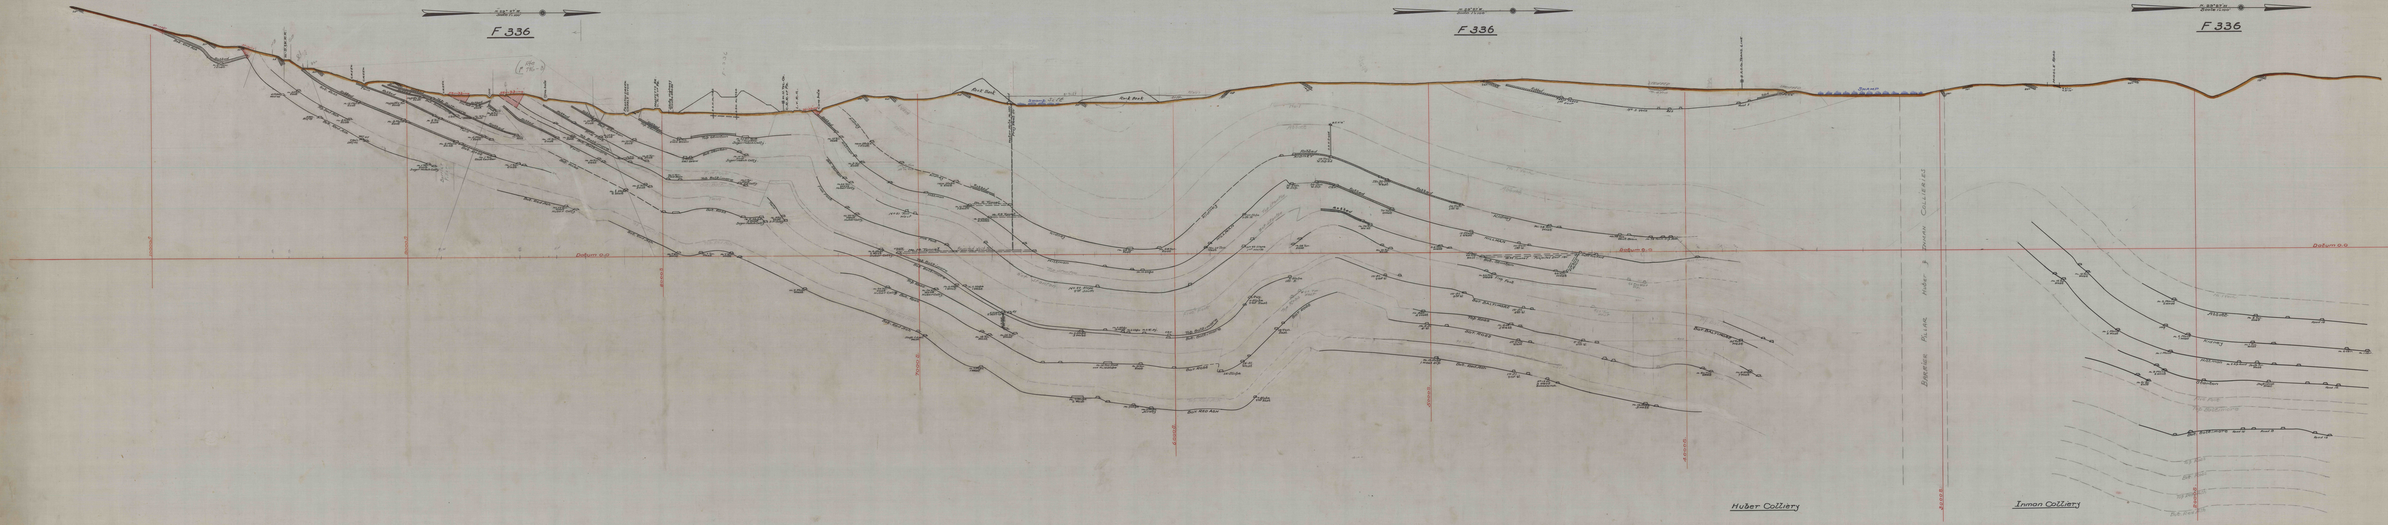

F 336
F 336
F 336
Datum 0.0
Datum 0.0
Datum 0.0
Huber Colliery
Inmon Colliery