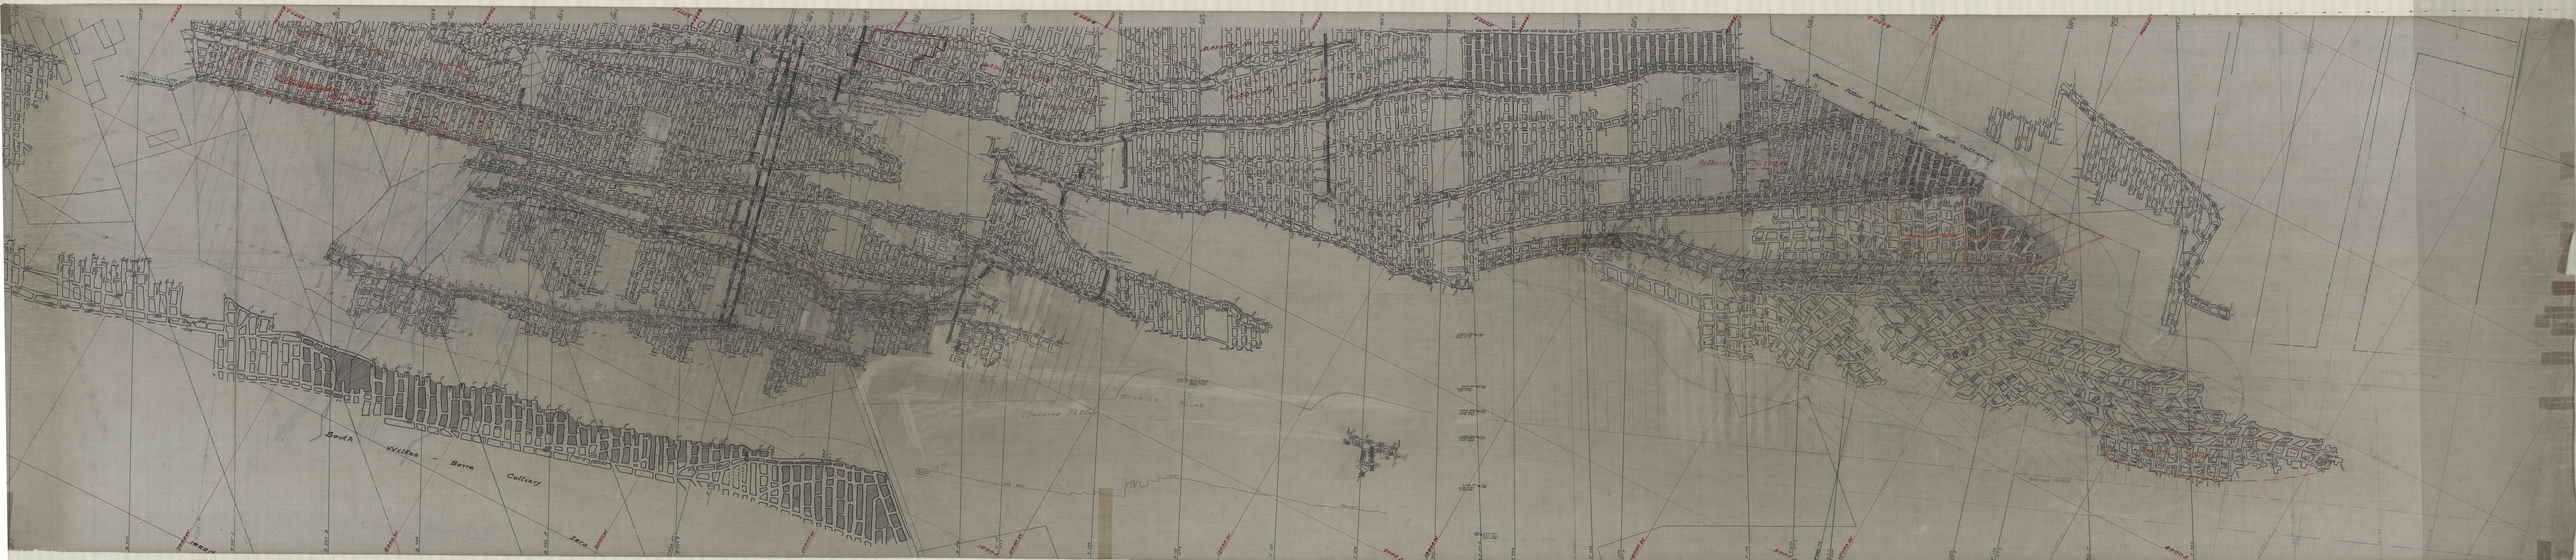

South Wilkes Barre Colliery