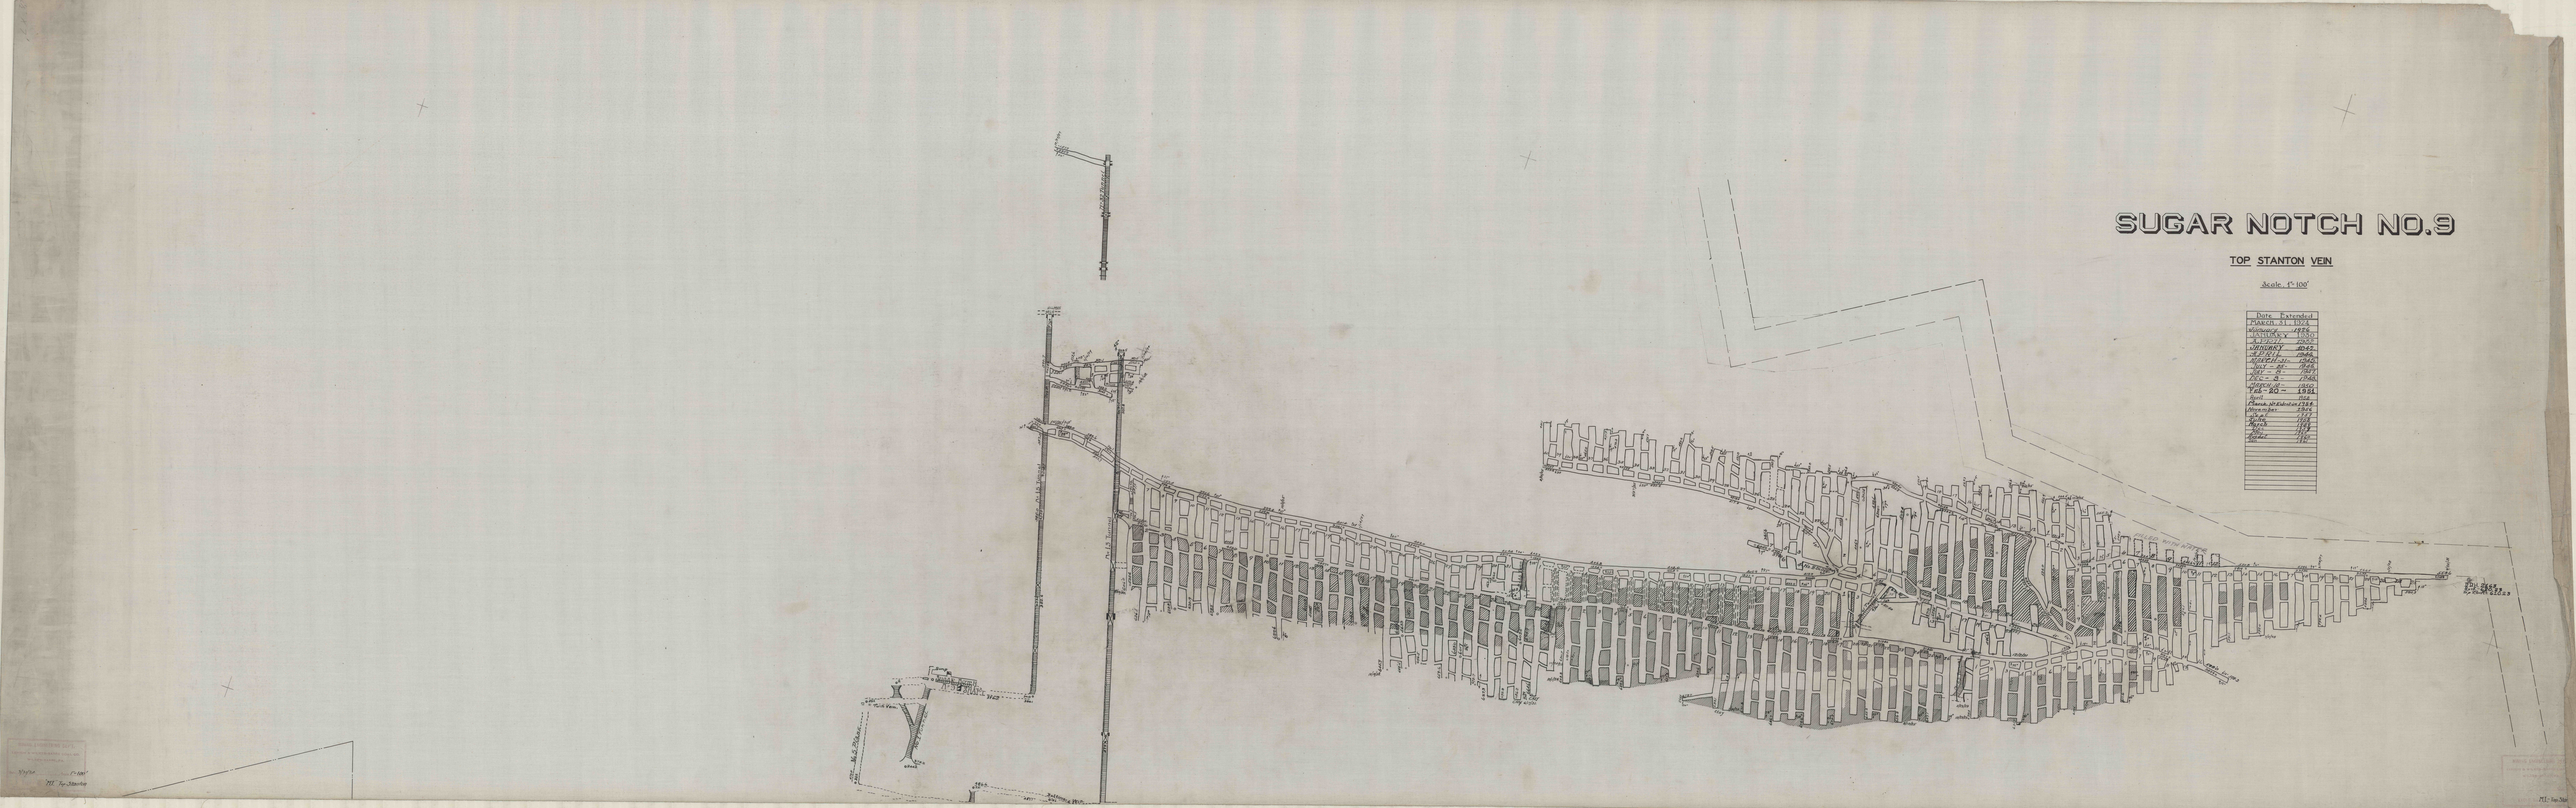

# SUGAR NOTCH NO.9

## TOP STANTON VEIN

Scale, 1"= 100'

| Date Extended | |
|---|---|
| MARCH, 31, | 1924 |
| January | .1926 |
| JANUARY | 1930 |
| APRIL | 1932 |
| JANUARY | 1942 |
| APRIL | 1944 |
| MARCH-31- | 1945. |
| JULY - 25- | 1946. |
| JULY - 8- | 1947. |
| DEC - 8- | 1948. |
| MARCH-10- | 1950 |
| Feb ~ 20 ~ | 1951 |
| April | 1952 |
| March No Extention | 1954 |
| November | 1956 |
| Sept | 1957 |
| June | 1958 |
| March | 1959 |
| Dec | 1959 |
| May | 1960 |
| August | 1960 |
| Jan | 1961 |
| | |
| | |
| | |
| | |
| | |
| | |
| | |
| | |
| | |
| | |
| | |
| | |
| | |

No 32 Tunnel
12/29/27
HILLMAN
391.4
3 East
2 East
1st East
No 15 Tunnel
No 13 Tunnel
No 5 Plank
Twin Vein
No 1 Tunnel
Sump
Sugar Notch No 9 Shaft
Baltimore Vein
No. 8 Slope
Filled with water

MINING ENGINEERING DEP'T,
LEHIGH & WILKES-BARRE COAL CO.
WILKES-BARRE, PA.
Date 3/31/24 Scale 1"=100'
VAULT No. "M.I." Top Stanton

MINING ENGINEERING DEP
LEHIGH & WILKES-BARRE COA
WILKES-BARRE, PA.
Scale
VAULT No. M.I.- Top Stan