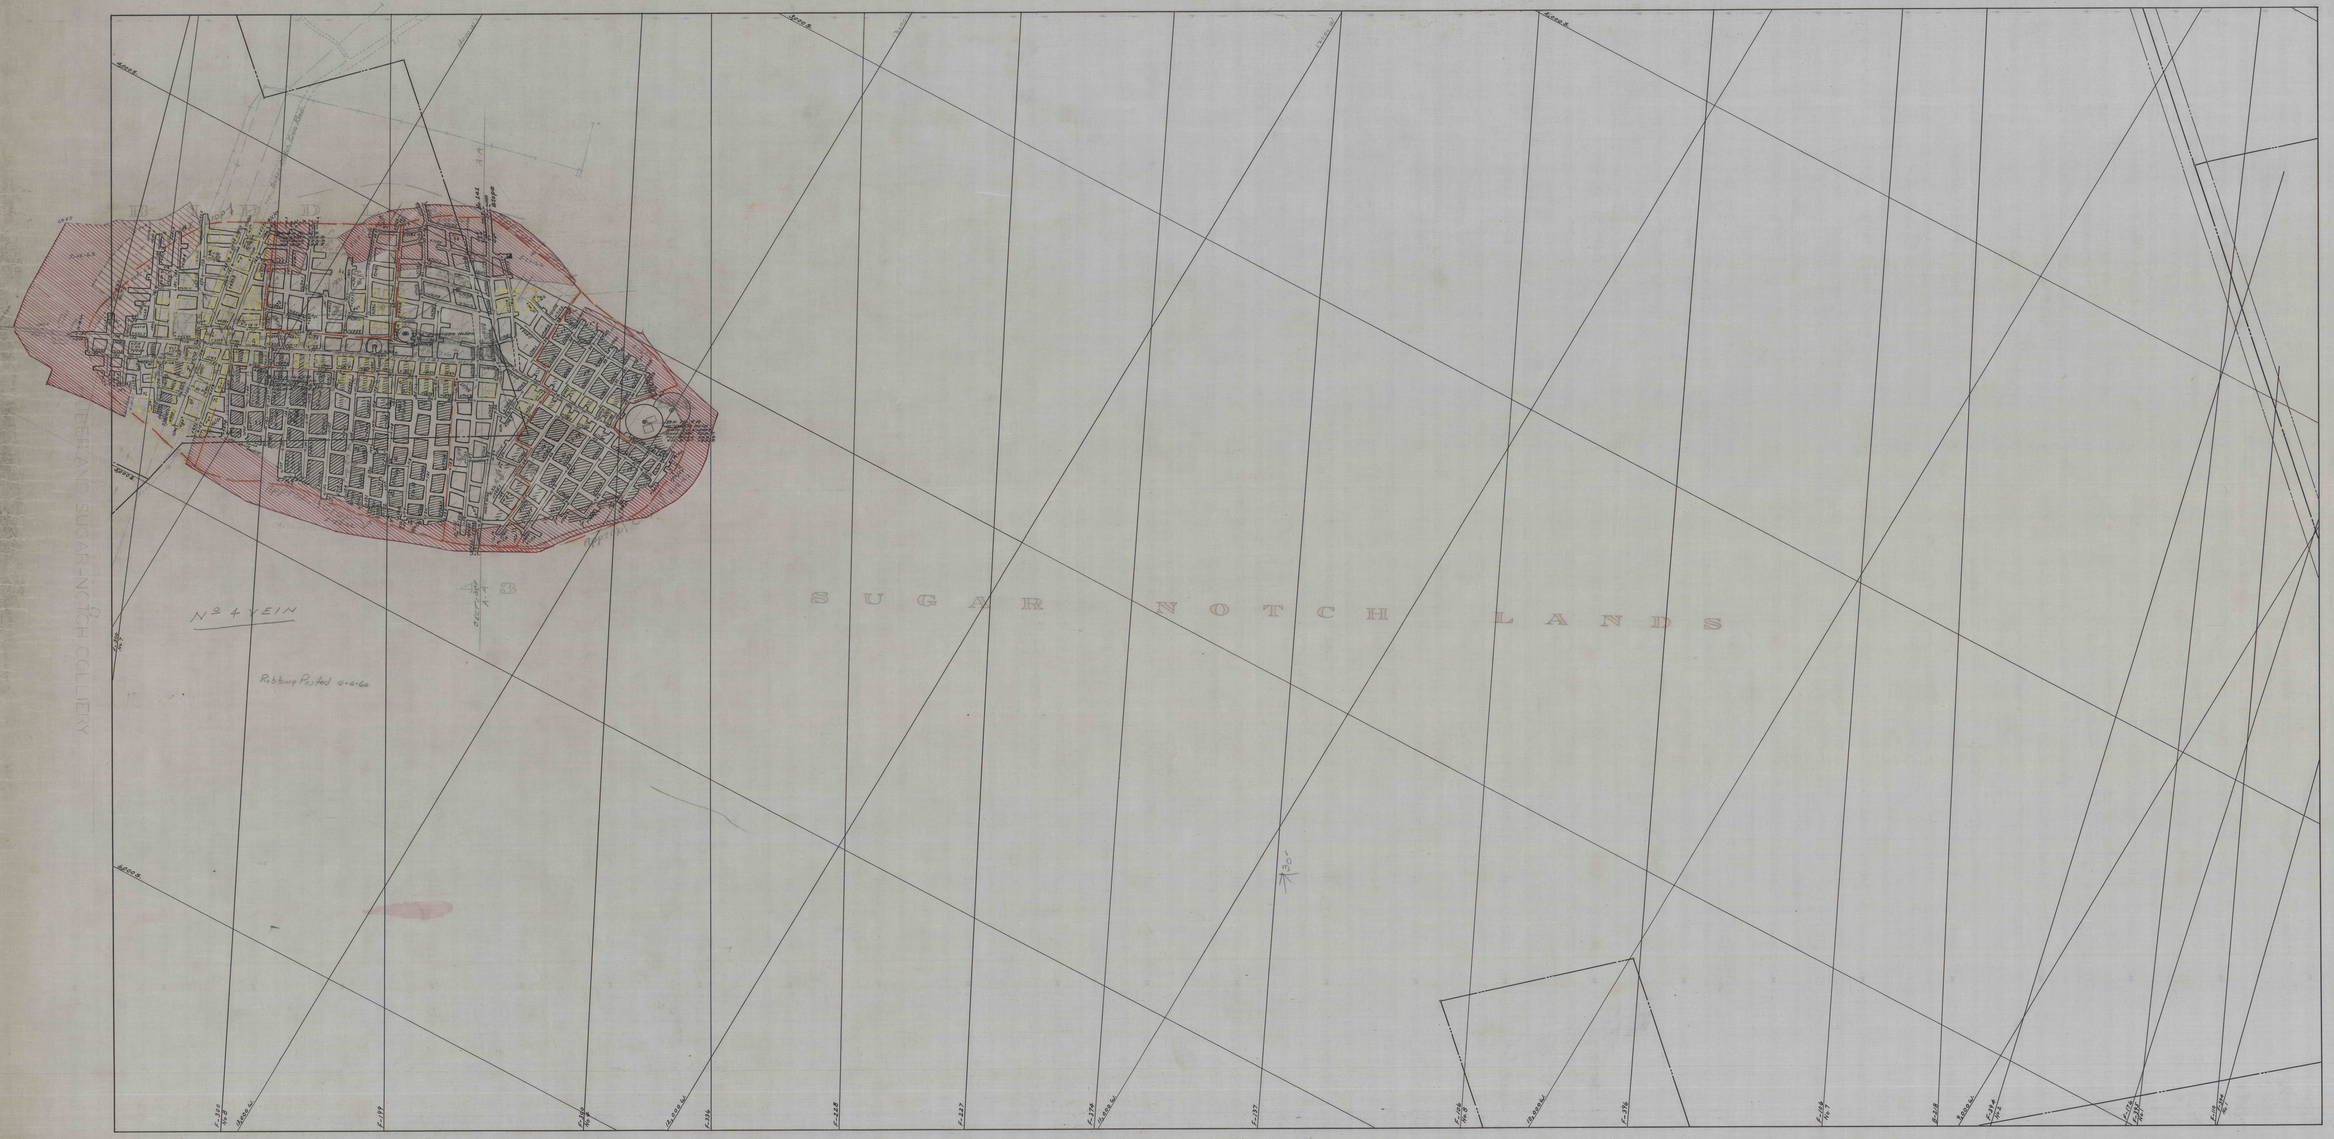
SUGAR NOTCH LANDS
No 4 VEIN
Robbing Posted 9-4-40
SECT. A-B
SECT. C-D
SECTION 8
SUGAR NOTCH COLLIERY