




Cross-section
 Scale Hor. 1"=40' Ver. 1"=10'
 Drawing TS 2/4

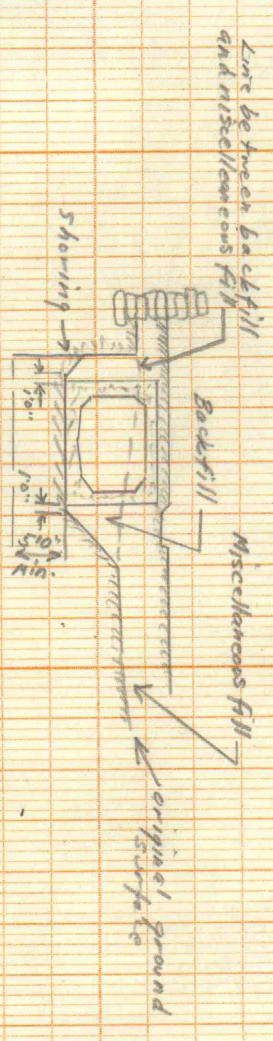

Typical cross-section
 Scale 1"=40'
 Drawing TS 2/4

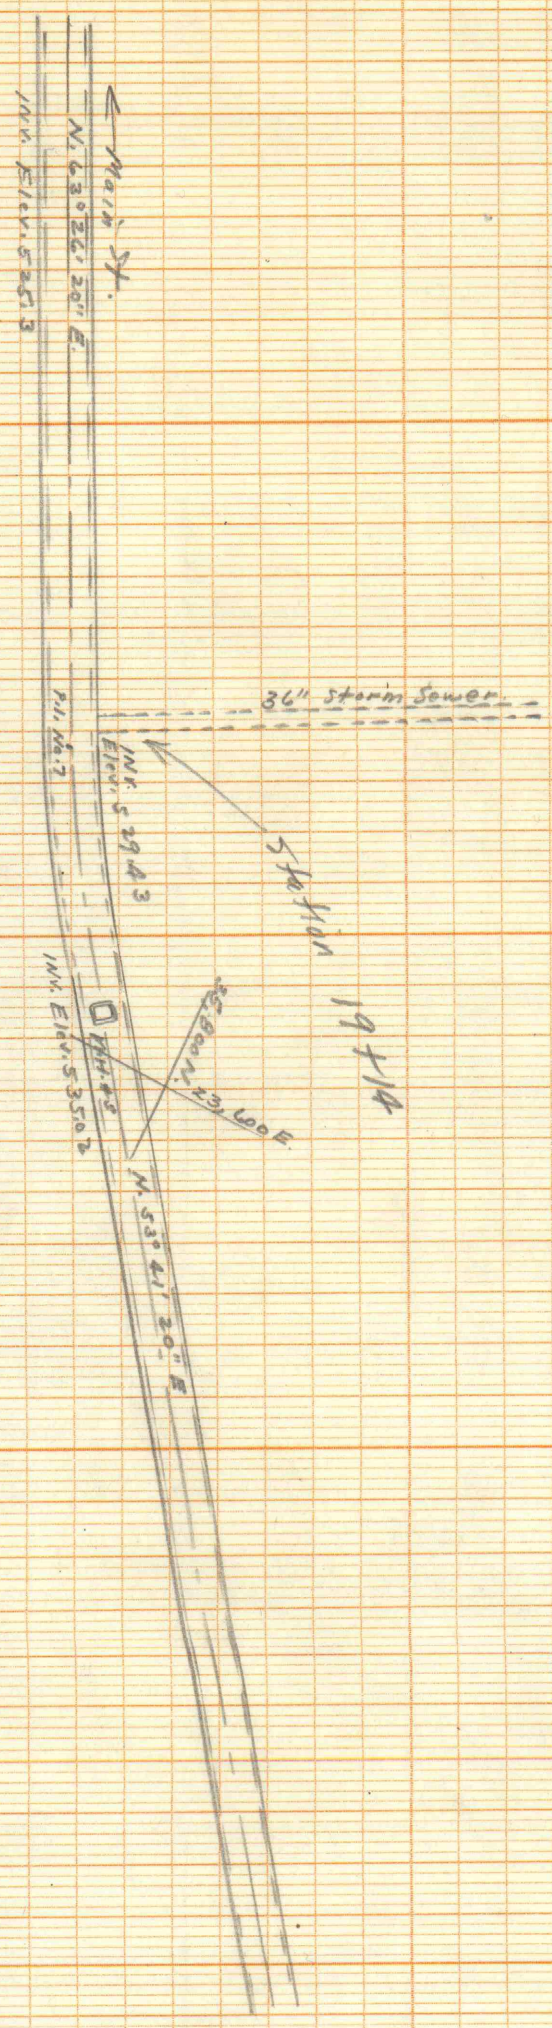

Drawing TS 2/4

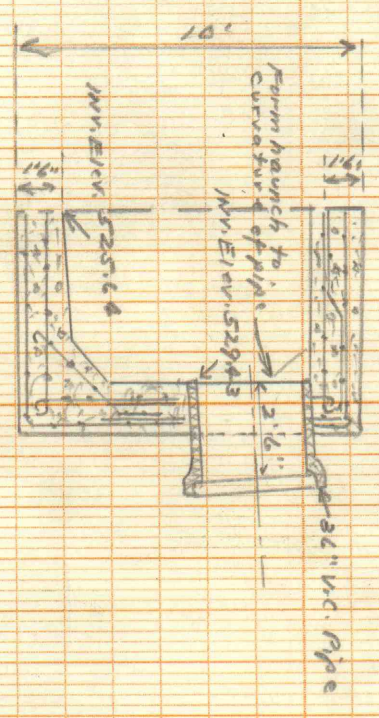

Drawing TS 3/12
 Scale 1"=3/16

Toby's Creek Intercepting Sewer and High St. 36" V.C. Storm Sewer
 Scale 1"=40'

From U.S. Army Engineers book of drawings "Toby's Creek Intercepting Sewer"