



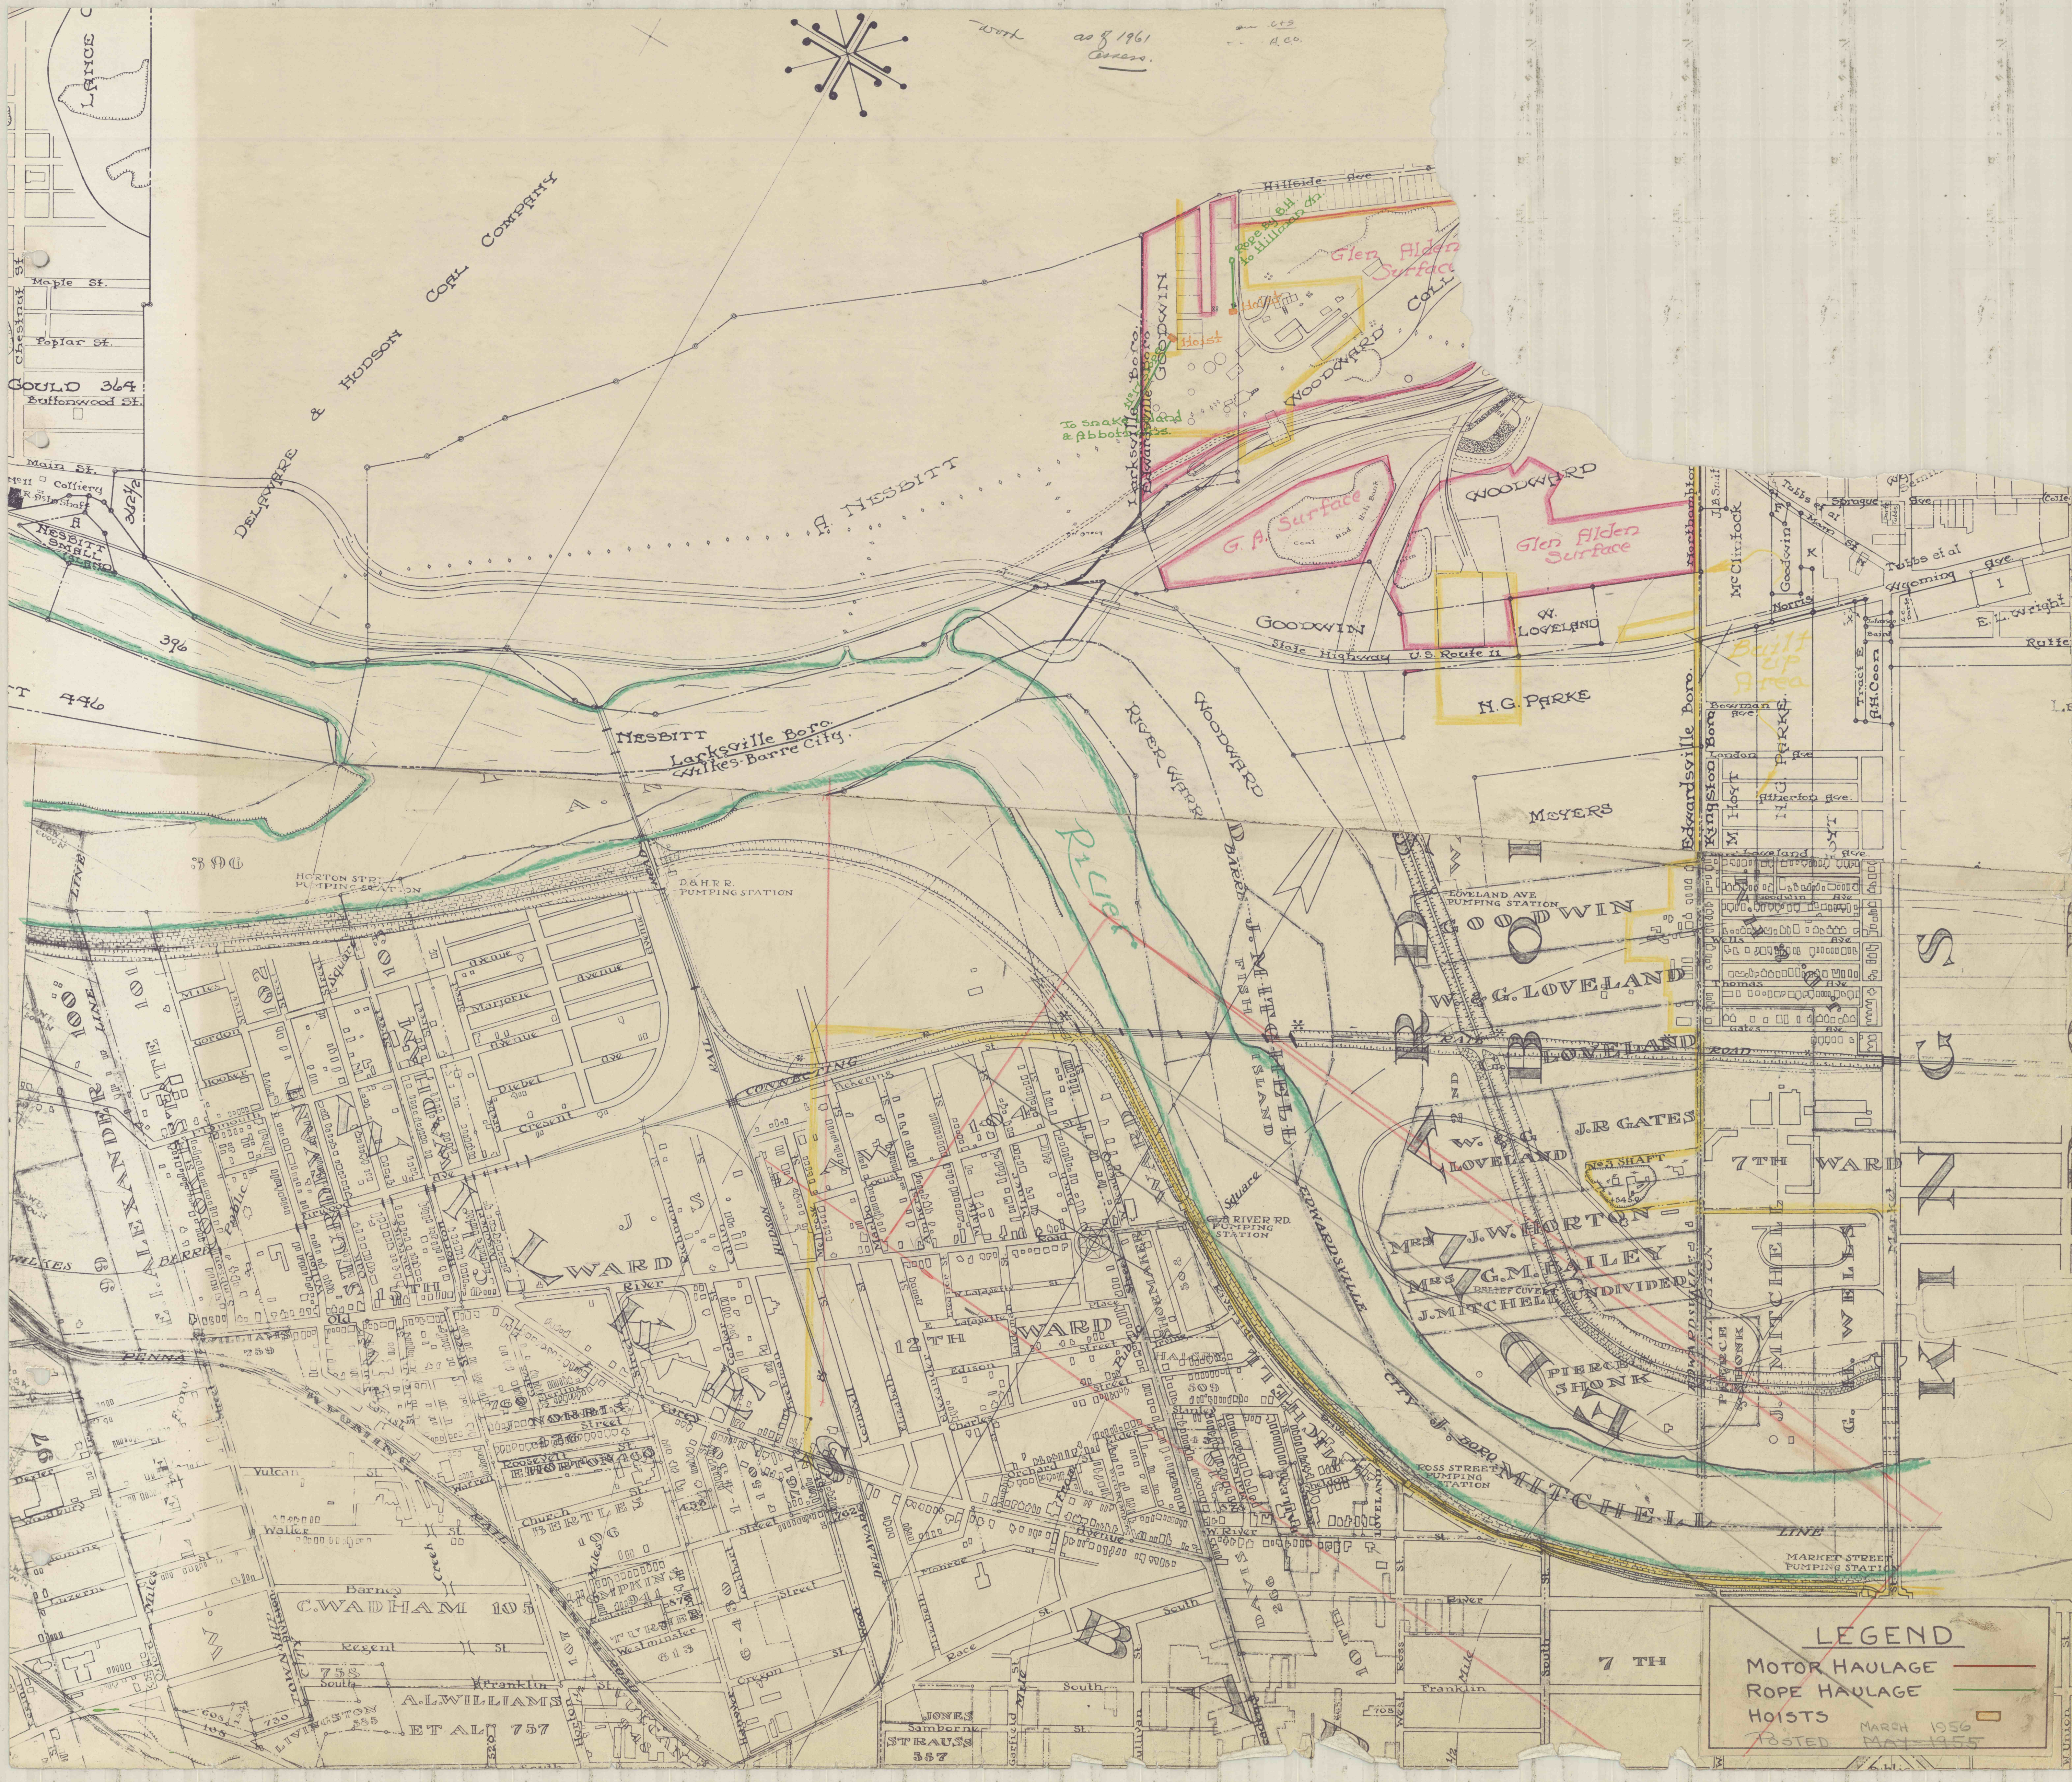

with 208 1961
Cross.
G.S.
d.co.

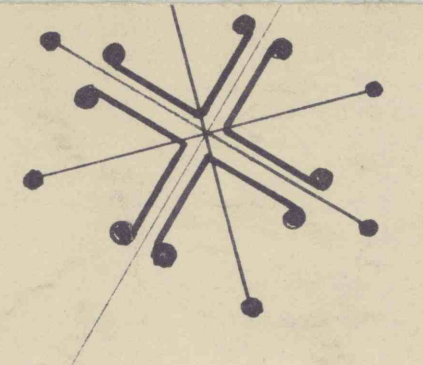

LEGEND

MOTOR HAULAGE ———

ROPE HAULAGE ———

HOISTS ———

MARCH 1956
TOASTED MAY 1955