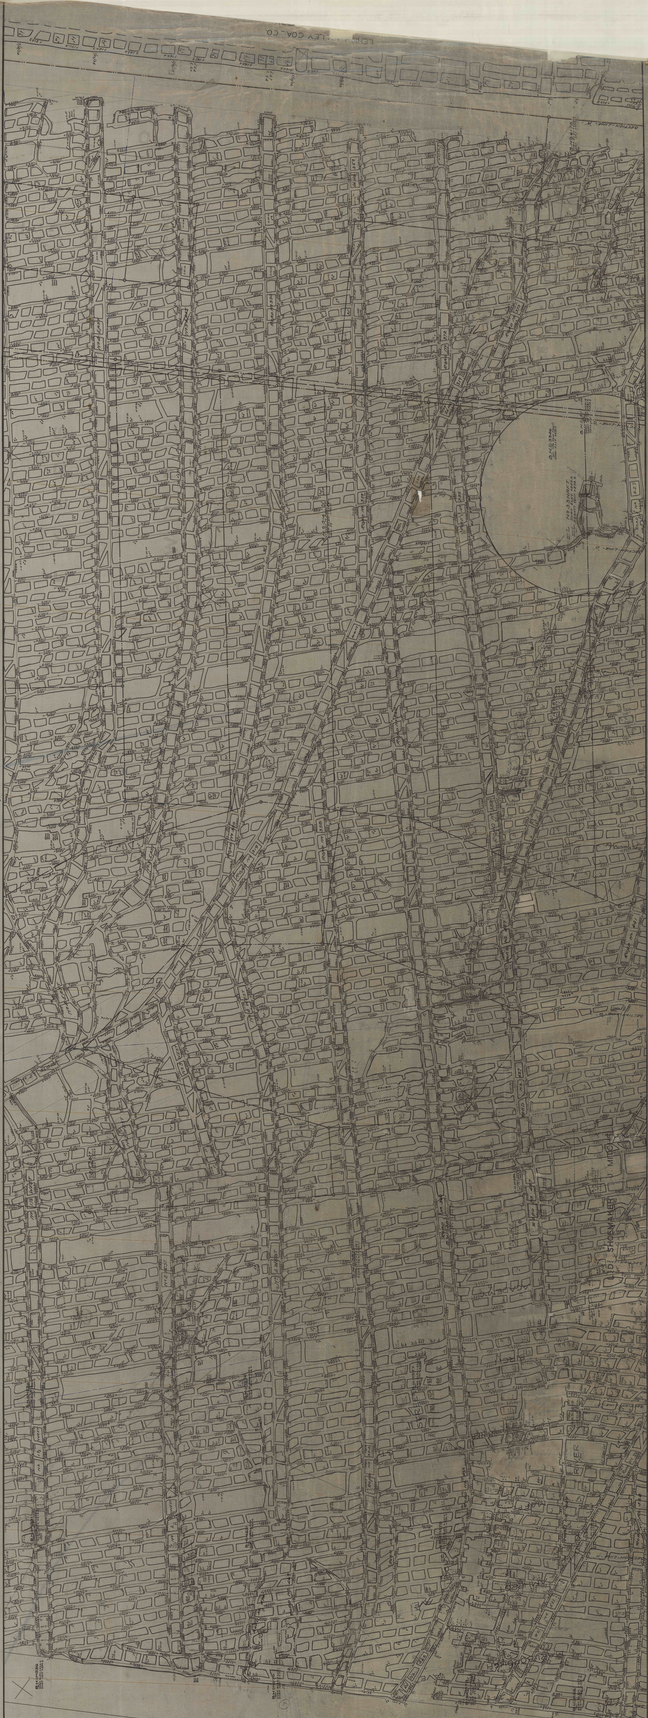

WOODWARD – ABBOTT

MIDDLE SECTION