


POSTED.
 In Service June '58
 APR. 16, '60 F.
 AUG. 30, '63 F.
 APR. 25, '65 F.

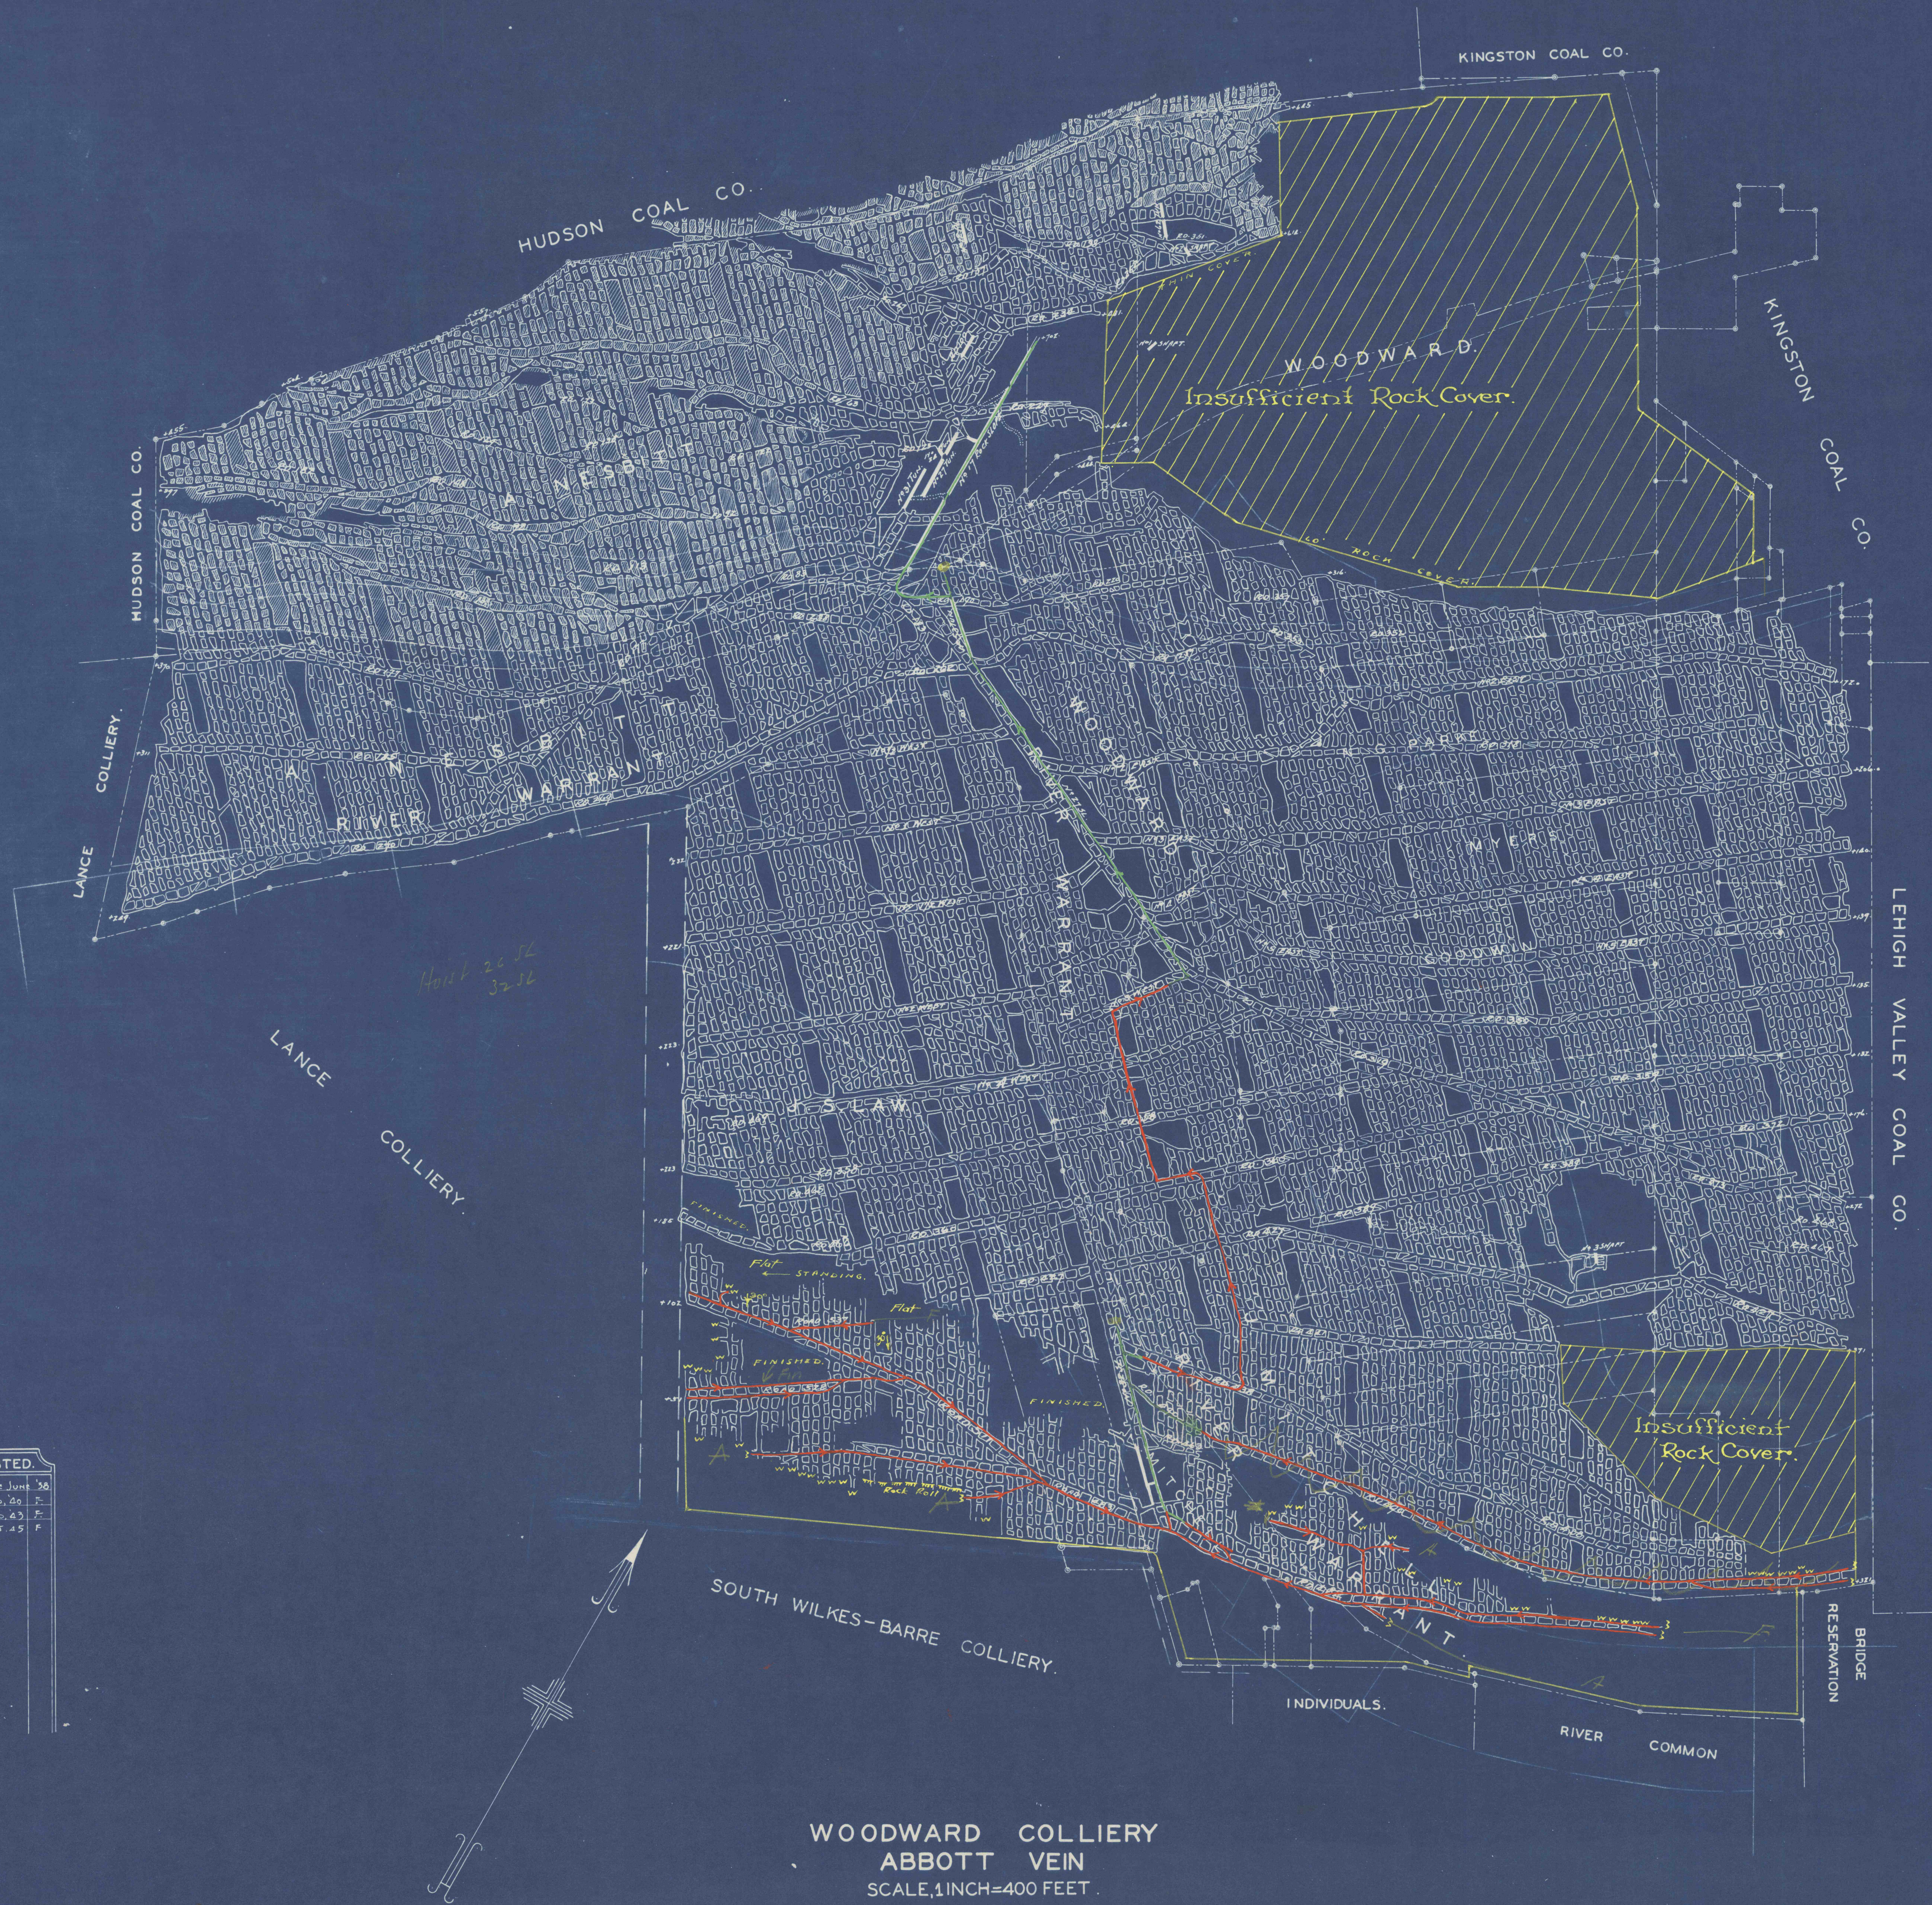

WOODWARD COLLIERY
 ABBOTT VEIN
 SCALE, 1 INCH = 400 FEET