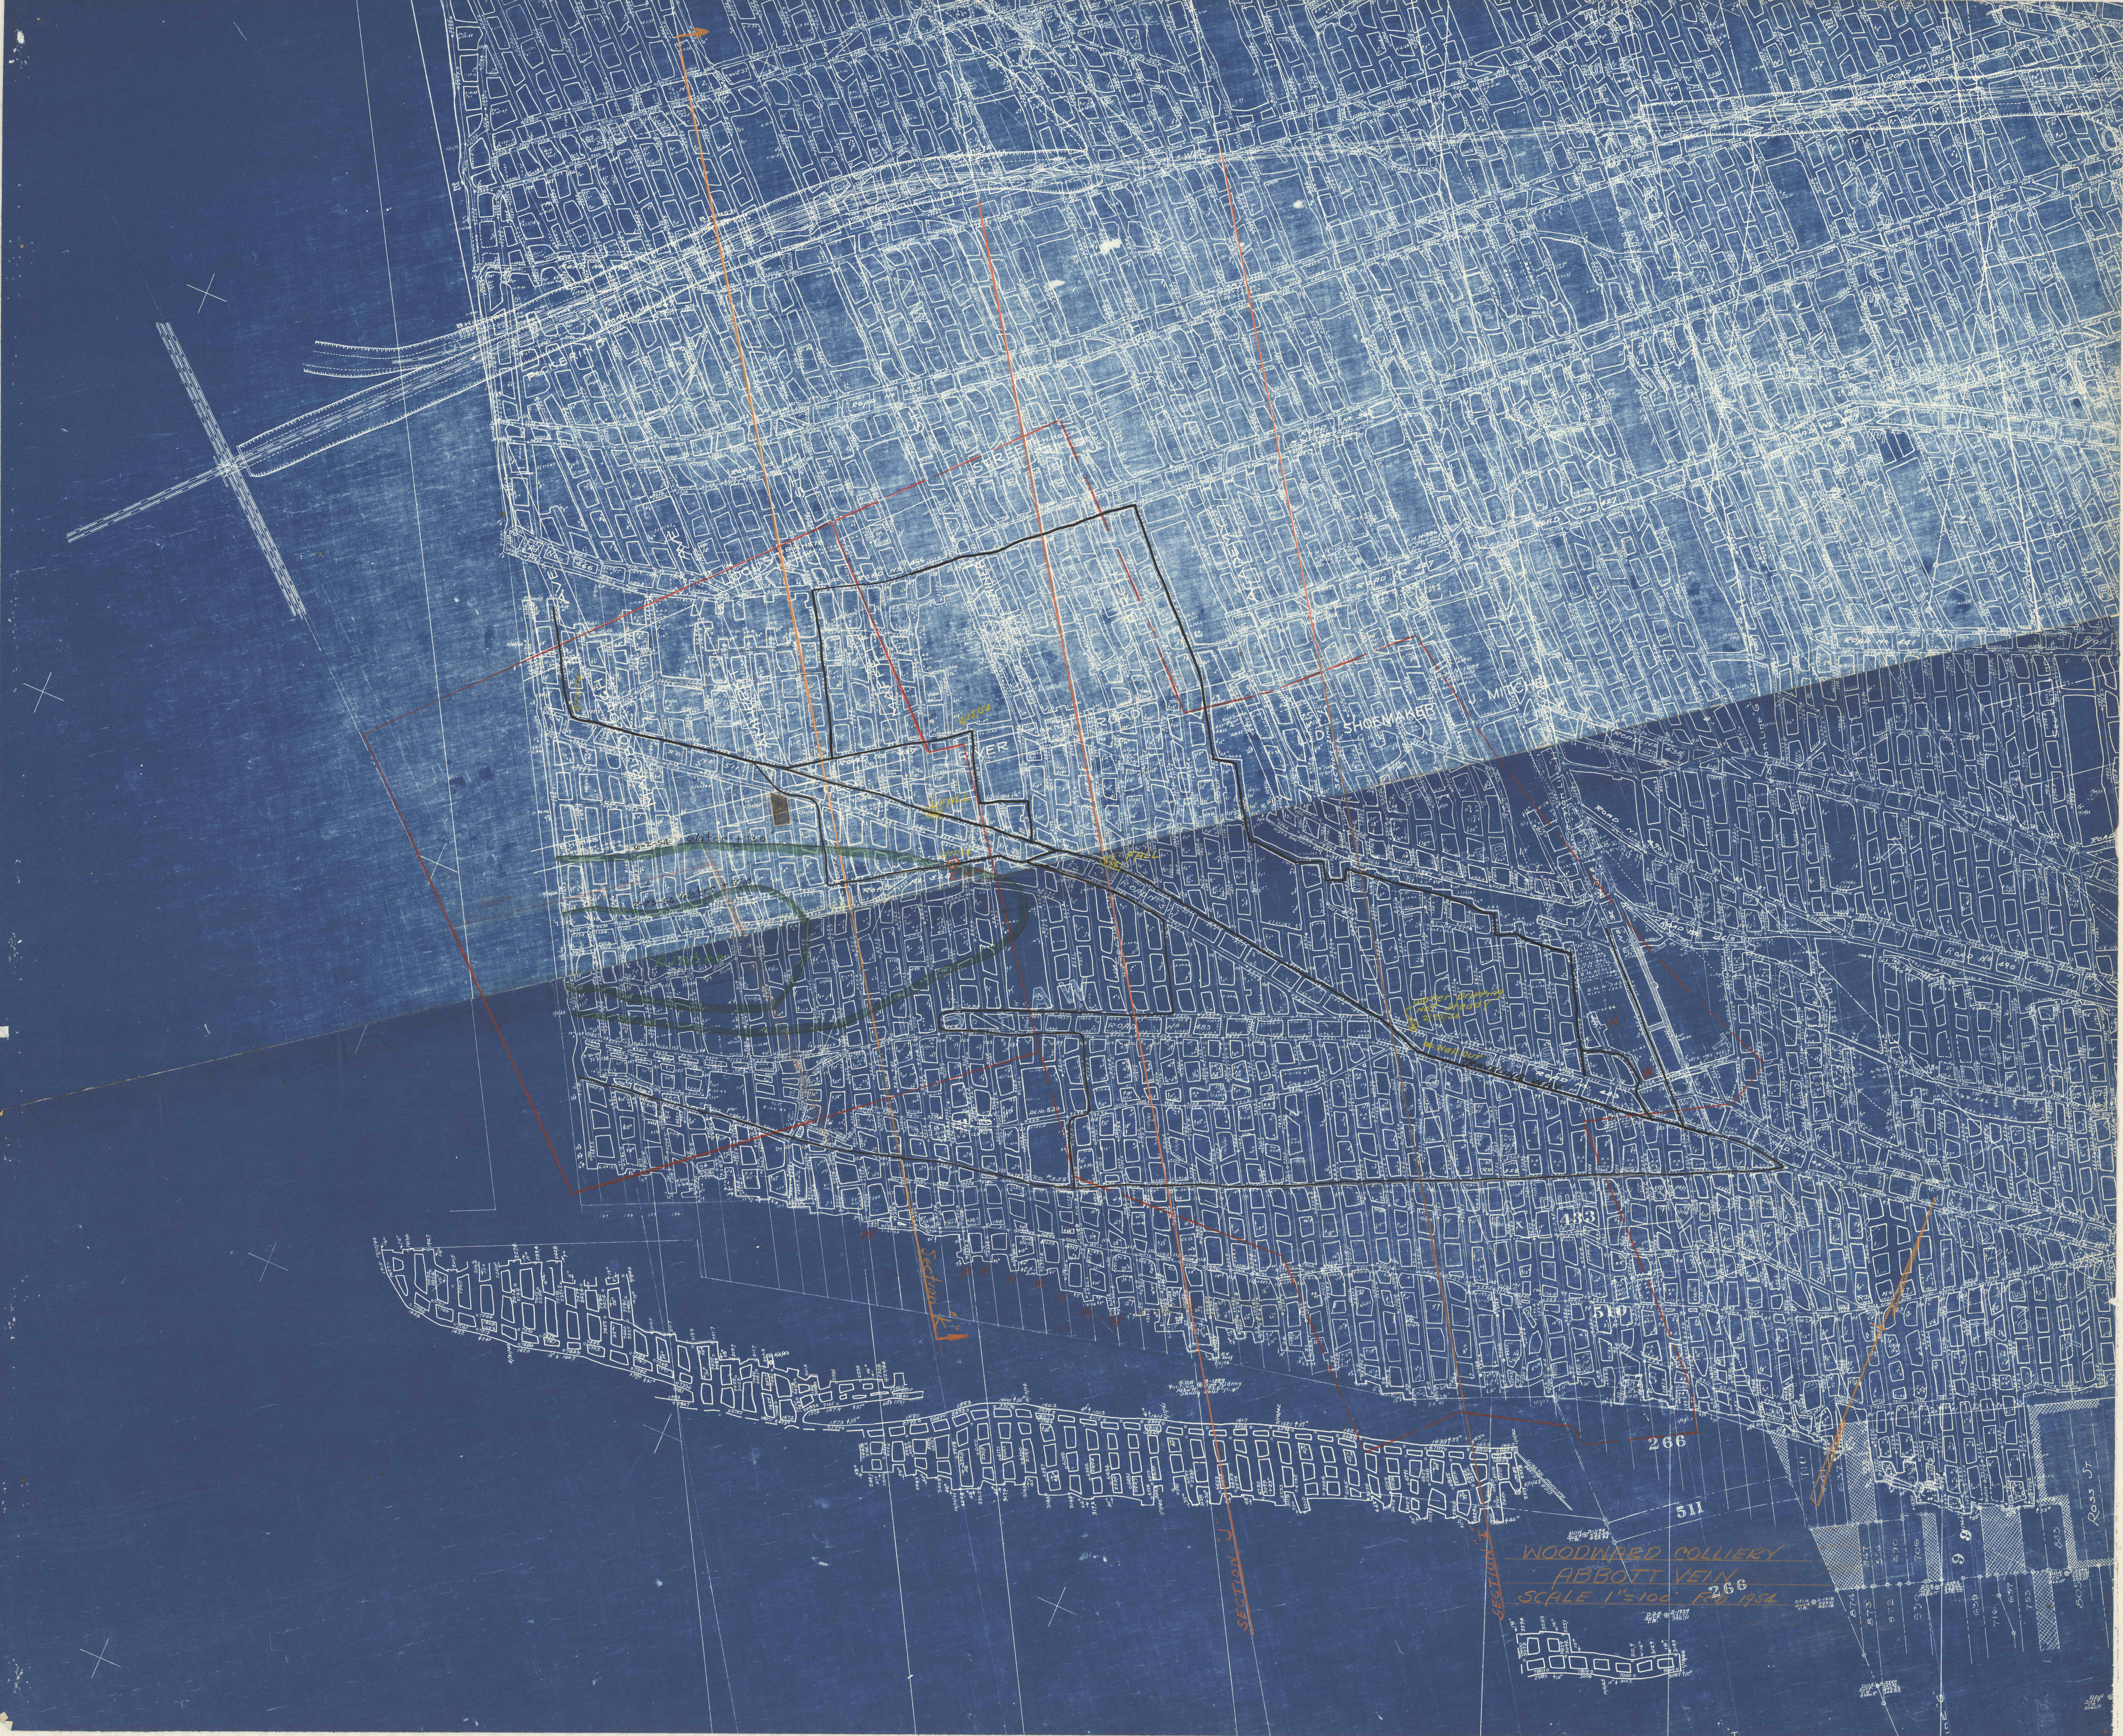
WEST
B.H. 57
B.H. 58
PICKERING
ROAD No 466
AVE
WARDELL
3/25/54
ROAD No 571
ROAD No 358
ROAD No 465
STREET
MAFFET
RIVER
ROAD
ACADEMY
ROAD No 427
D. SHOEMAKER
J. MITCHELL
ROAD No 389
ROAD No 421
ROAD No 438
ROAD No 490
ROAD No 463
2/25/54
FALL
6-2-54 Water +73.0
2-25-54 Water +57.0
Water
ROAD No 483
Rd. No 530
RD. #558
Water dripping Not steady 2/25/54
Wall out
TRAVELING WAY
ROAD No 400
Section "K"
SECTION "J"
SECTION "I"
433
510
266
511
9
Ross St
D.D.H. Abbott

WOODWARD COLLIERY
ABBOTT VEIN
SCALE 1"=100' Feb 1954